


JOHN A. BERKEBILE TR. 926
 MAURICE LOHR SURV.
 The Beasland White Coal Co. Coal

BESEBLE TR. 985 FOR IRON HAMMER
 NOW IRON HAMMER SOLD 30,000 LBS C-COAL TO
 JOSEPH VALENT JR. AND JOHN VALENT NO SURFACE

SHARES BERKEBILE TR. 985 FOR IRON HAMMER
 JAMES E. BERKEBILE
 The Beasland White Coal Co. Coal

HENRY HEINEMEYER TR. 937
 WILLIAM MILL SURV.
 The Beasland White Coal Co. Coal

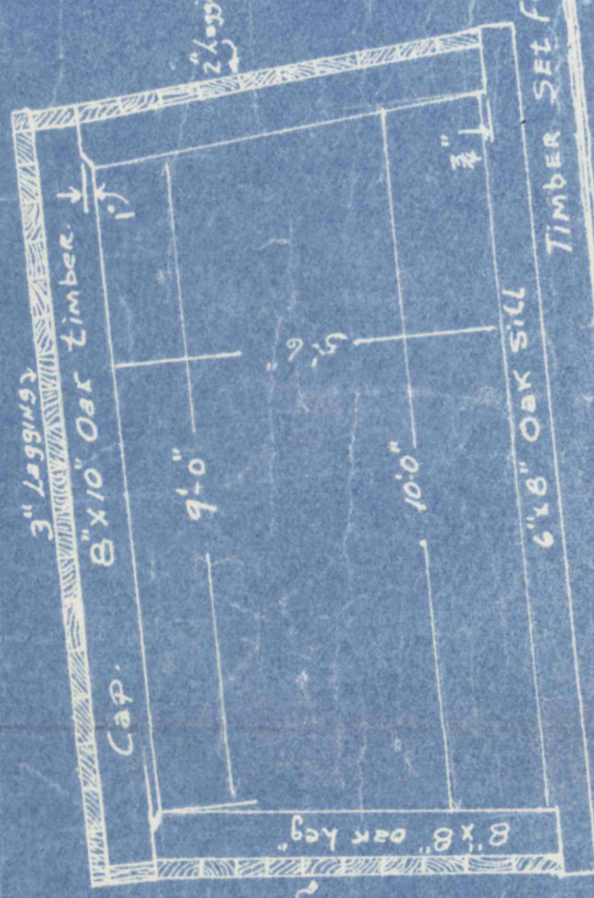

RECORDED MINING PLAN N-30-68 TO 6-30-69

MAP
 VALENT-MINE
 SOMERSET COUNTY PA-SHADE TOWNSHIP
 VALENT COAL CO. C-COAL SCALE 1"=100'

M. E. TRIMMEL ENGR. No. 16,323-57

Surveyed 12-10-08

Drifts on outcrop surveyed

FIELD COPY

