

PROJECTION OF THE


UPPER VEIN SEVENTH POOL COAL CO.

SITUATE IN
MONONGAHELA TOWNSHIP, GREENE CO., PA.

SCALE: 1" = 100' MAY 14, 1919.

Loyette Engineering Co., Uniontown, Pa.

DATE OF SURVEY.

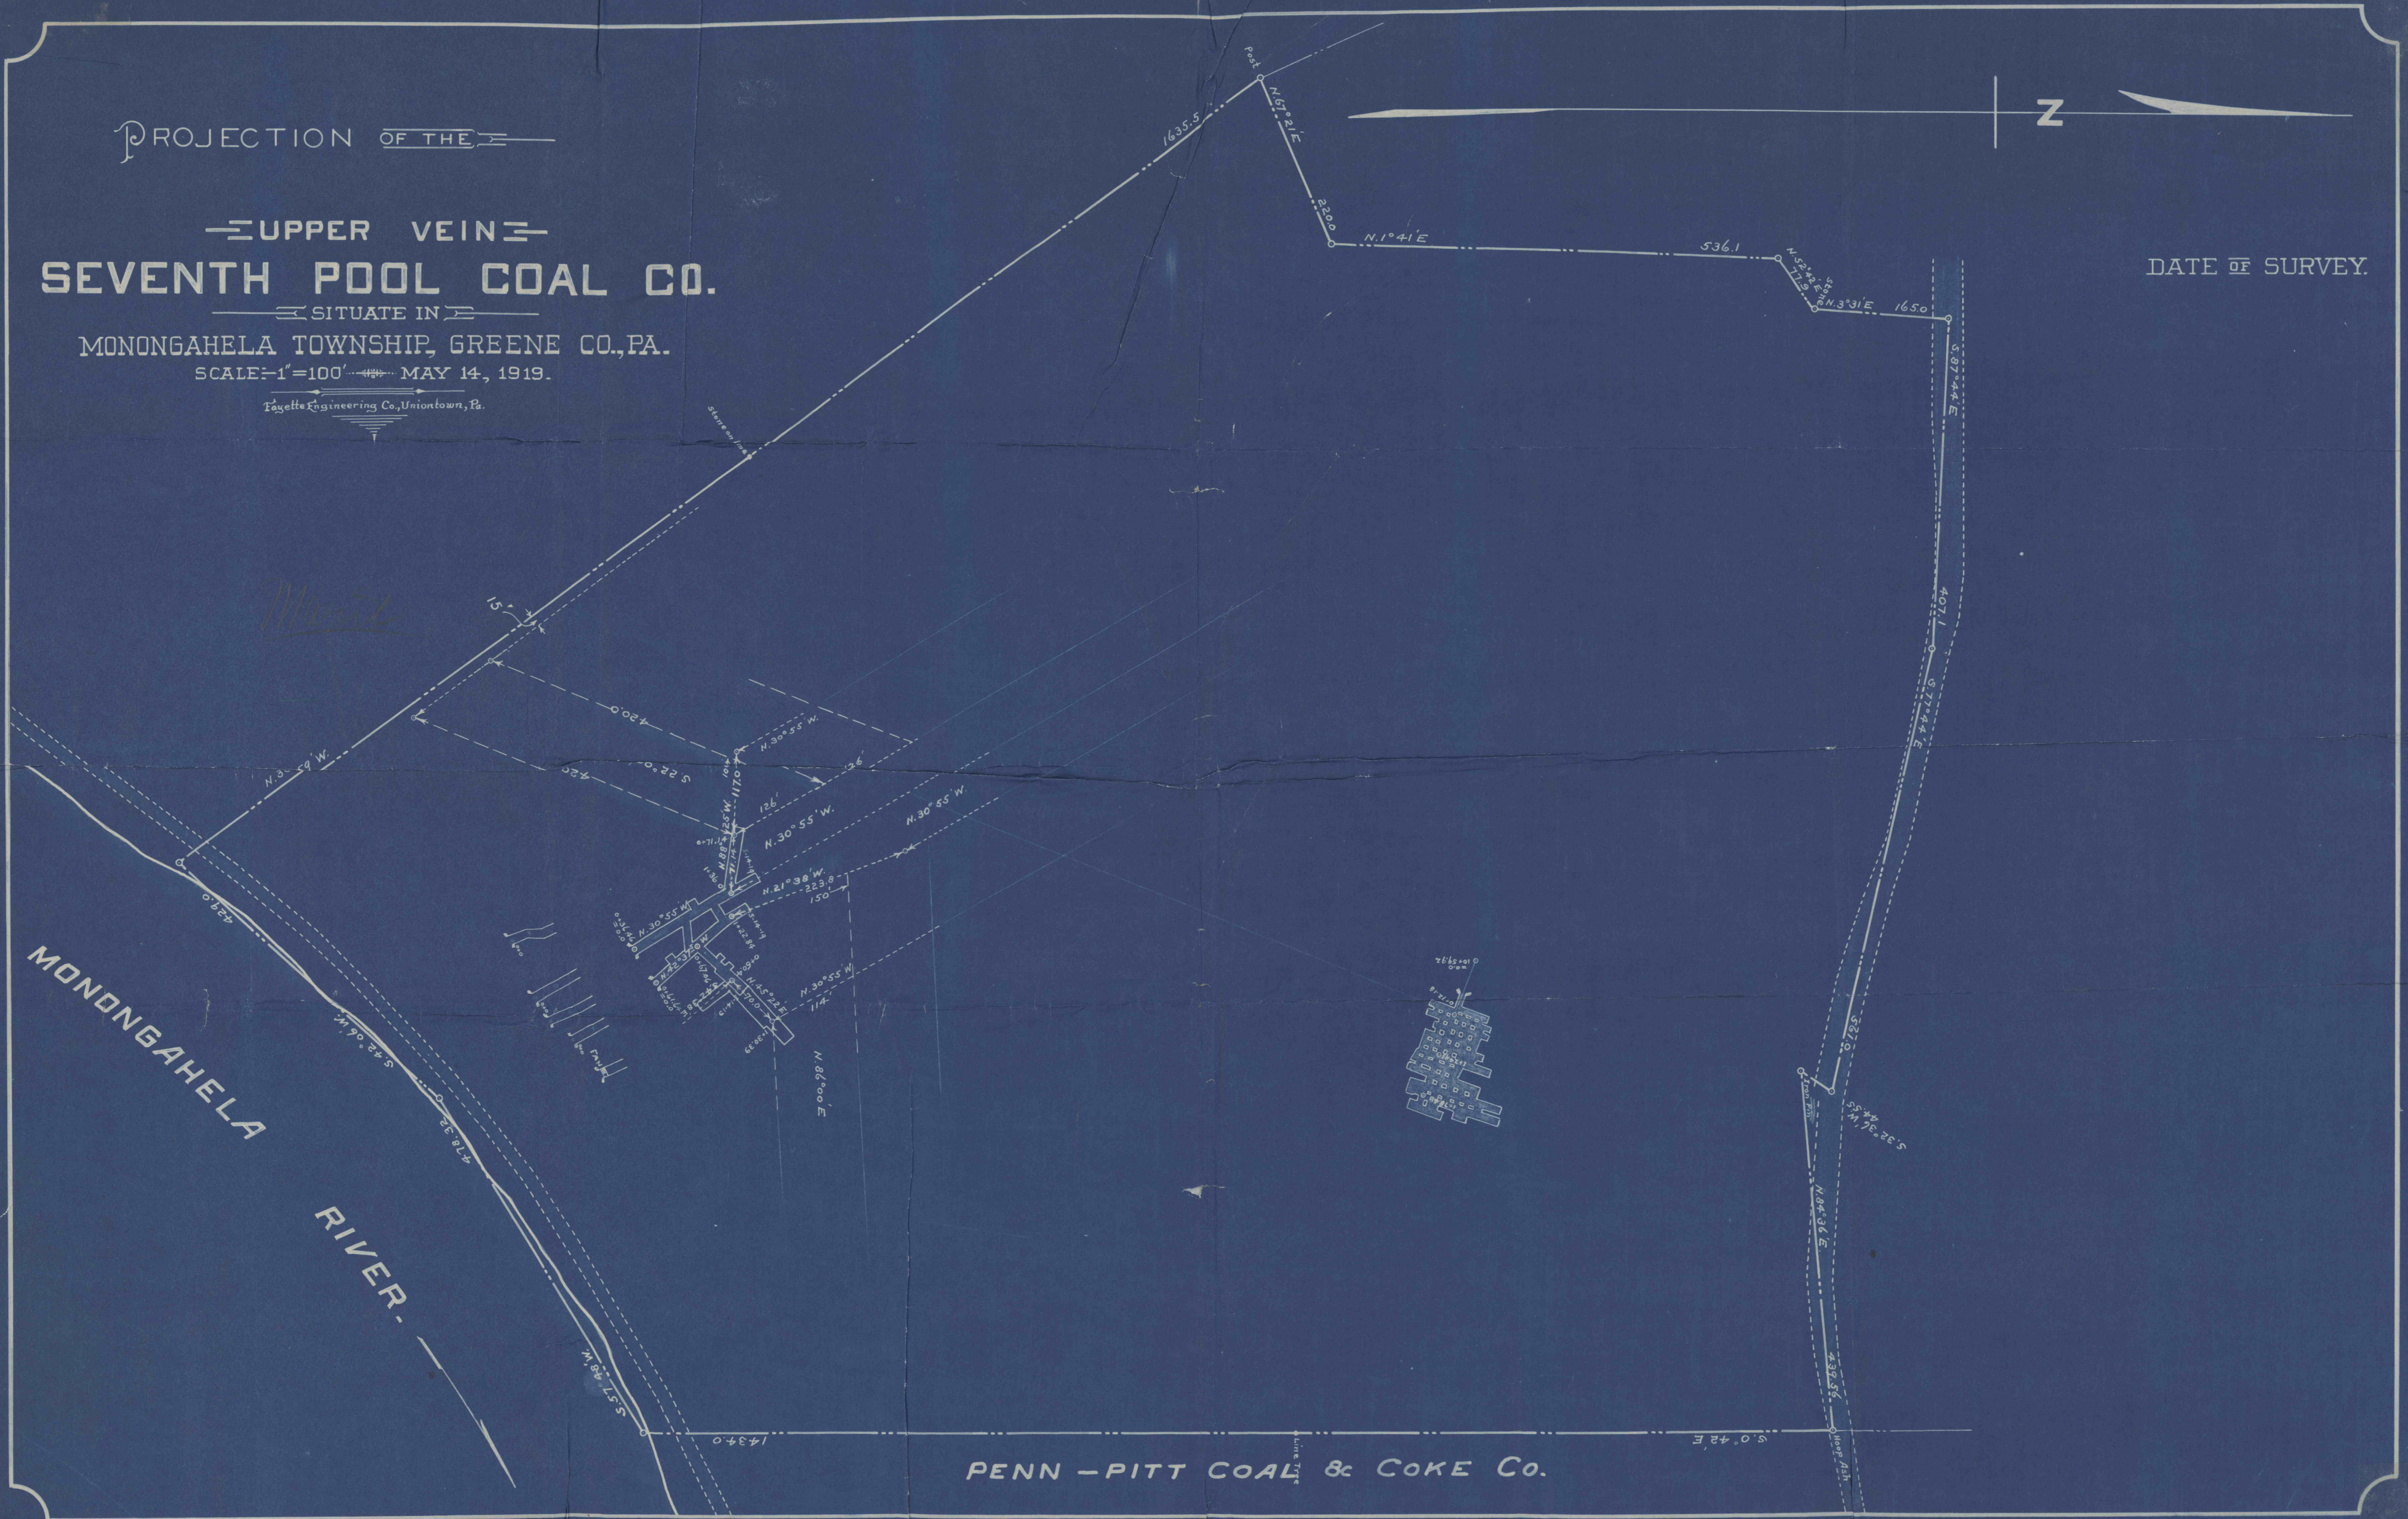

PENN - PITT COAL & COKE CO.