


WORK DONE UP TO JUNE 1905

JULY	[Symbol]
AUGUST	[Symbol]
OCTOBER	[Symbol]
Jan. 1906	[Symbol]
Sept. 1906	[Symbol]
Sept. 1907	[Symbol]
April 1908	[Symbol]
Dec. 1908	[Symbol]
July 1909	[Symbol]
Dec. 1909	[Symbol]
up to DEC 1912	[Symbol]
JULY 1913	[Symbol]

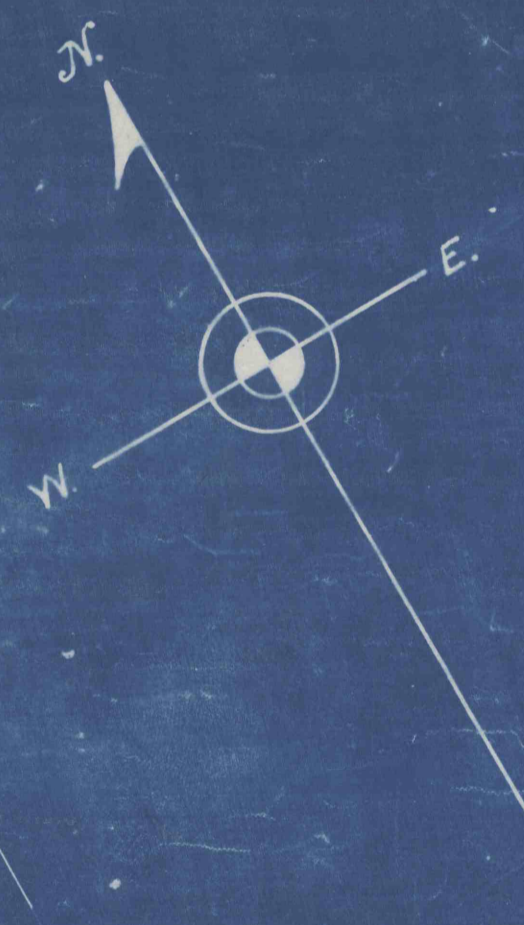

Map of Coal Lands  
 SURVEYED FOR,  
**Y.B. SKELLEY**  
 EXPORT, WESTMORELAND CO. PA.  
 Scale 1"=100'      Pittsburg Pa. Feb. 1901  
 S.A. Taylor C.E.



A. HAMILTON  
 CIVIL ENGINEER