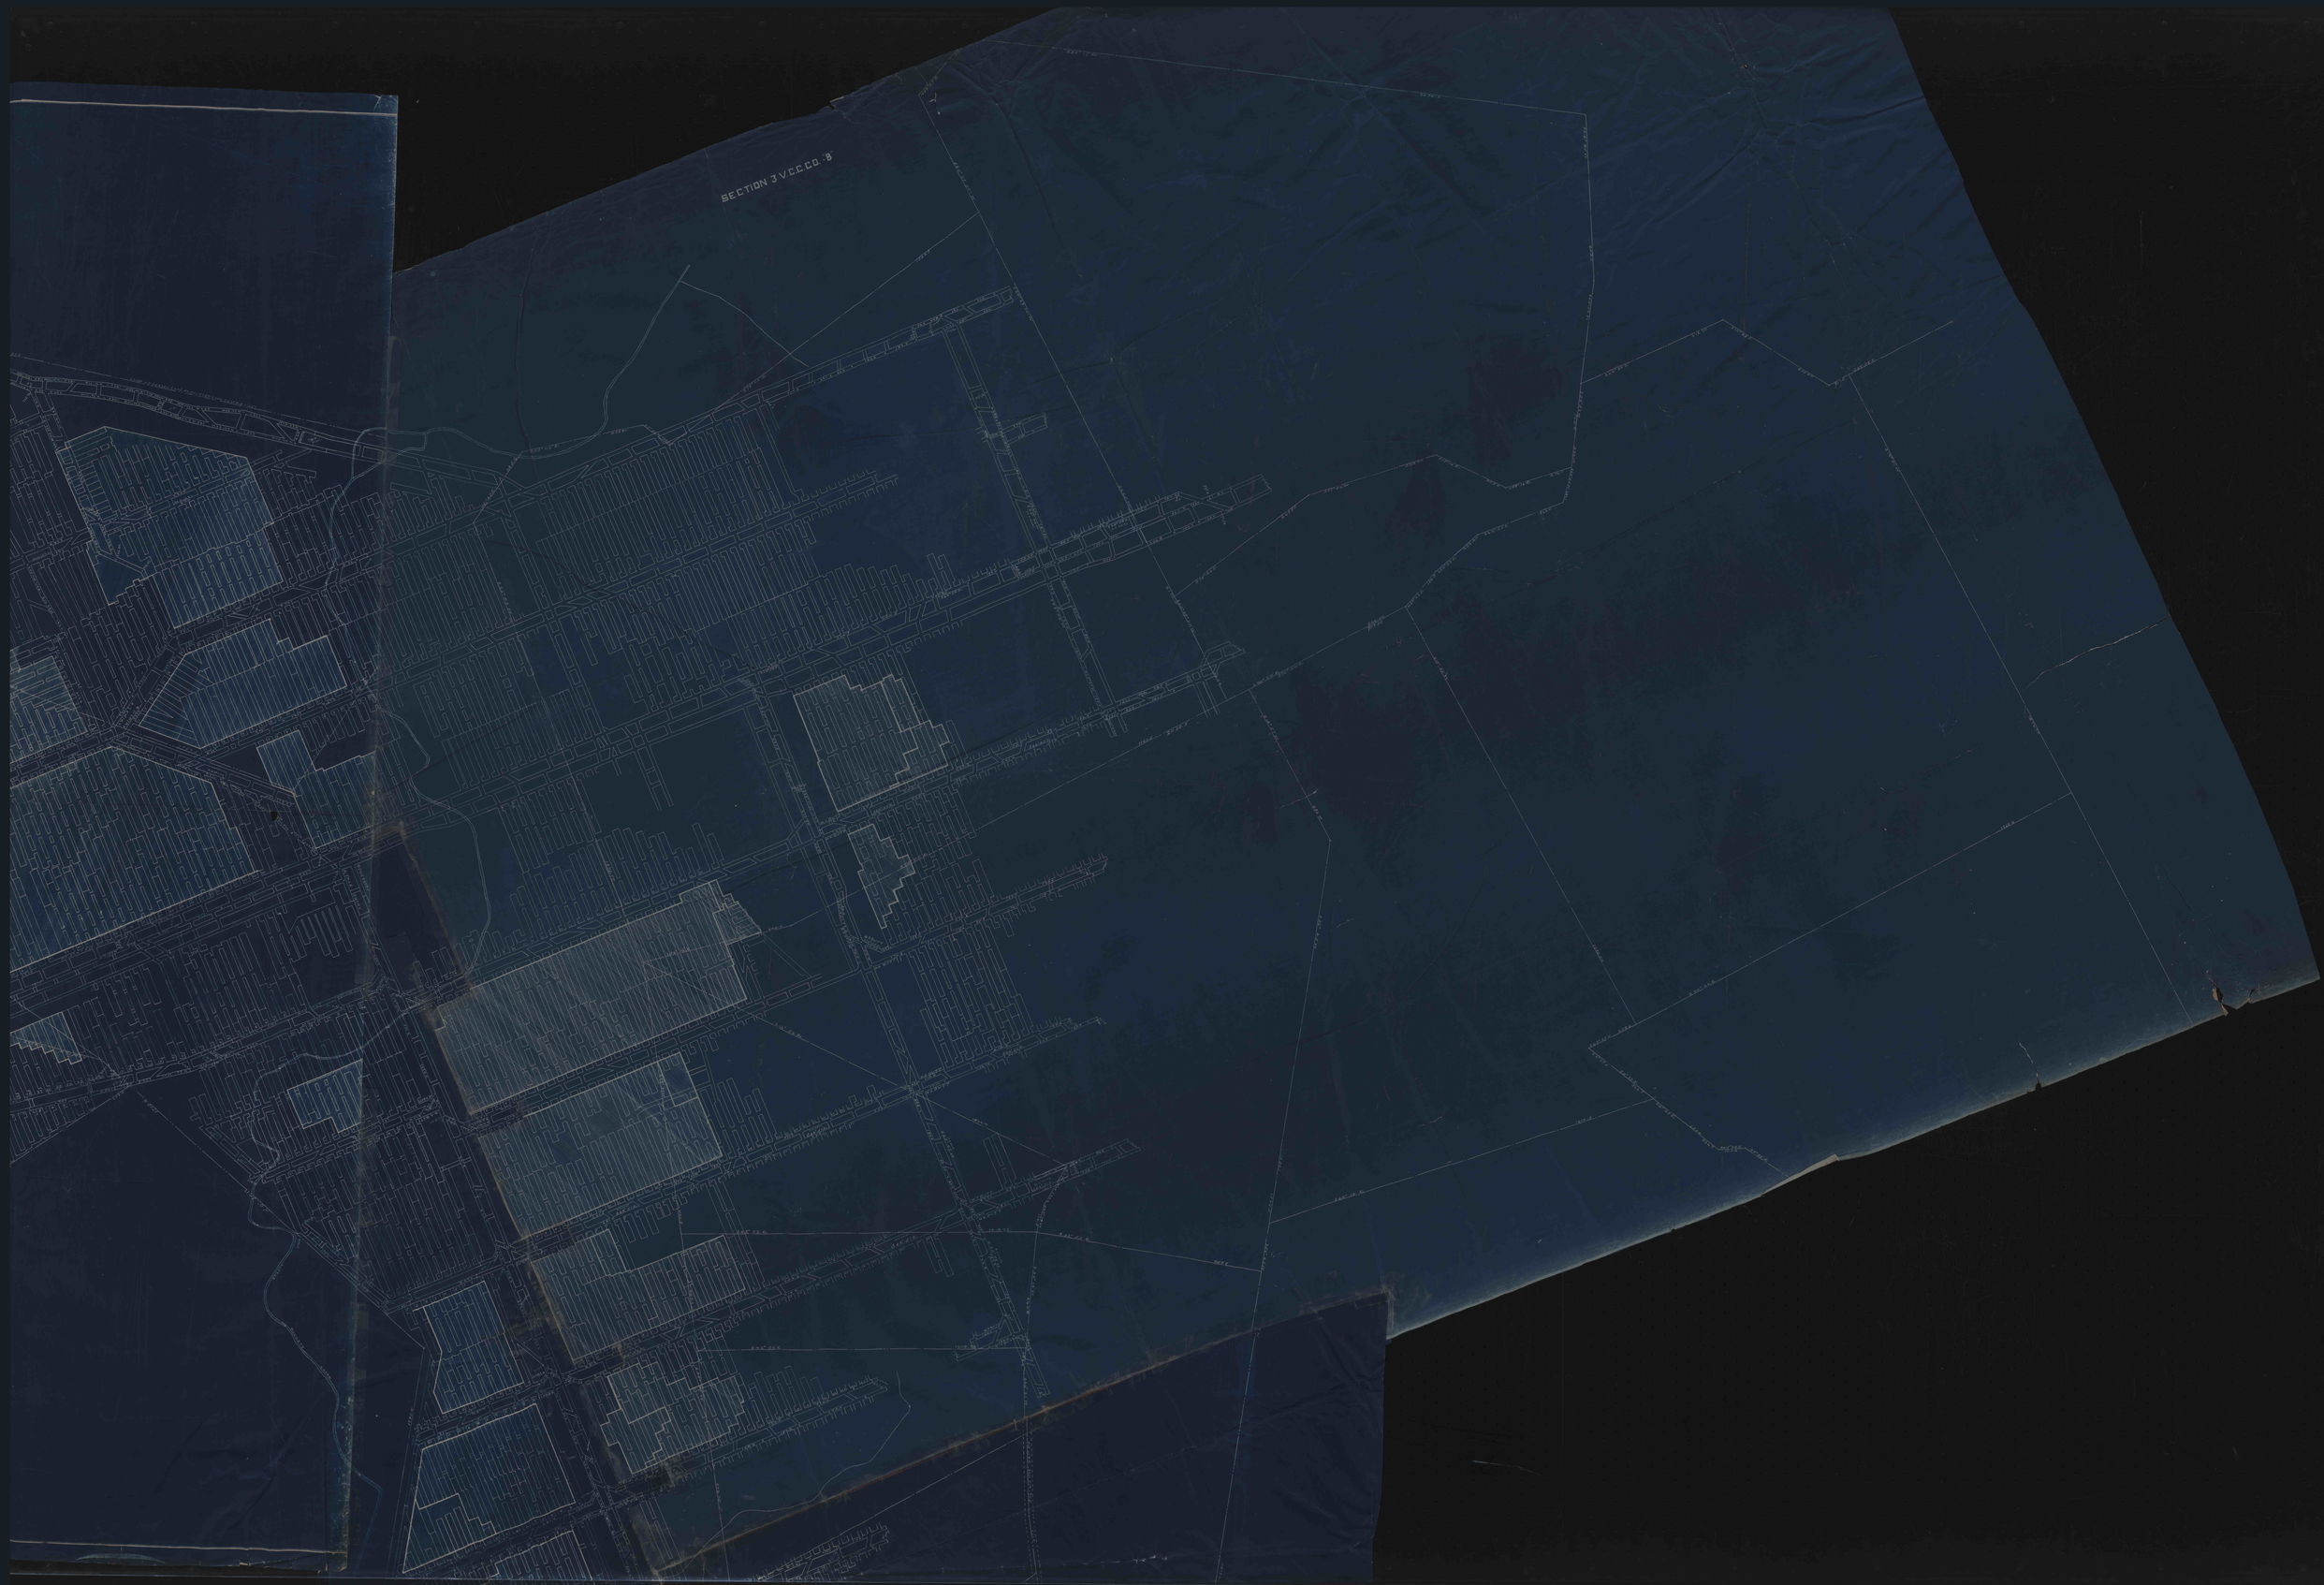
SECTION 3 V.C.C.CO. 3