


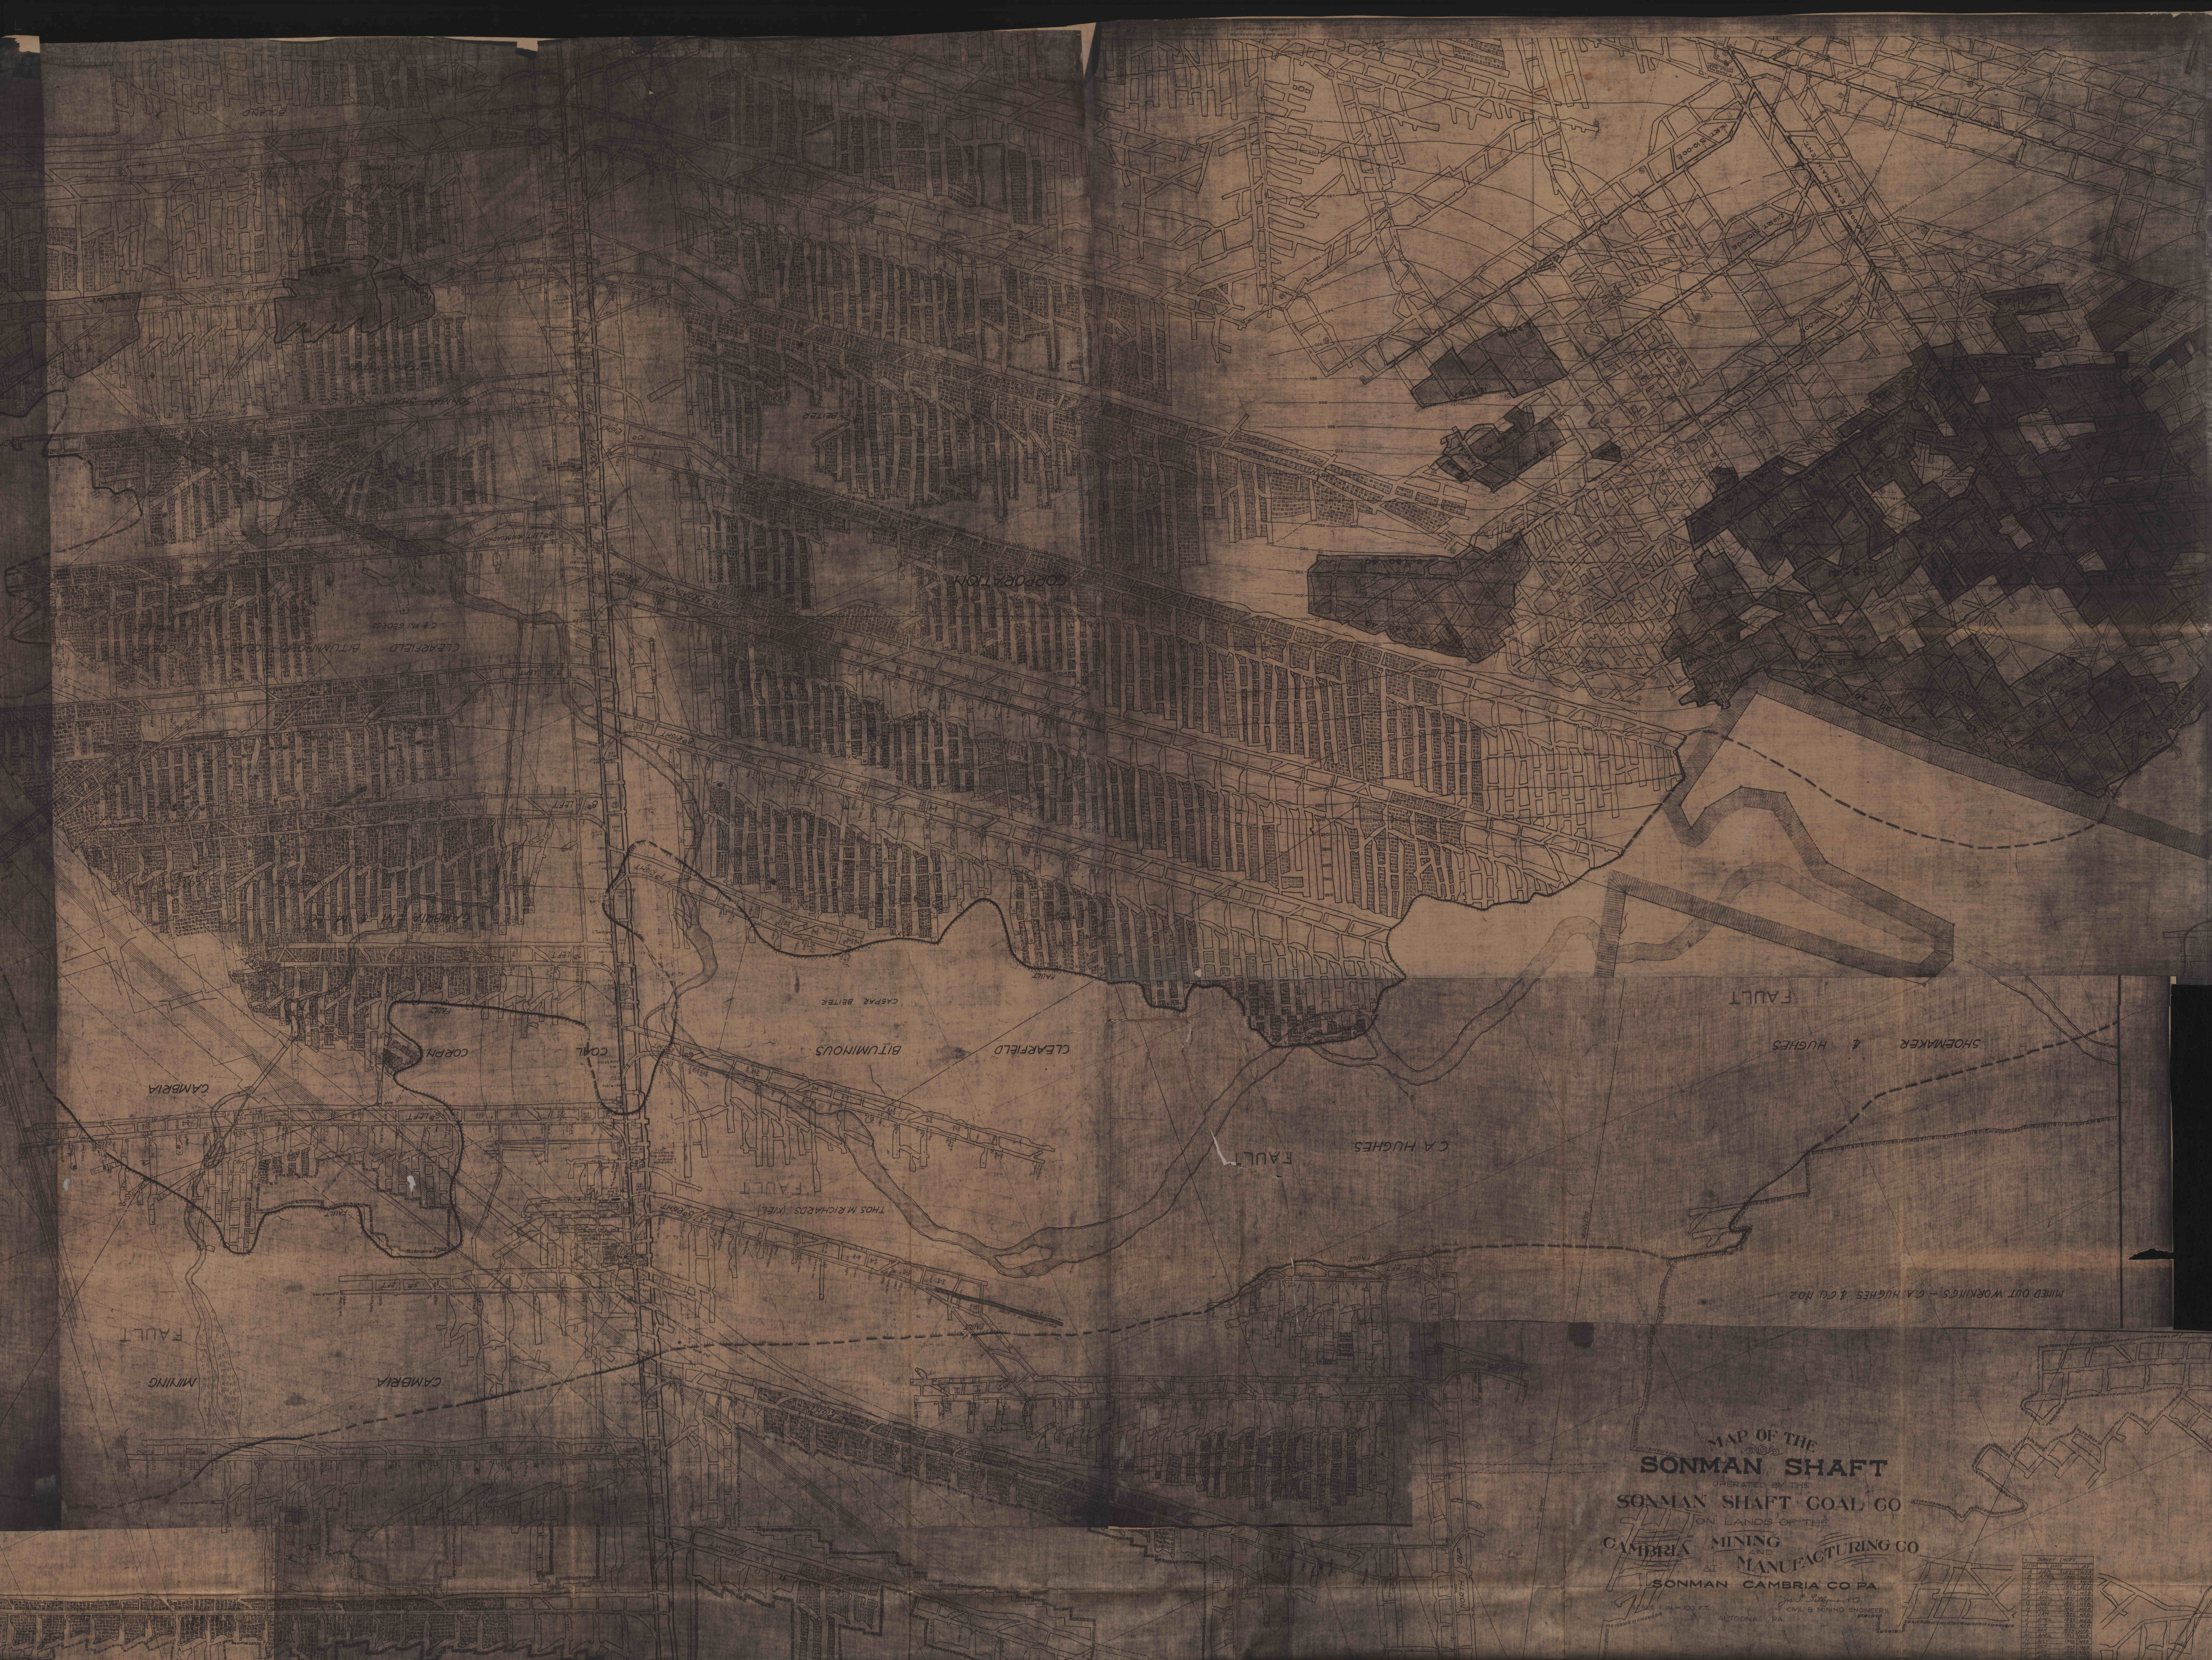

MAP OF THE
SONMAN SHAFT
OPERATED BY THE
SONMAN SHAFT COAL CO
ON LANDS OF THE
CAMBRIA MINING AND MANUFACTURING CO
AT SONMAN, CAMBRIA CO PA

