


**SOUDAN MINE  
YOUGHIOGHENY - PITTSBURGH COAL CO.  
VAN VOORHIS PENNA.**

SCALE 1-100-

AUG. 1915-

ANDREWS & SOUTHWARD ENGINEERS  
CURRY BLDG. PITTSBURGH

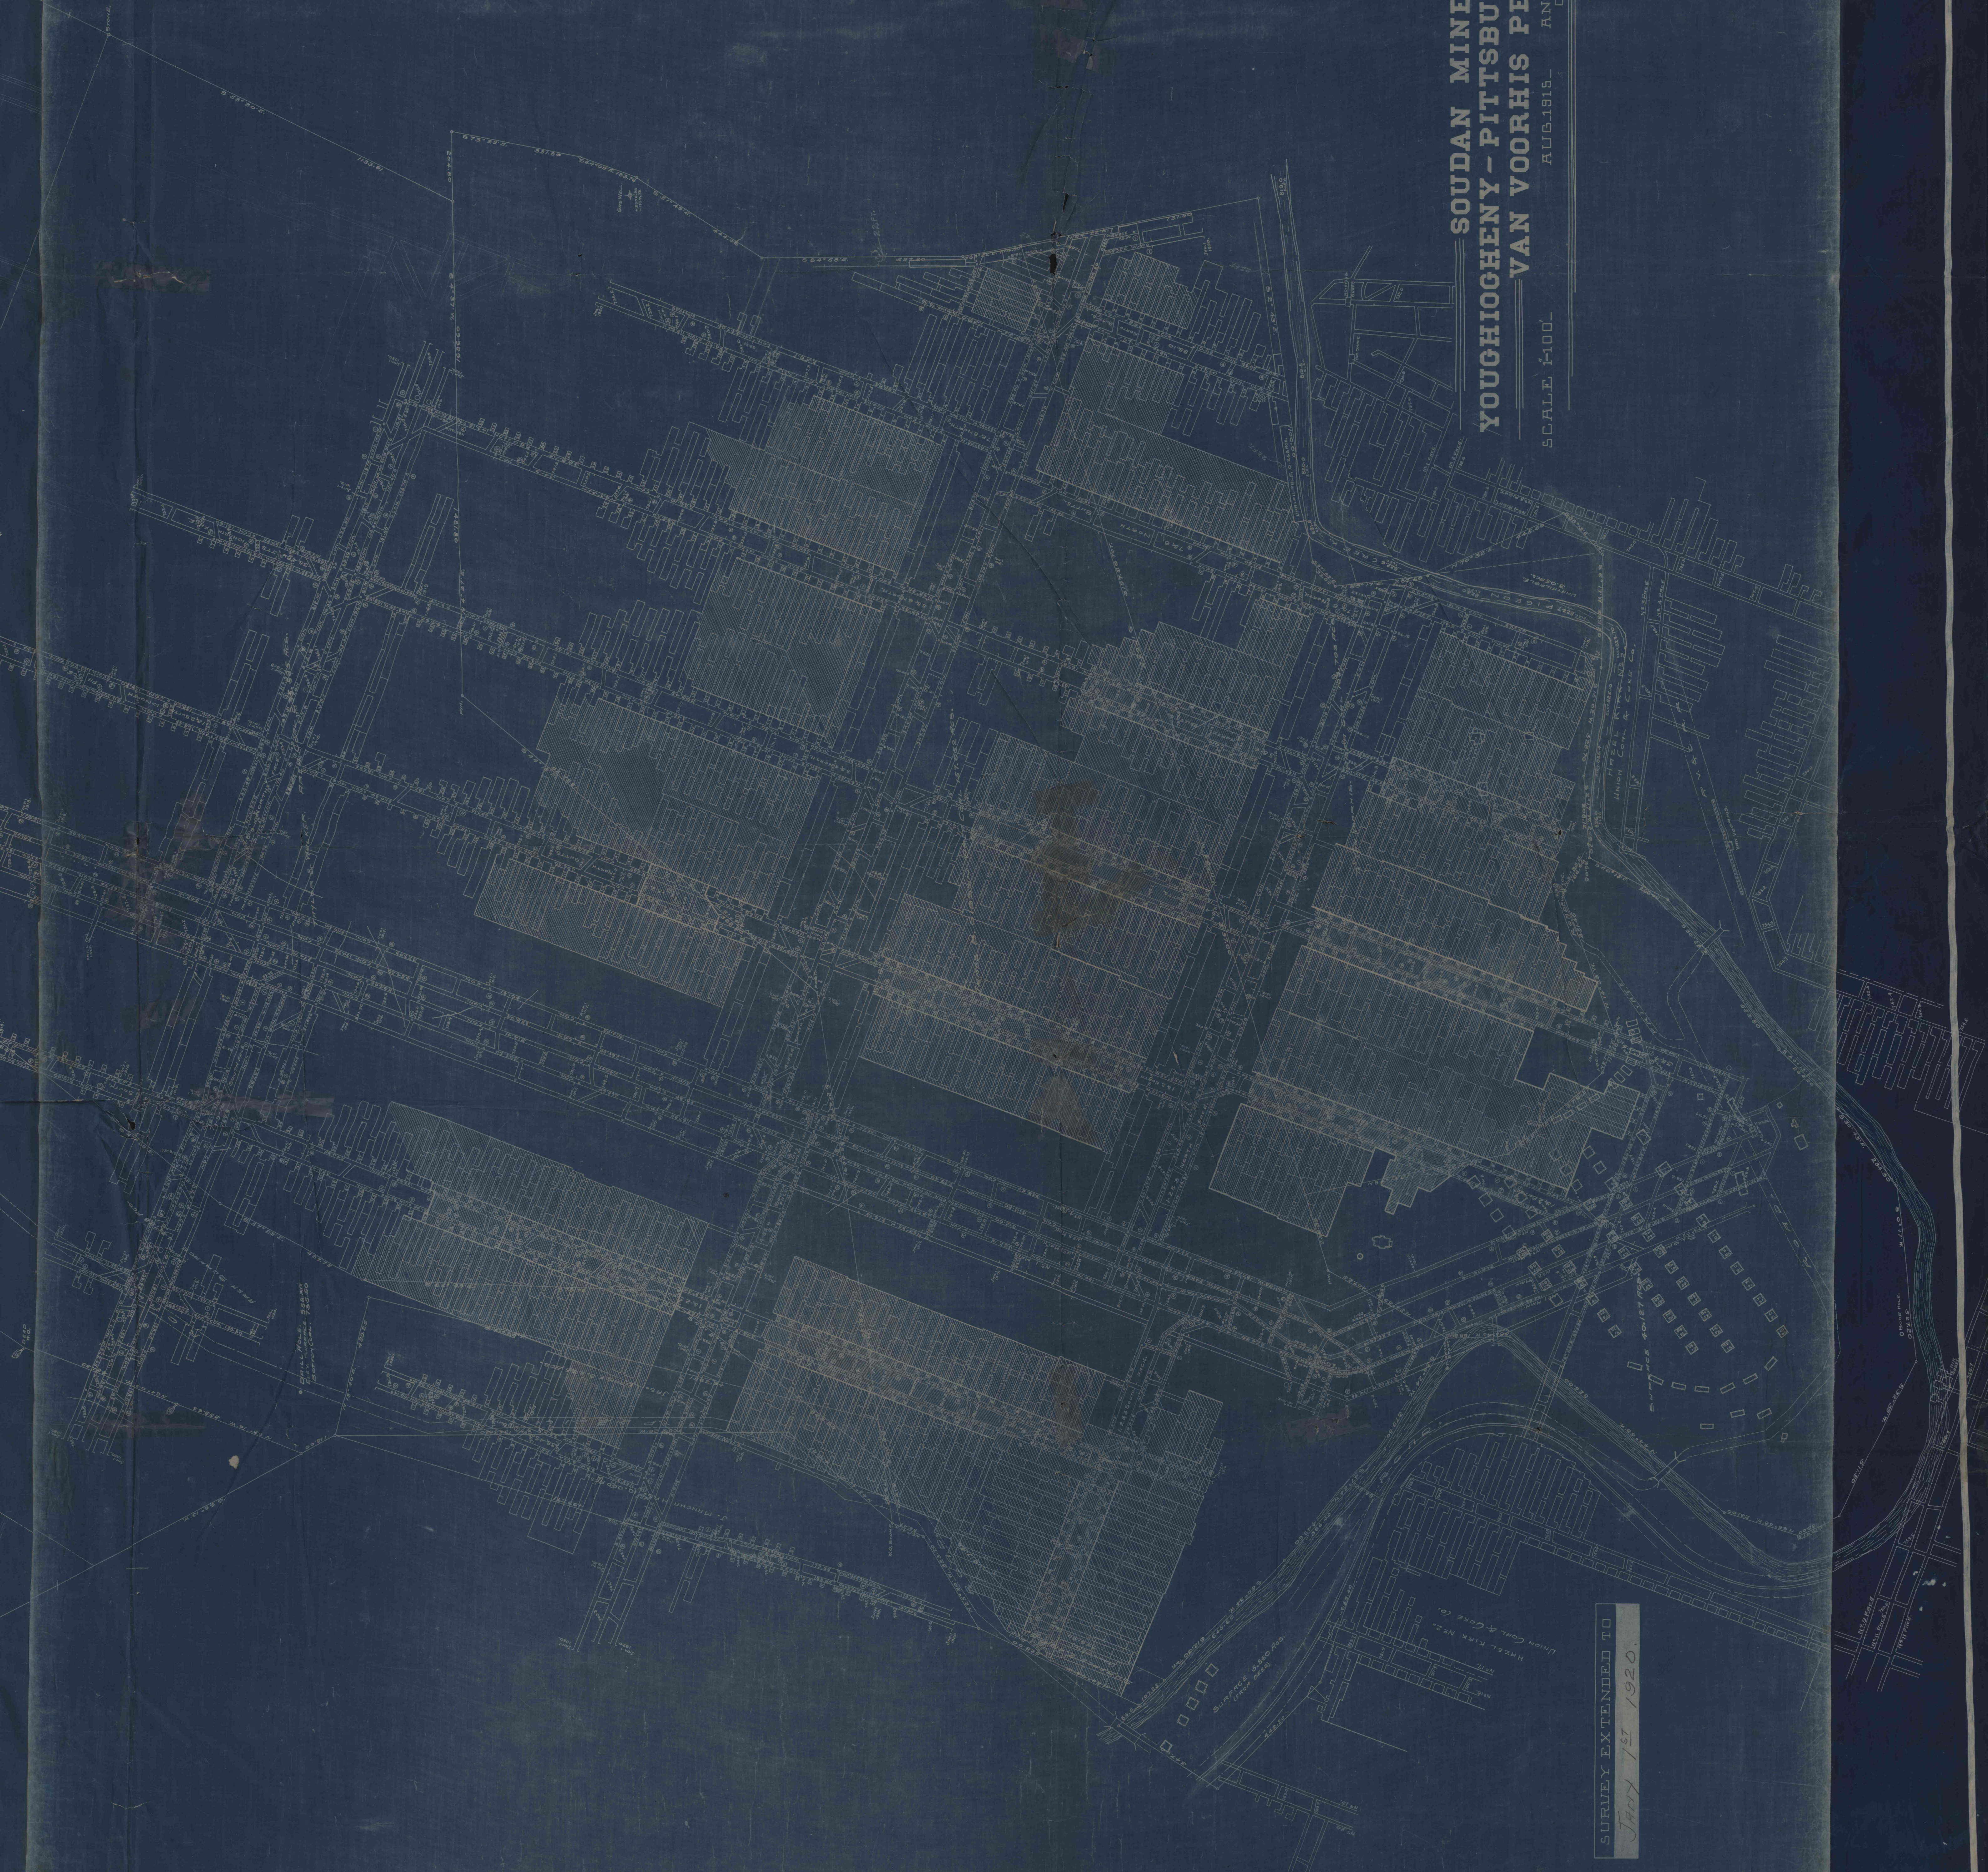

SURVEY EXTENDED TO  
JANUARY 1920.