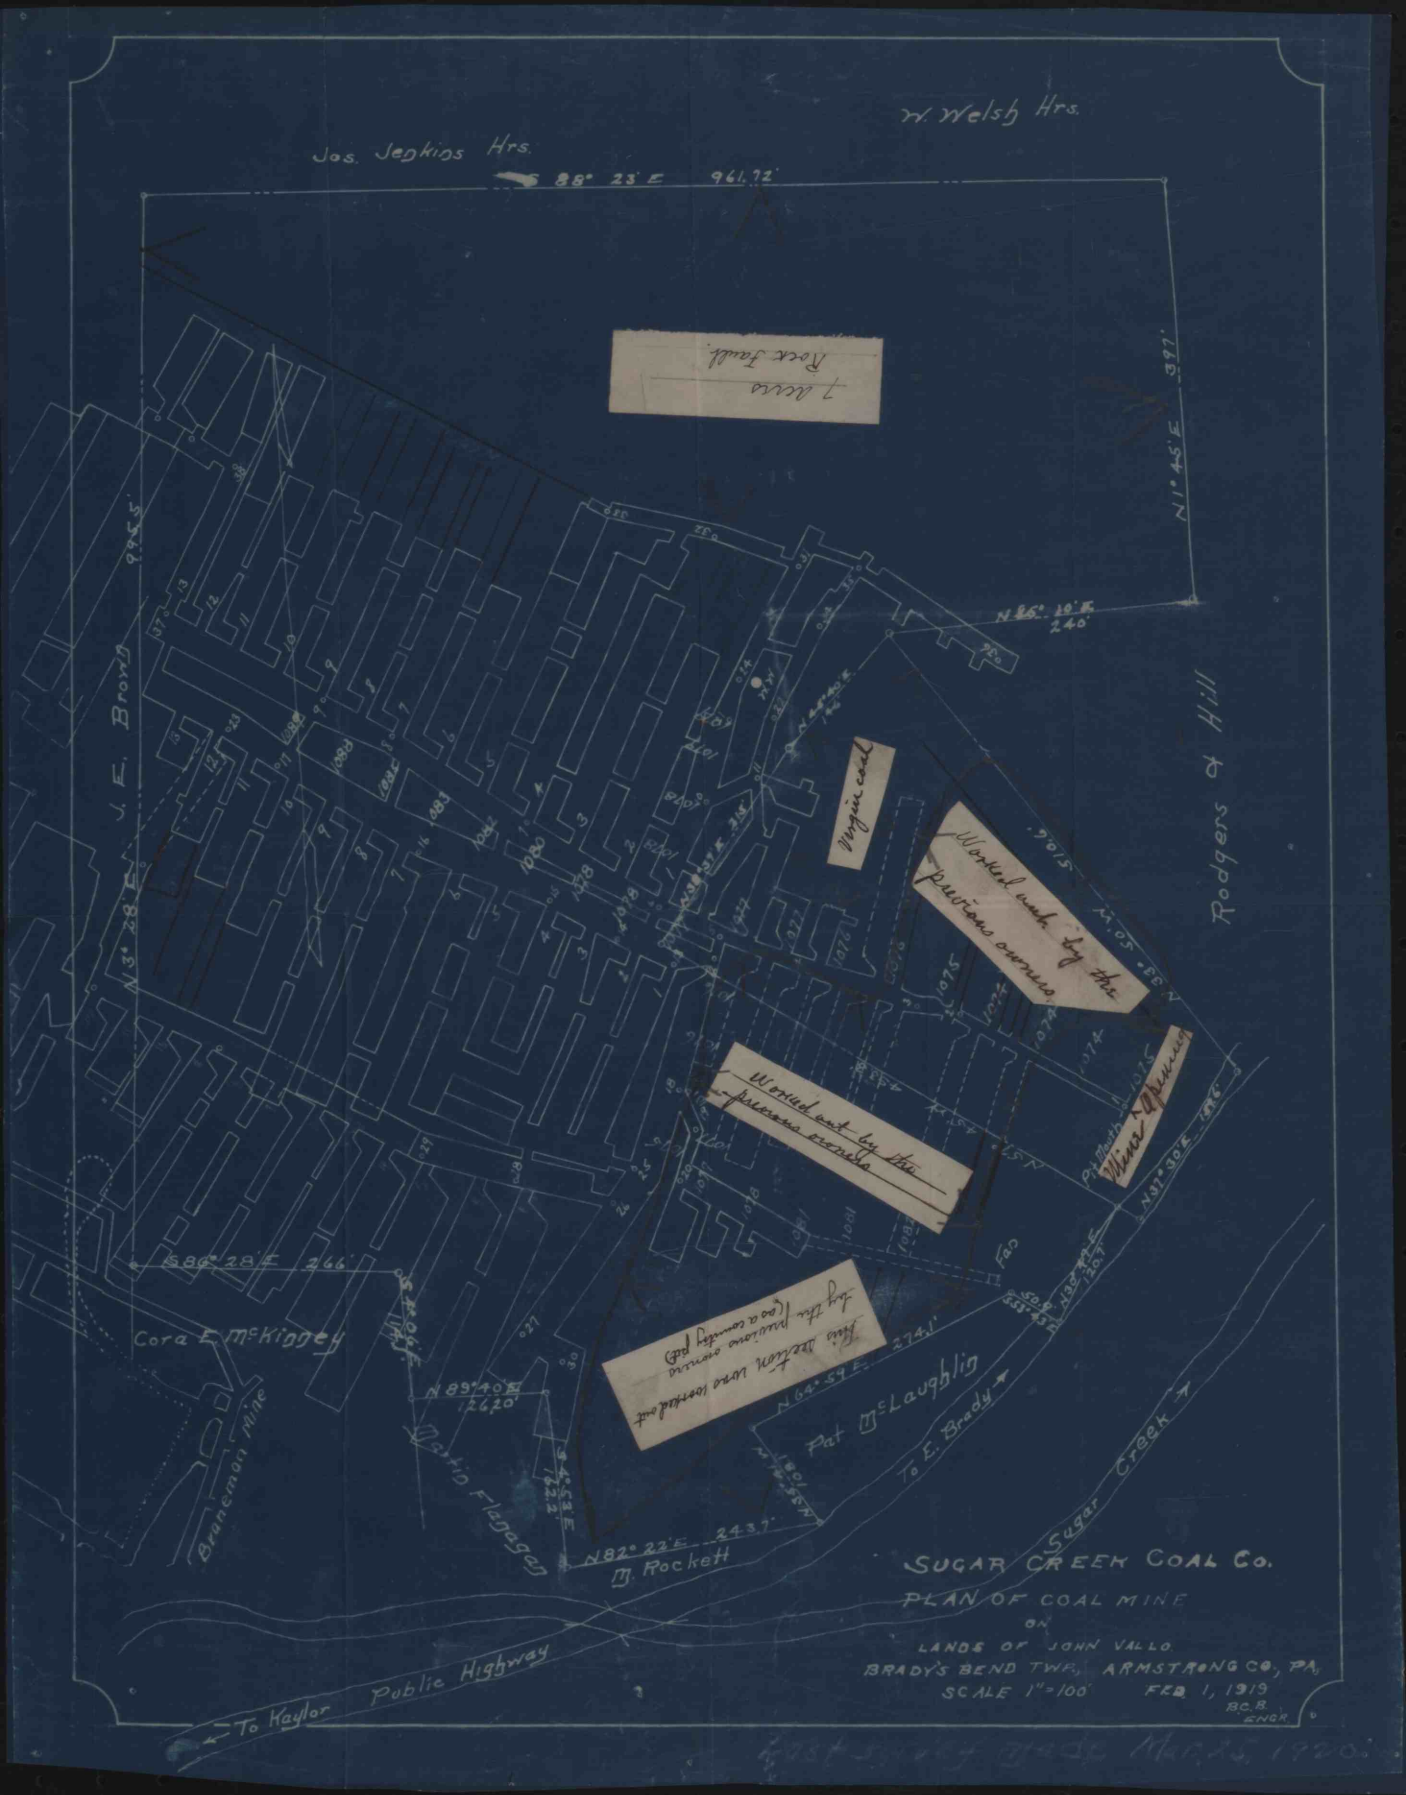
W. Welsh Hrs.
Jas. Jenkins Hrs.
S 88° 23' E 961.72'
7 acres
Rock Fault
N 1° 45' E 397'
N 85° 10' E 240'
Rodgers & Hill
J. E. Brown
995.5'
N 3° 28' E
Virgin coal
Worked out by the previous owners
Worked out by the previous owners
Wine Opening
Pit Mouth
N 37° 30' E 159.6'
Fan
S 86° 28' E 266'
Cora E. McKinney
Braneman Mine
N 89° 40' E 126.20'
Martin Flanagan
N 82° 22' E 243.7'
M. Rockett
N 64° 59' E 274.1'
Pat McLaughlin
To E. Brady
Sugar Creek
To Kaylor
Public Highway
SUGAR CREEK COAL Co.
PLAN OF COAL MINE
ON
LANDS OF JOHN VALLO
BRADY'S BEND TWP., ARMSTRONG CO., PA.
SCALE 1"=100'
FEB 1, 1919
B.C.B.
ENGR.