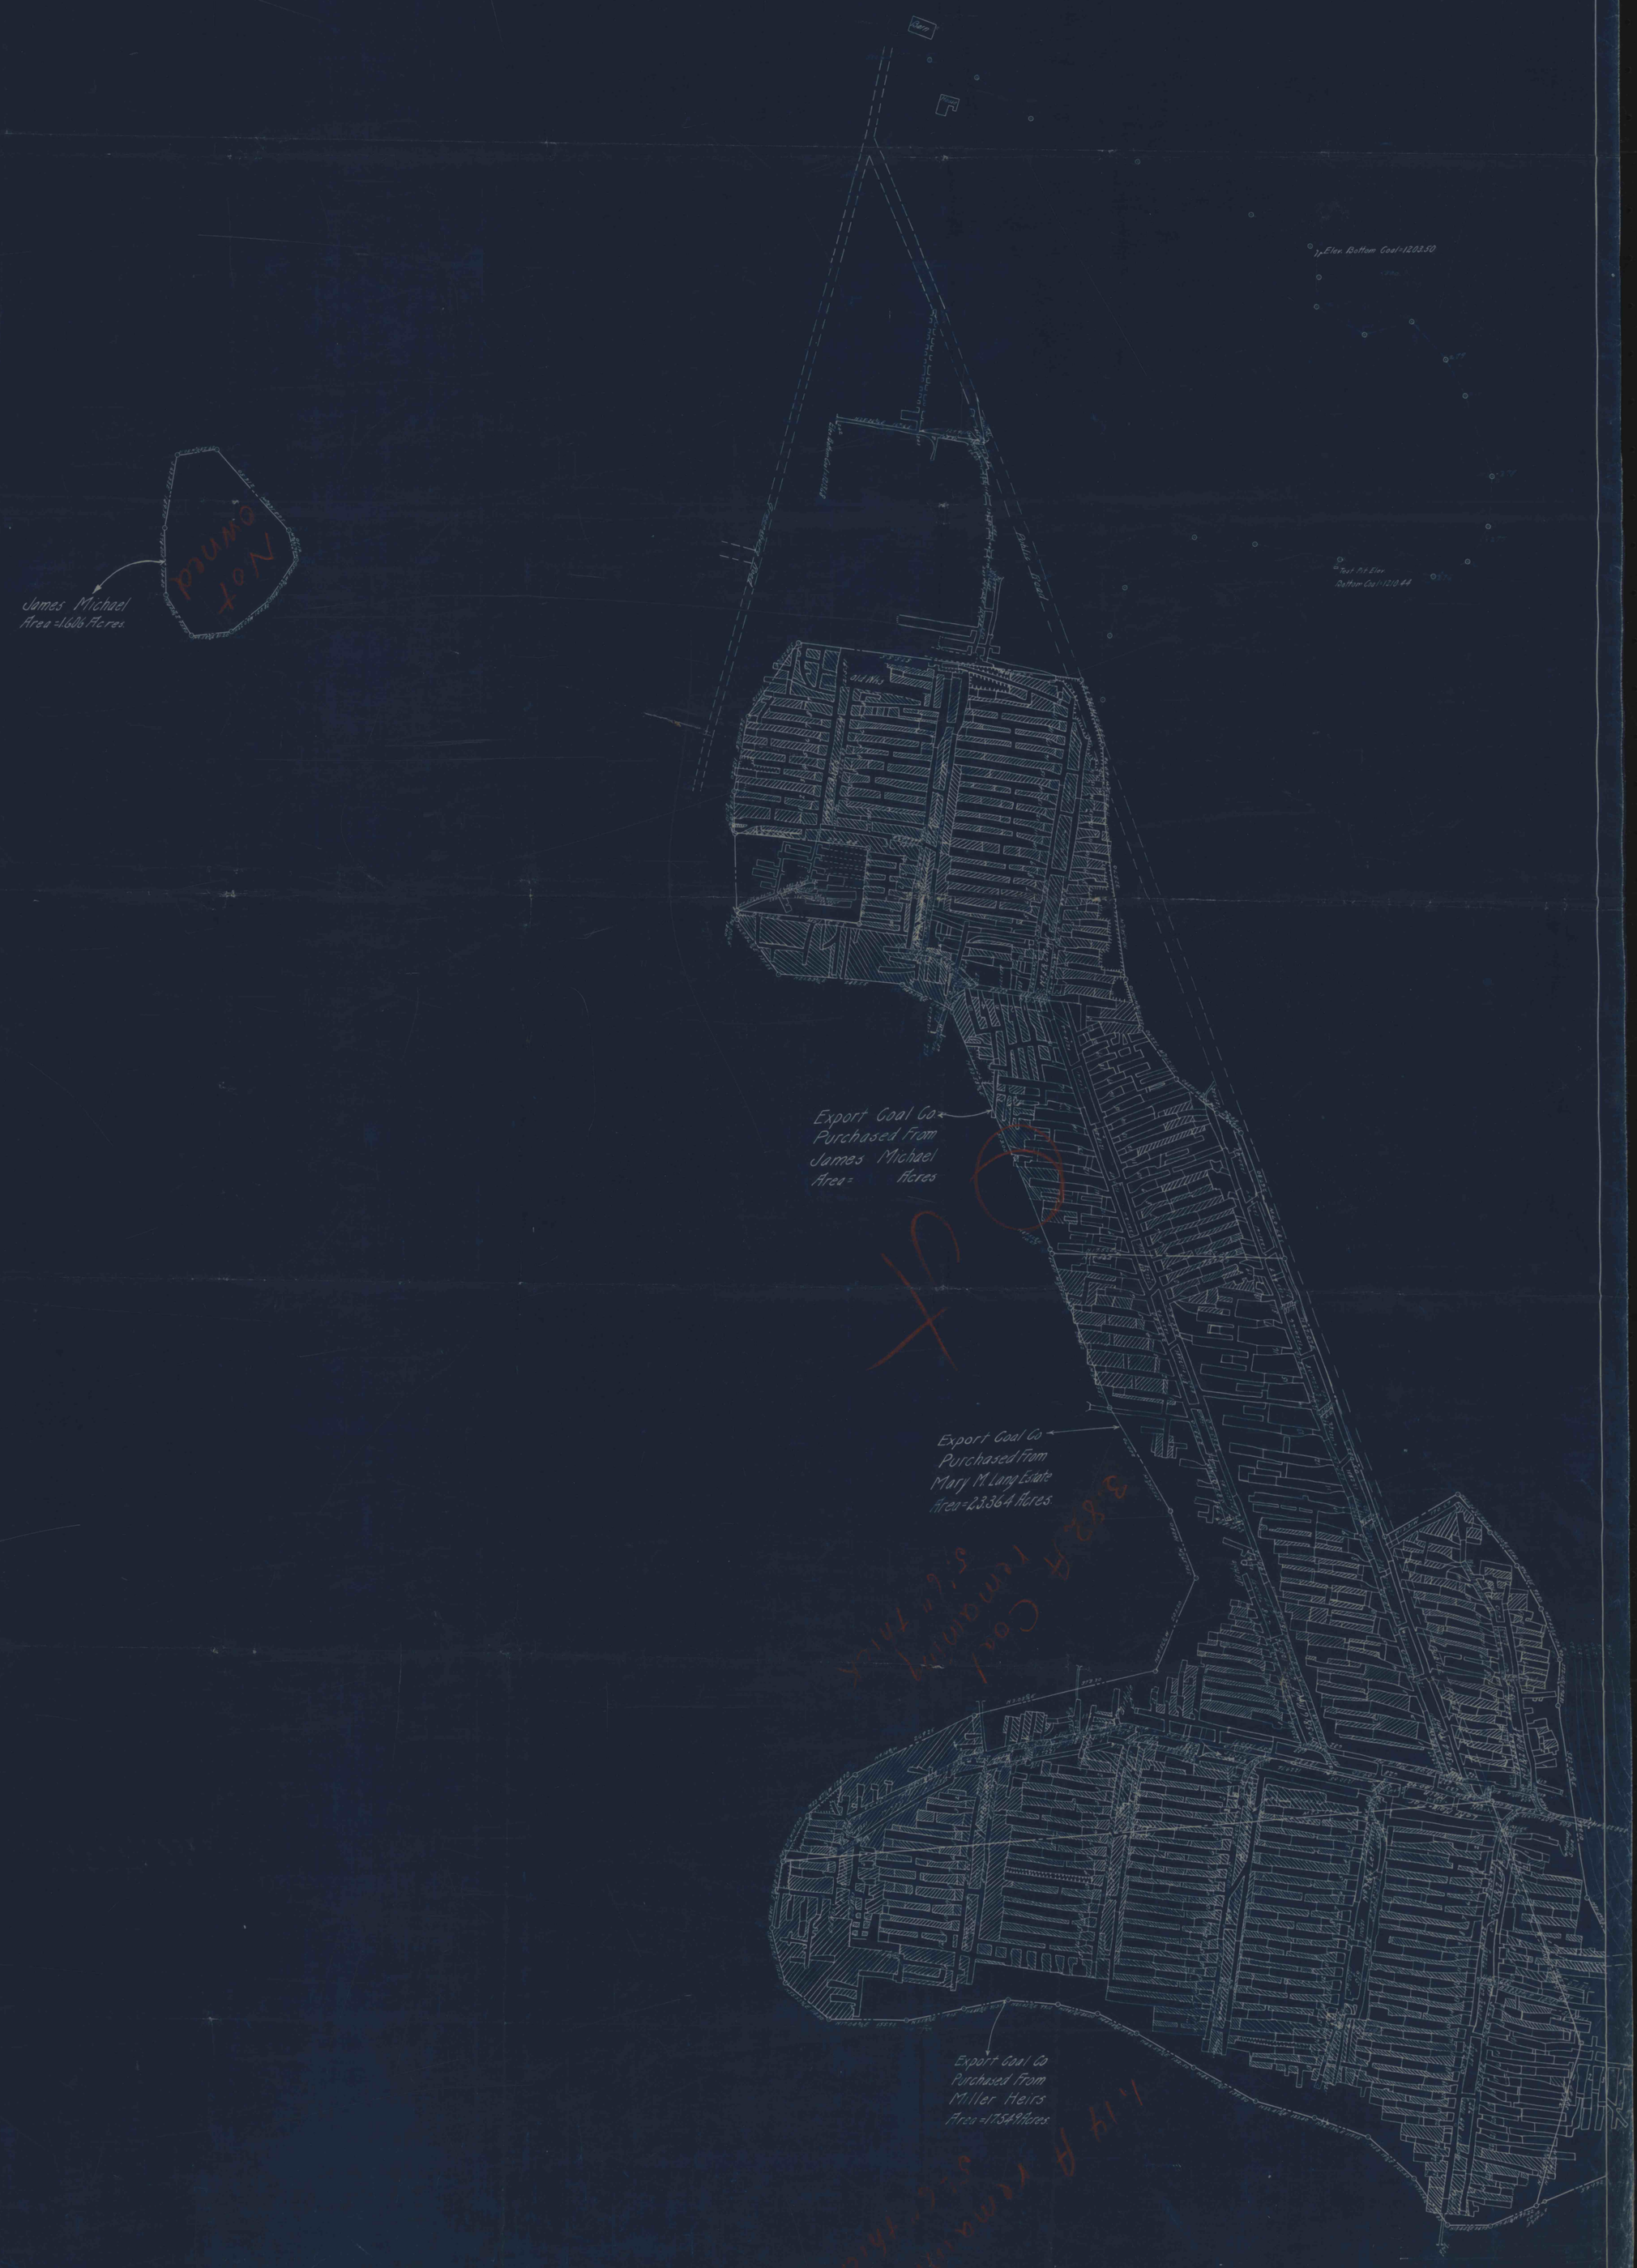
Flex Bottom Coal=1203.50
Test Pit Elev
Bottom Coal=1210.44
Bible Road
Old Mine
James Michael
Area=1.66 Acres
Not owned
Export Coal Co
Purchased From
James Michael
Area= Acres
Export Coal Co
Purchased From
Mary M Lang Estate
Area=23.364 Acres
Export Coal Co
Purchased From
Miller Heirs
Area=175.99 Acres