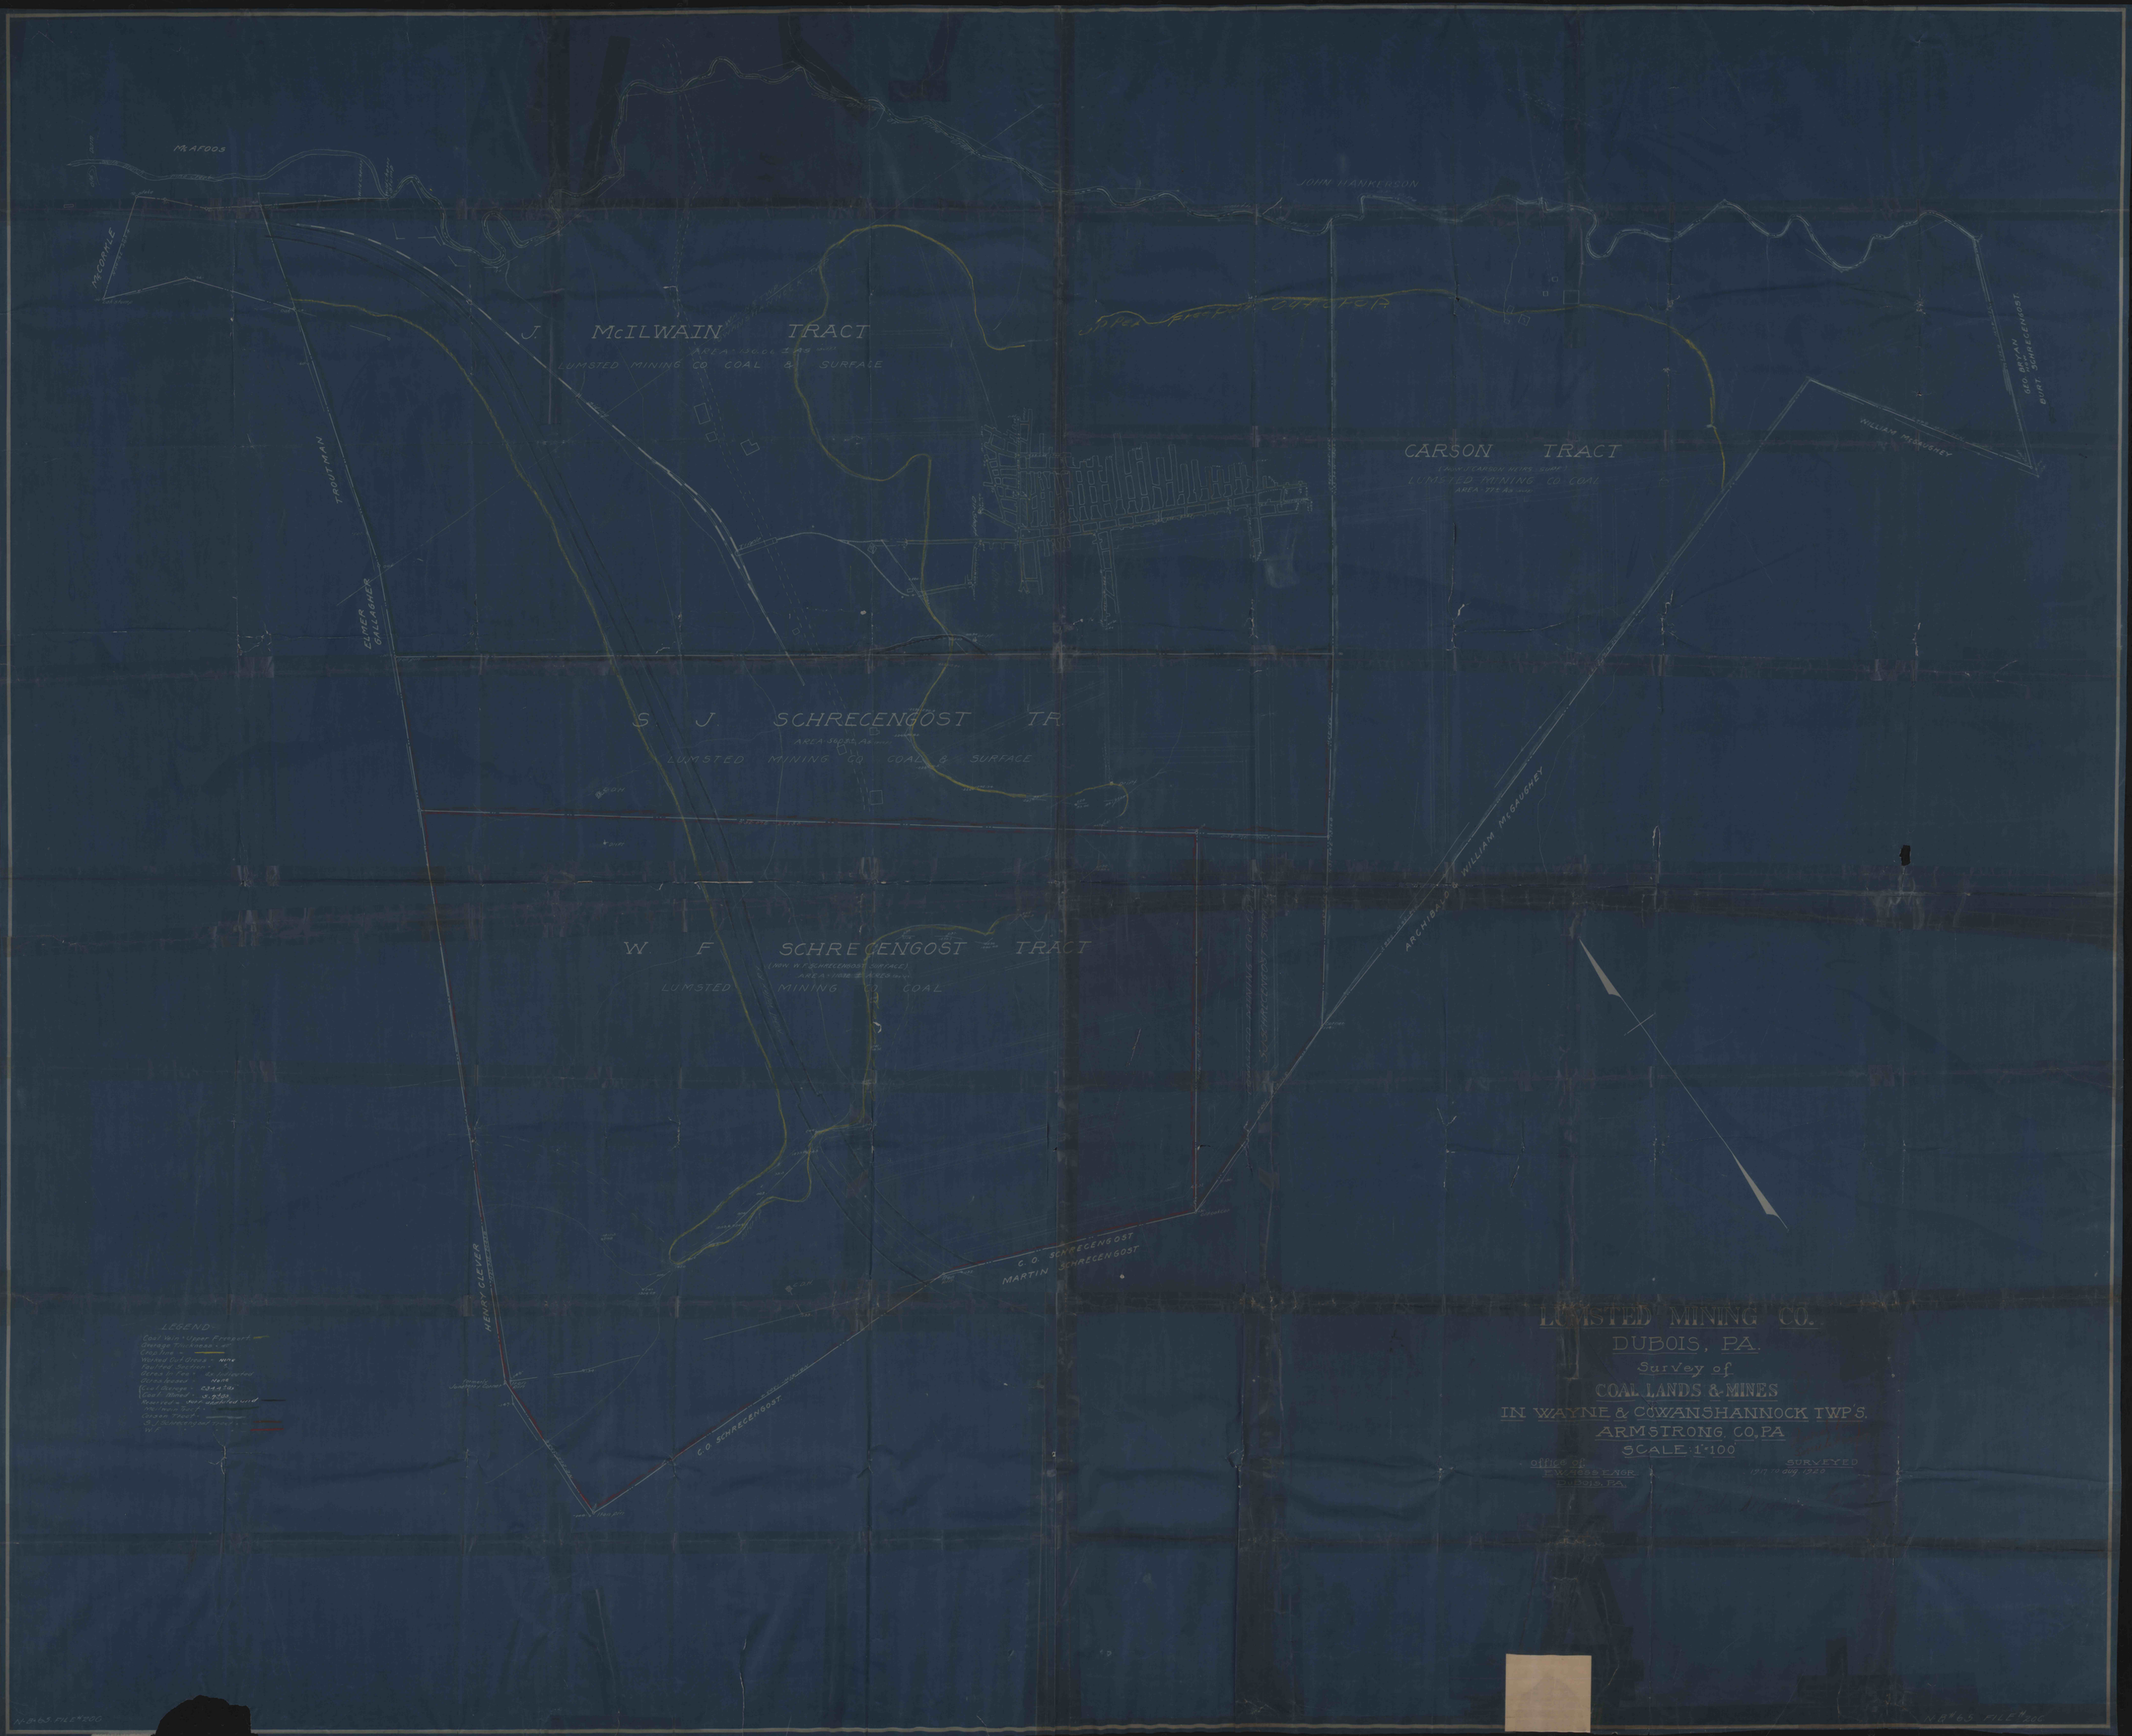
McAFOOS
McCORKLE
JOHN HANKERSON
J. McILWAIN TRACT
LUMSTED MINING CO COAL & SURFACE
CARSON TRACT
LUMSTED MINING CO COAL
WILLIAM McGAUGHEY
GEO. BRYAN
BURT SCHRECENGOST
TROUTMAN
ELMER GALLAGHER
S. J. SCHRECENGOST TR.
LUMSTED MINING CO COAL & SURFACE
W. F. SCHRECENGOST TRACT
LUMSTED MINING CO COAL
ARCHIBALD & WILLIAM McGAUGHEY
HENRY CLEVER
C. O. SCHRECENGOST
MARTIN SCHRECENGOST
C. O. SCHRECENGOST
LEGEND
LUMSTED MINING CO.
DUBOIS, PA.
Survey of
COAL LANDS & MINES
IN WAYNE & COWANSHANNOCK TWP'S.
ARMSTRONG CO, PA
SCALE: 1"=100'
SURVEYED
1917 to aug 1920