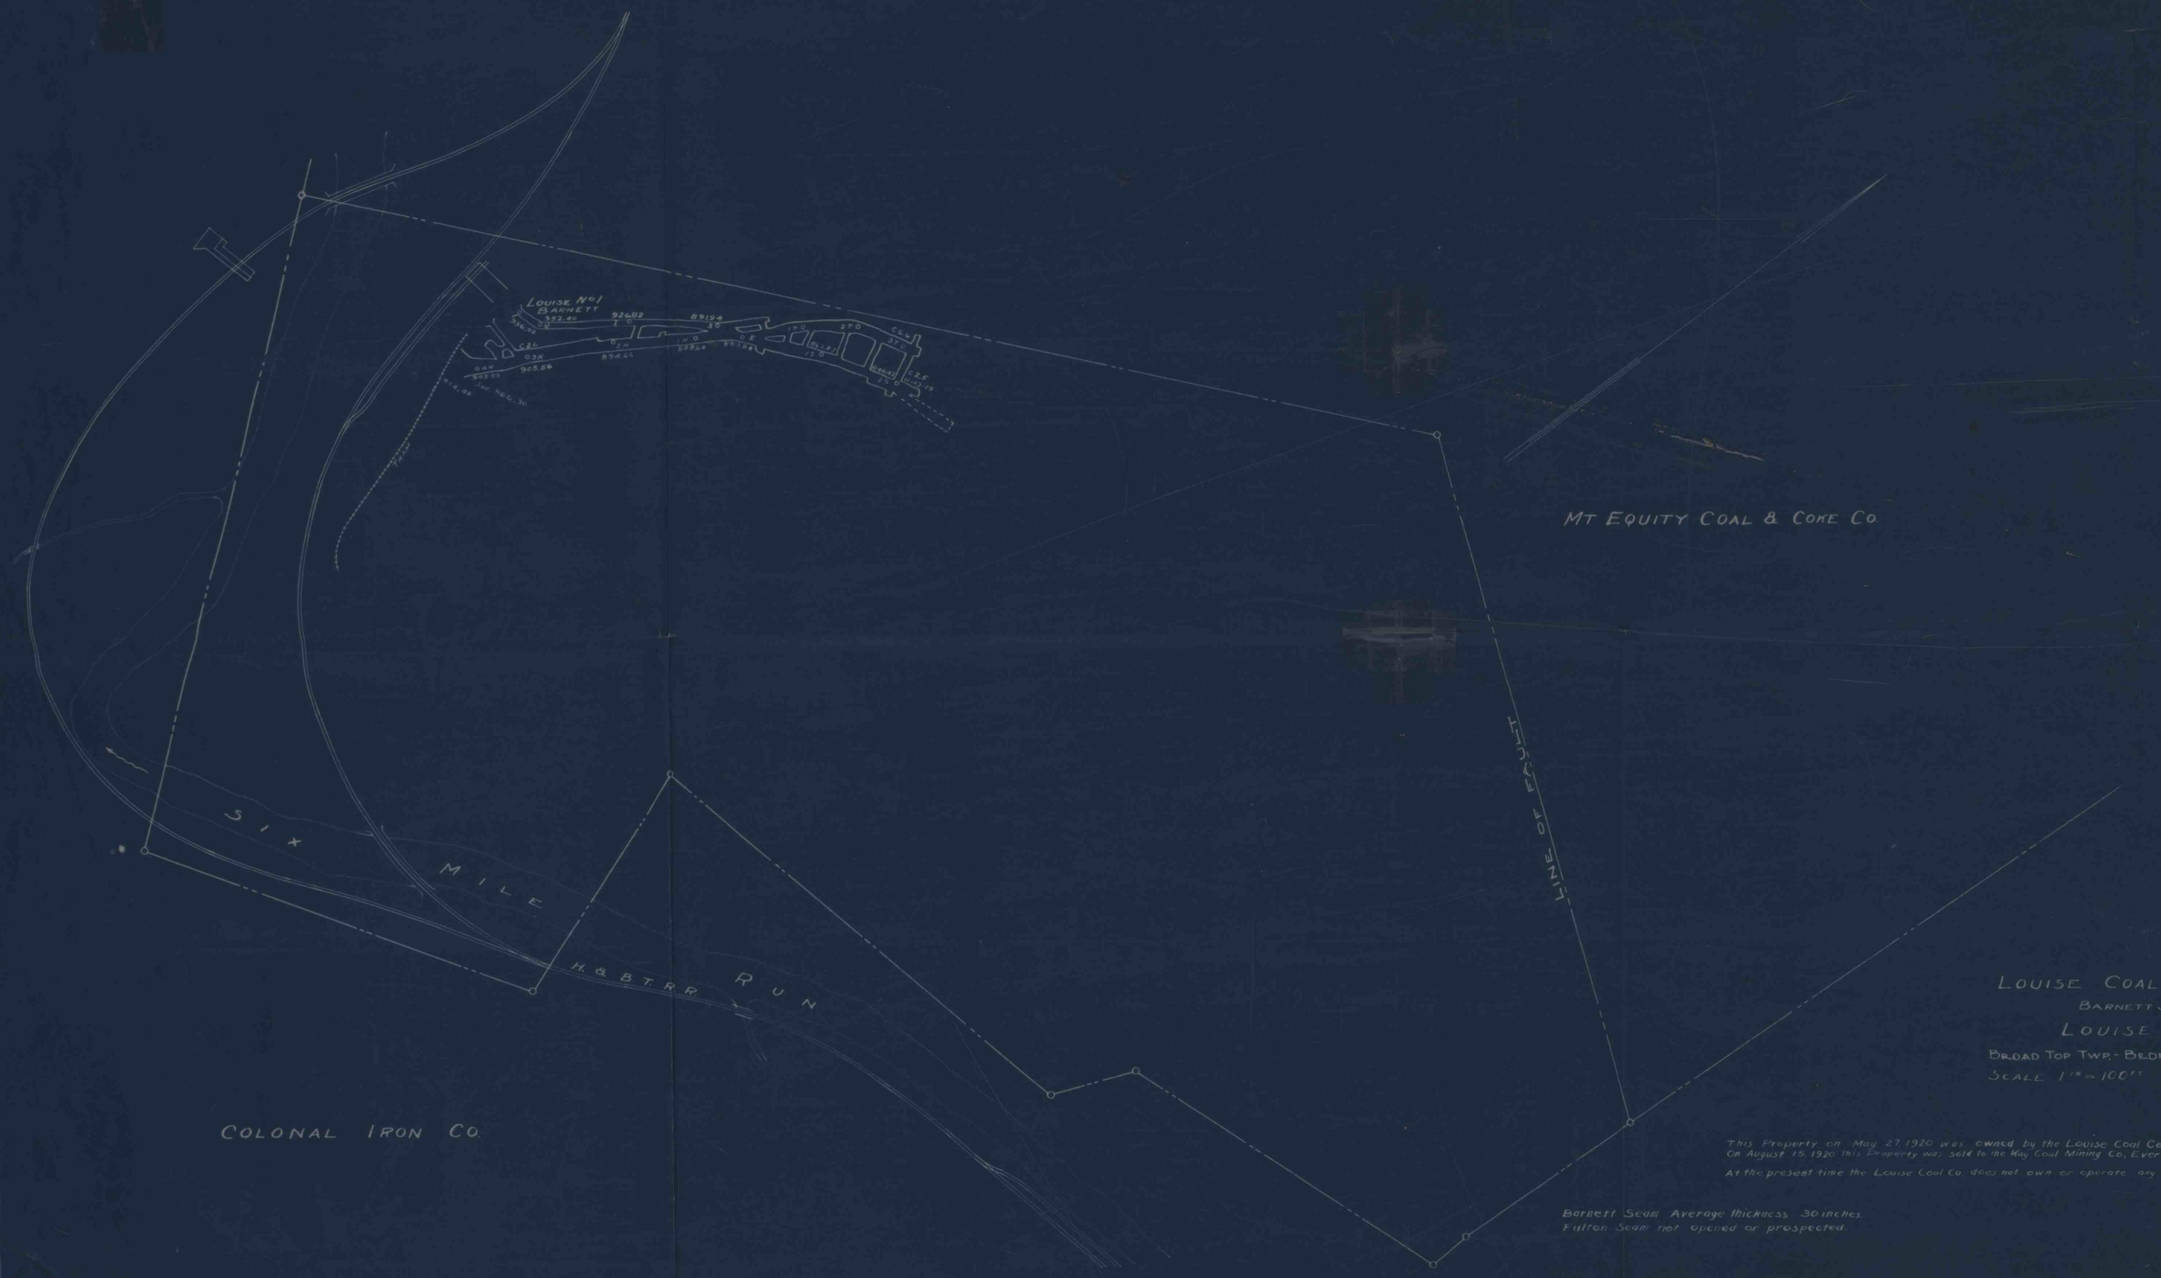

LOUISE COAL COMPANY

BARNETT SEAM

LOUISE No. 1

BROAD TOP TWP. - BEDFORD CO. - PENNA.

SCALE 1" = 100' OCT. 30. 1920

H. G. WILMER, ENGR.

This Property on May 27. 1920 was owned by the Louise Coal Co. (BARNETT & FULTON SEAMS ONLY)
On August 15. 1920 this Property was sold to the Kay Coal Mining Co. Everett Pa.

At the present time the Louise Coal Co. does not own or operate any Coal Lands.

Barnett Seam Average thickness 30 inches.
Fulton Seam not opened or prospected.