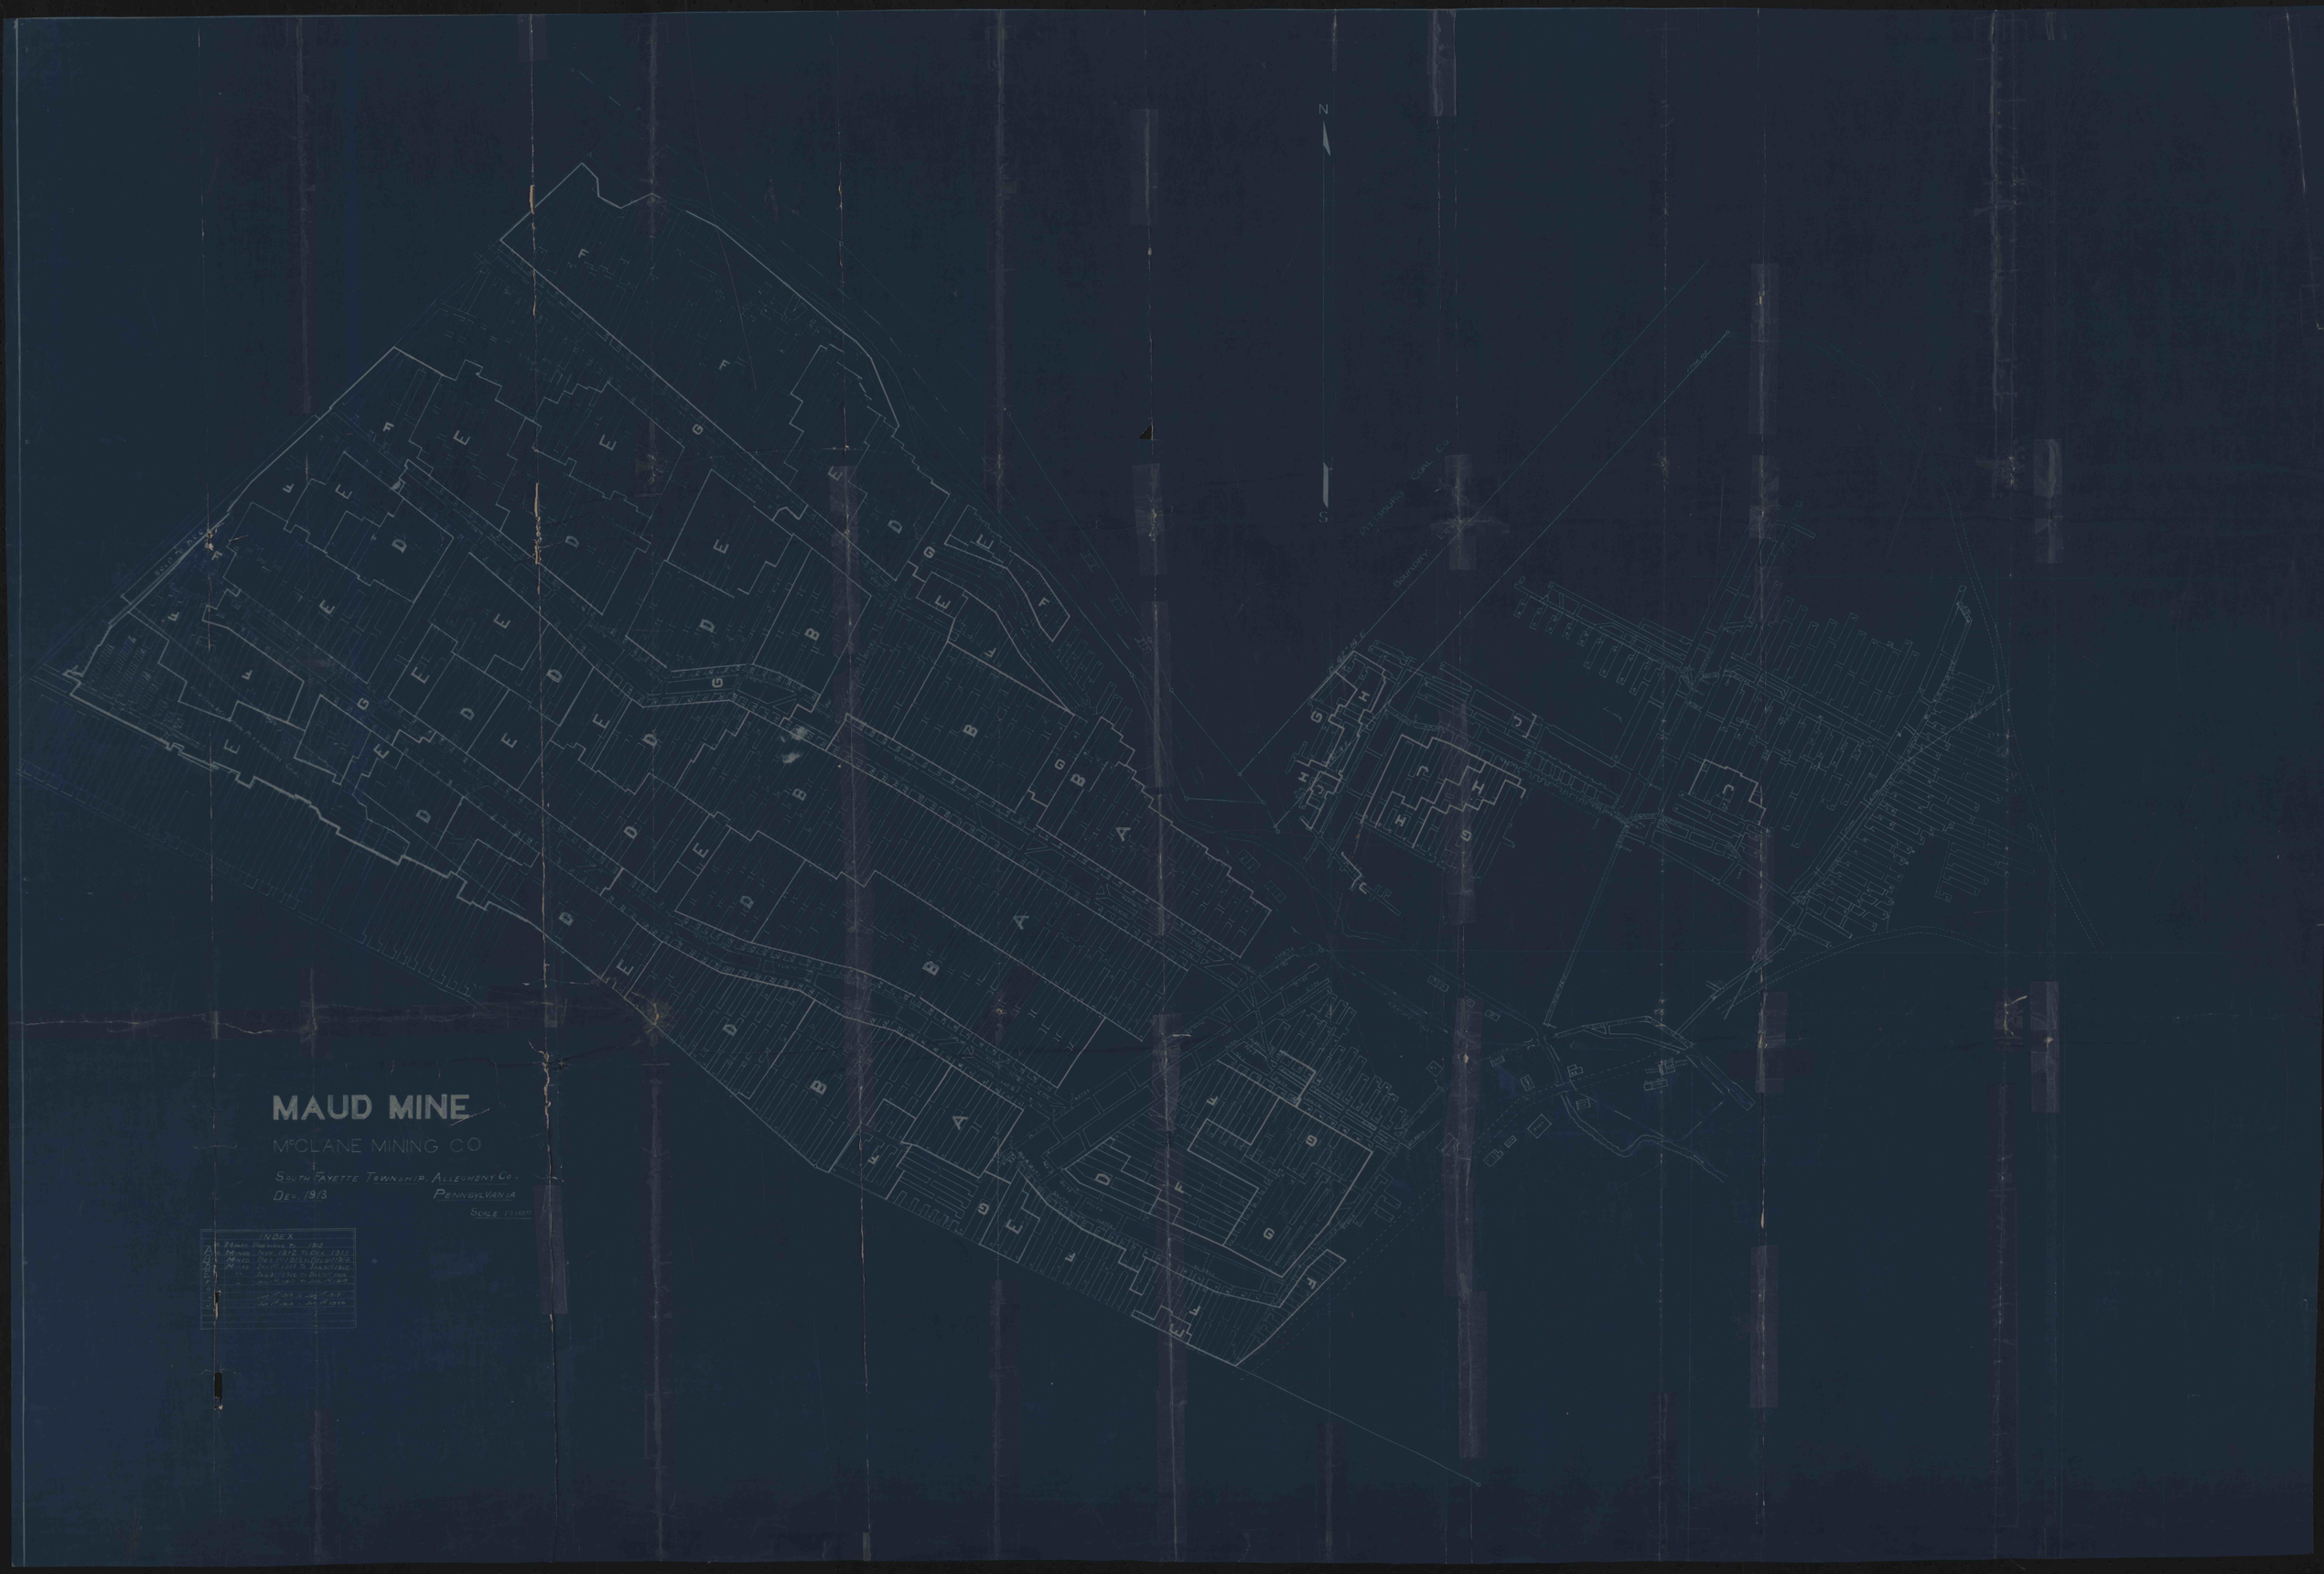
MAUD MINE
McCLANE MINING CO
SOUTH FAYETTE TOWNSHIP, ALLEGHENY CO.,
DEC. 1913
PENNSYLVANIA
SCALE 1:2160
INDEX
A Mined Previous to 1912
B Mined Nov. 1912 to Dec. 1913
C Mined Dec. 1913 to Dec. 1914
D Mined Jan. 1915 to Jan. 1916
E " Jan. 1916 to Dec. 1916
F " Jan. 1917 to Jan. 1918
G " Jan. 1919 to Jan. 1920
H " Jan. 1919 to Jan. 1920
N
S