No. 14

MAP OF MAPLE RIDGE COLLIERY
BENS CREEK COAL MINING CO. LESSEE.
ON PROPERTY OF CAMBRIA MINING & MFG. CO.
BENS CREEK PA.

Scale: 1"=100'

Jas. Gillyman & Co.
Engineers.
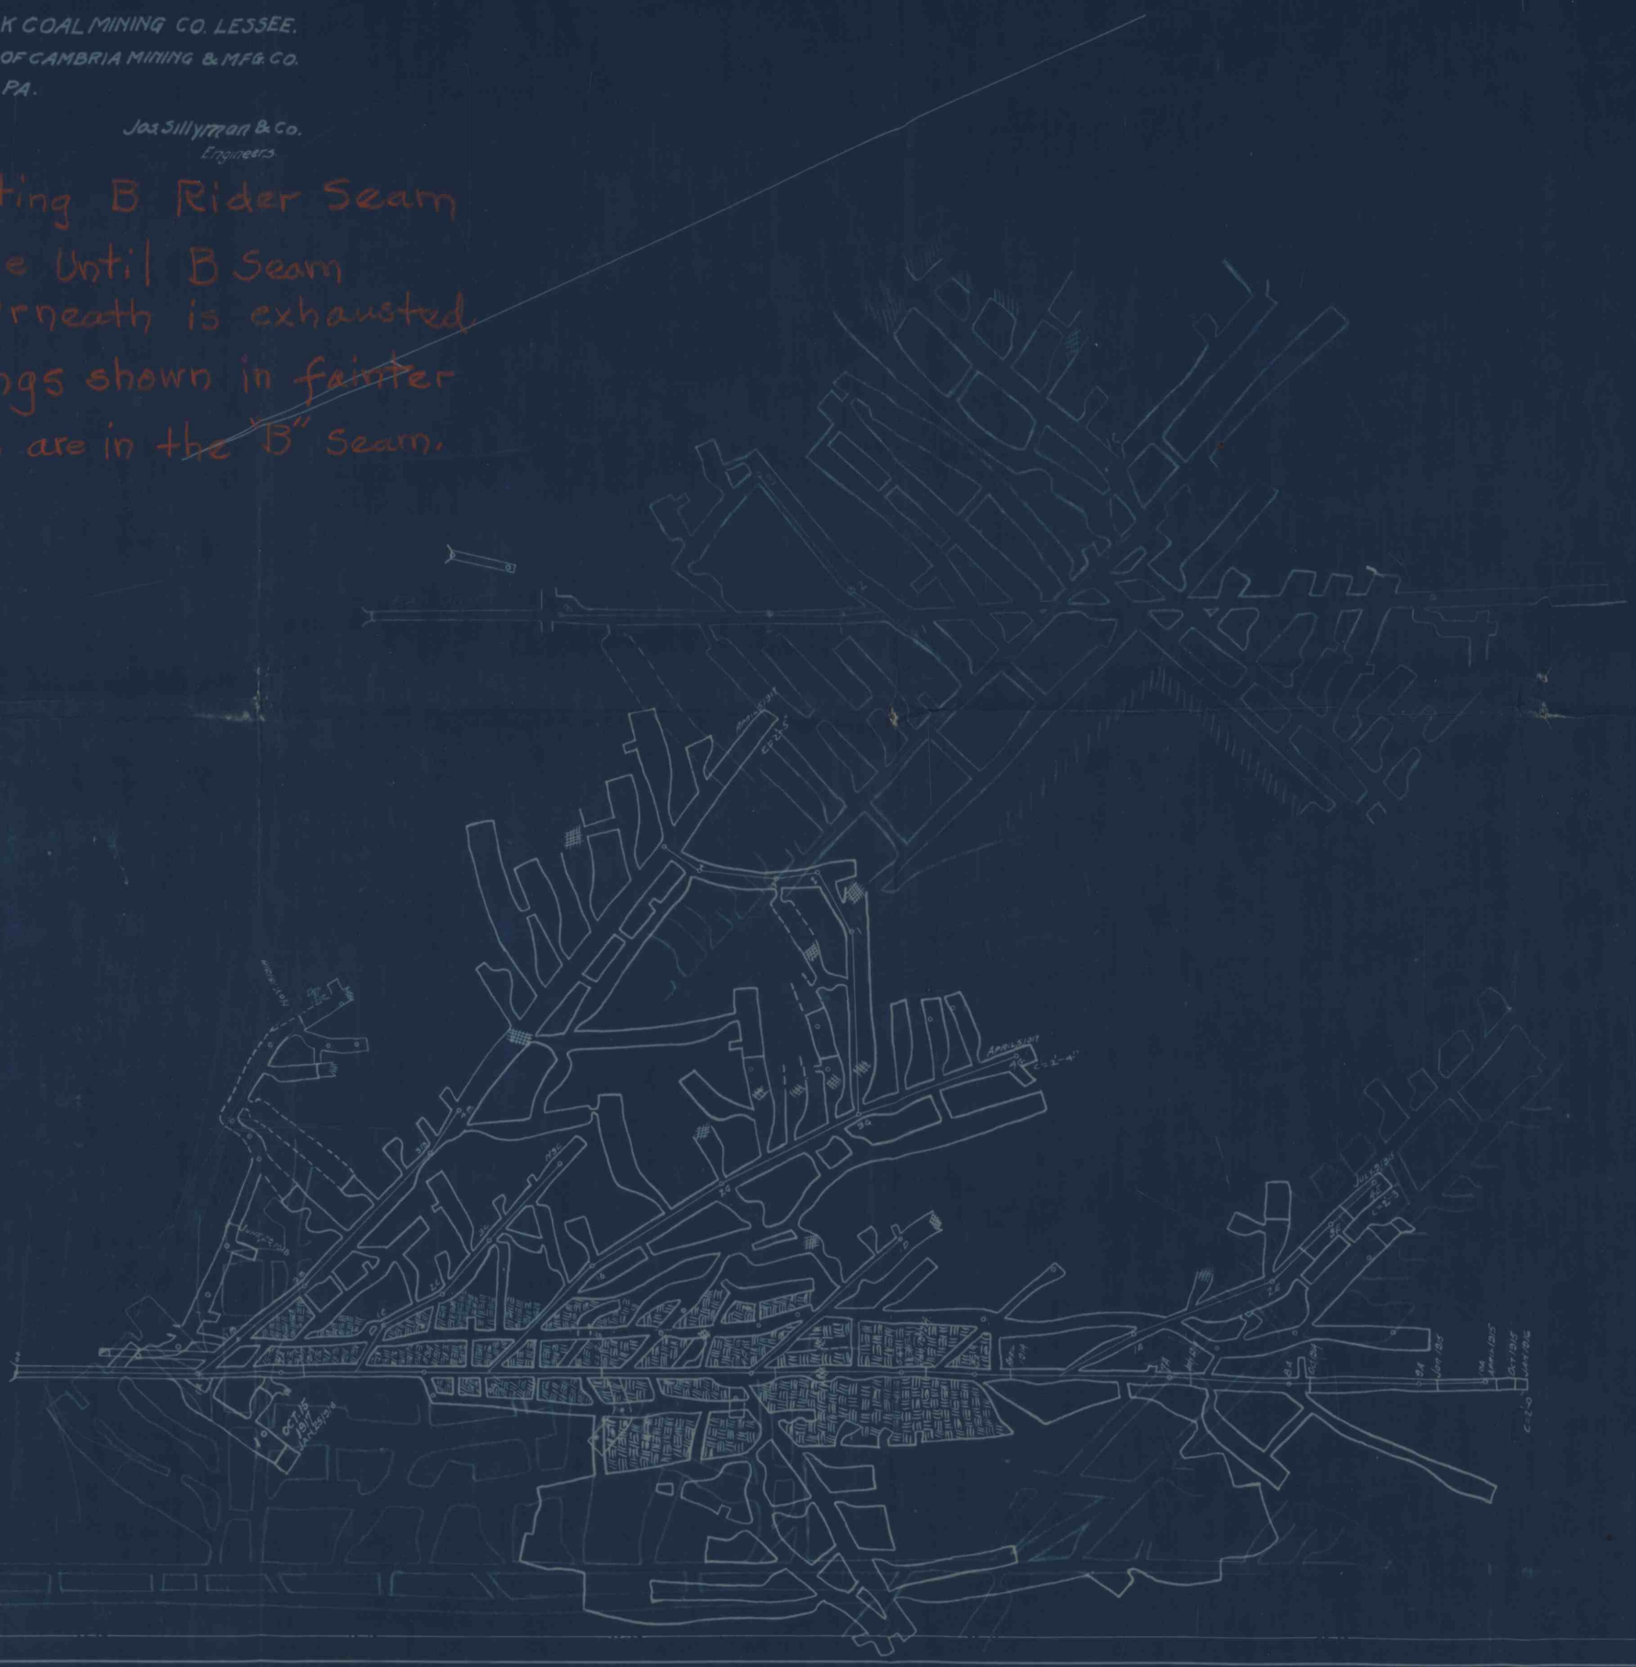
Operating B Rider Seam
Now Idle Until B Seam
underneath is exhausted.
Workings shown in fainter
lines are in the "B" Seam.