LLOYDELL FUEL CO.

MAP OF

MINE WORKINGS

LLOYDELL, CAMBRIA CO, PA

-Scale, 1"=100'-

October-30th-1918

-Gardner A. Stoker-

Mining Engr-Johnstown, Penna.

Note:-

All work this side of red line copied from old prints. All pillars are supposed to have been drawn

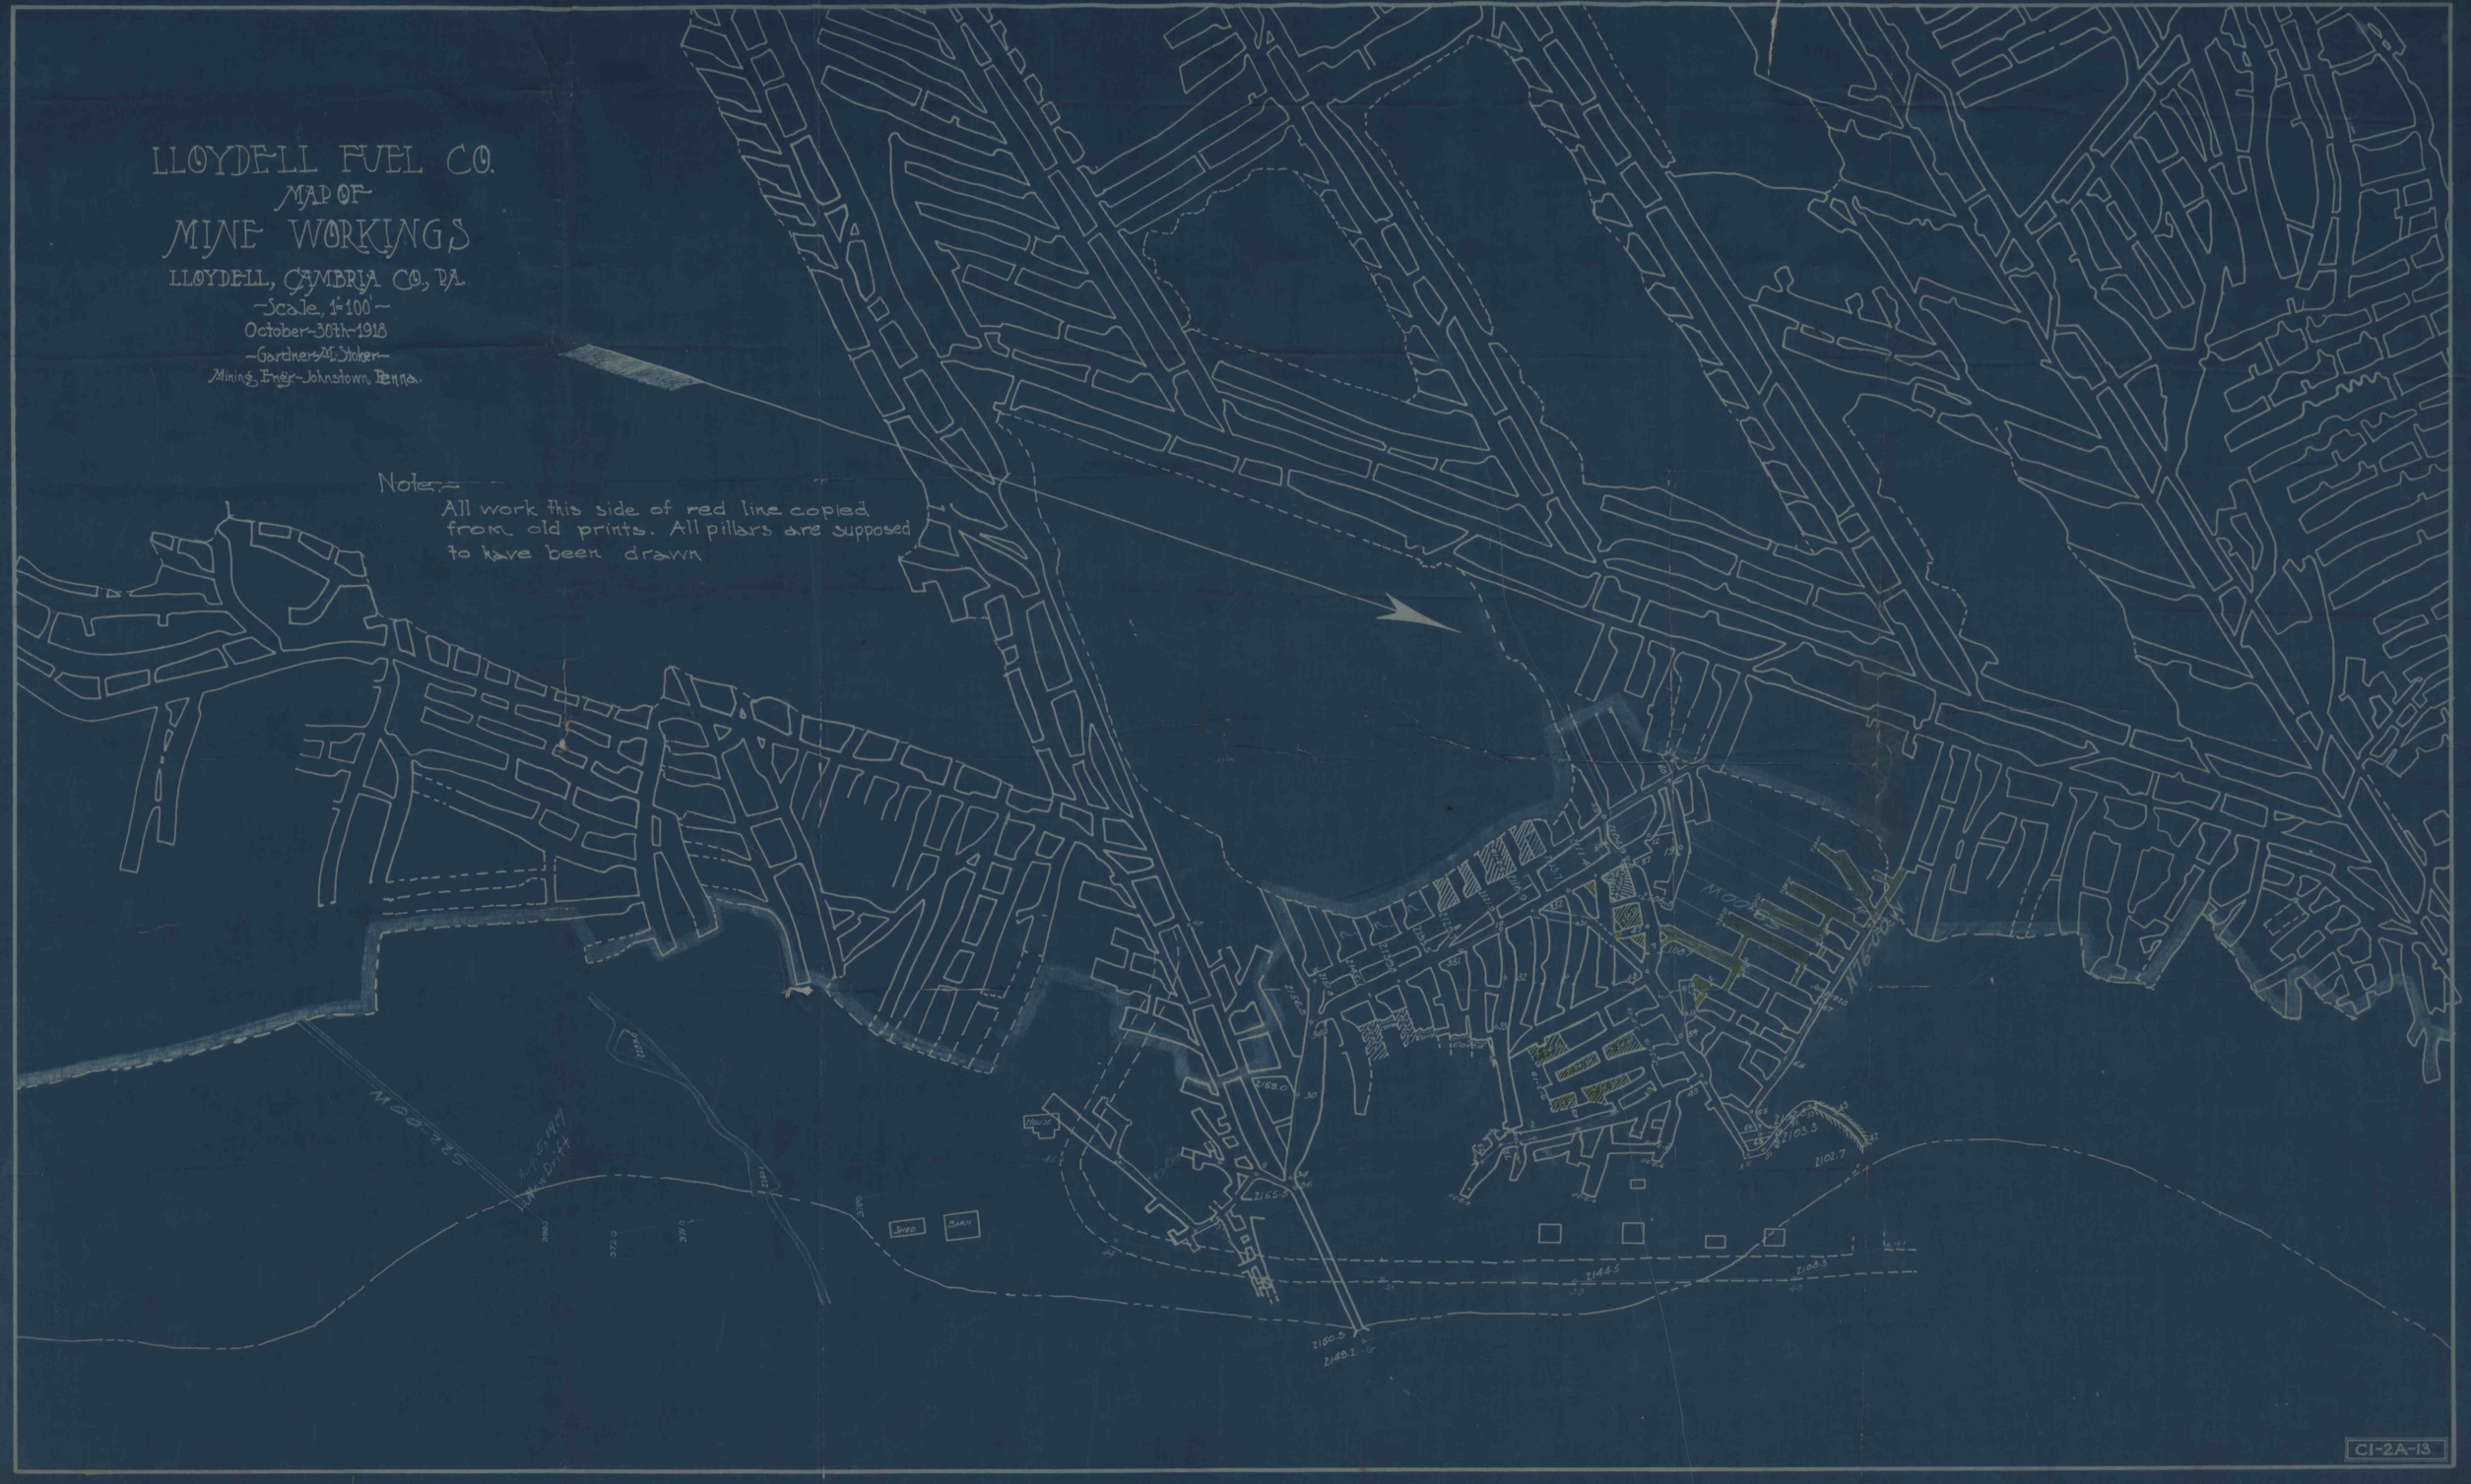

C1-2A-13