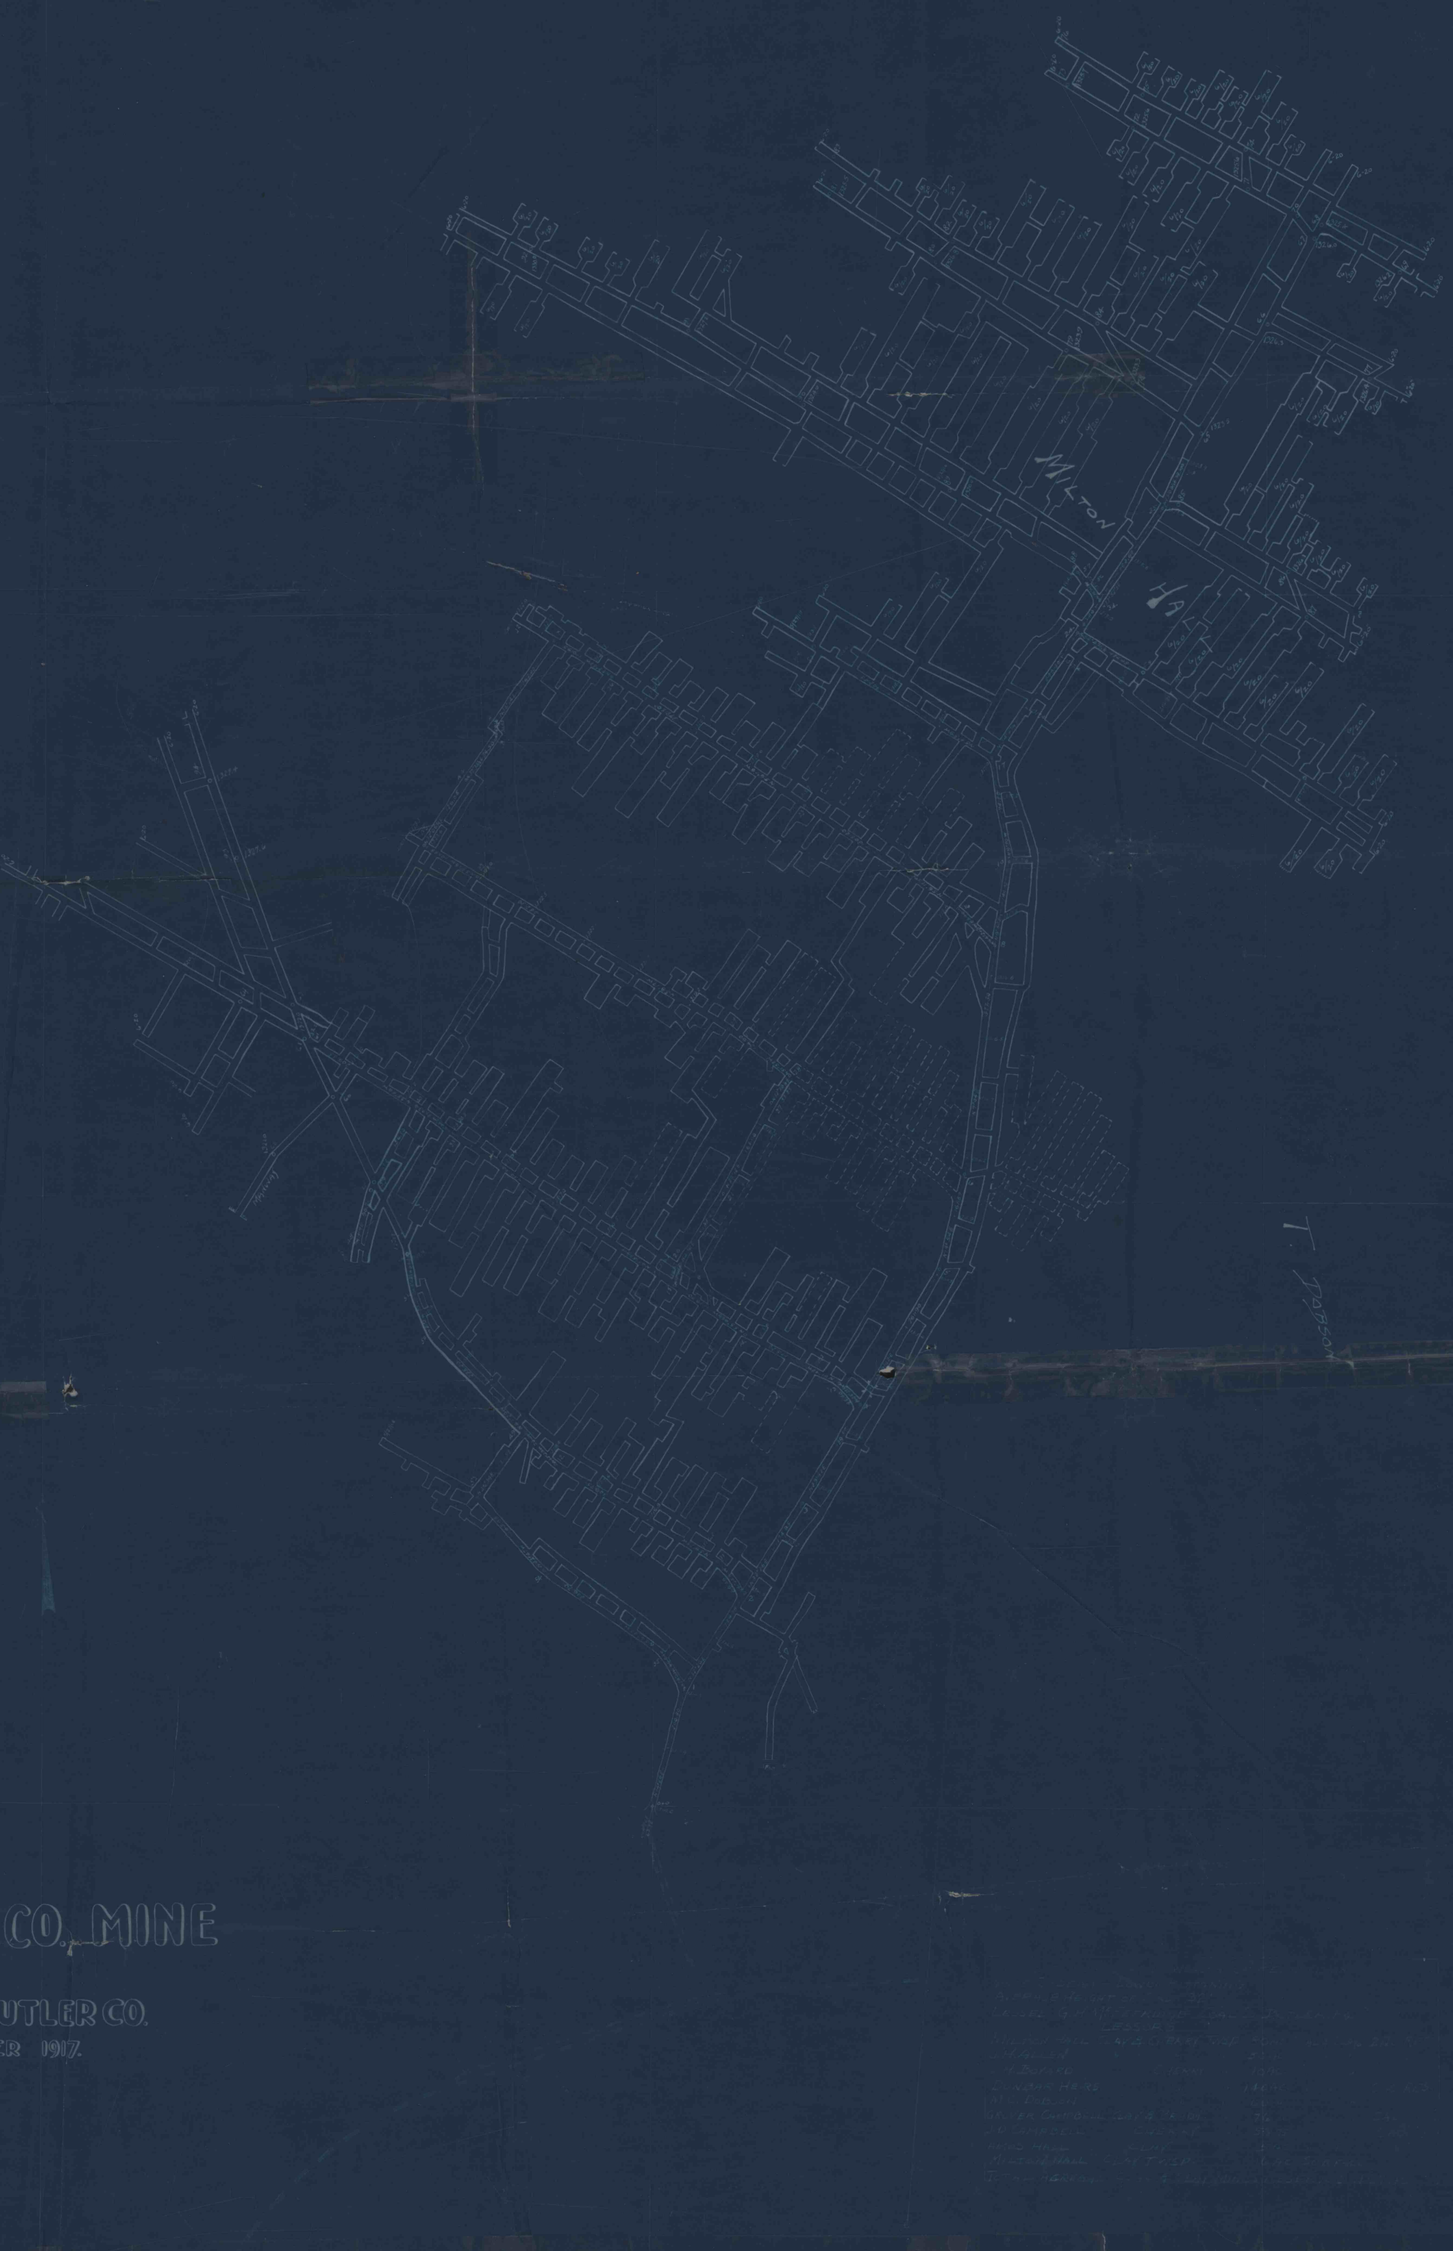

PLAN OF
G.H.McFETRIDGE COAL CO. MINE
SITUATE IN
CLAY & CHERRY TWP. BUTLER CO.
SCALE 1" = 100' DECEMBER 1917.
R. J. DAVIS. ENGINEER. BUTLER. PA