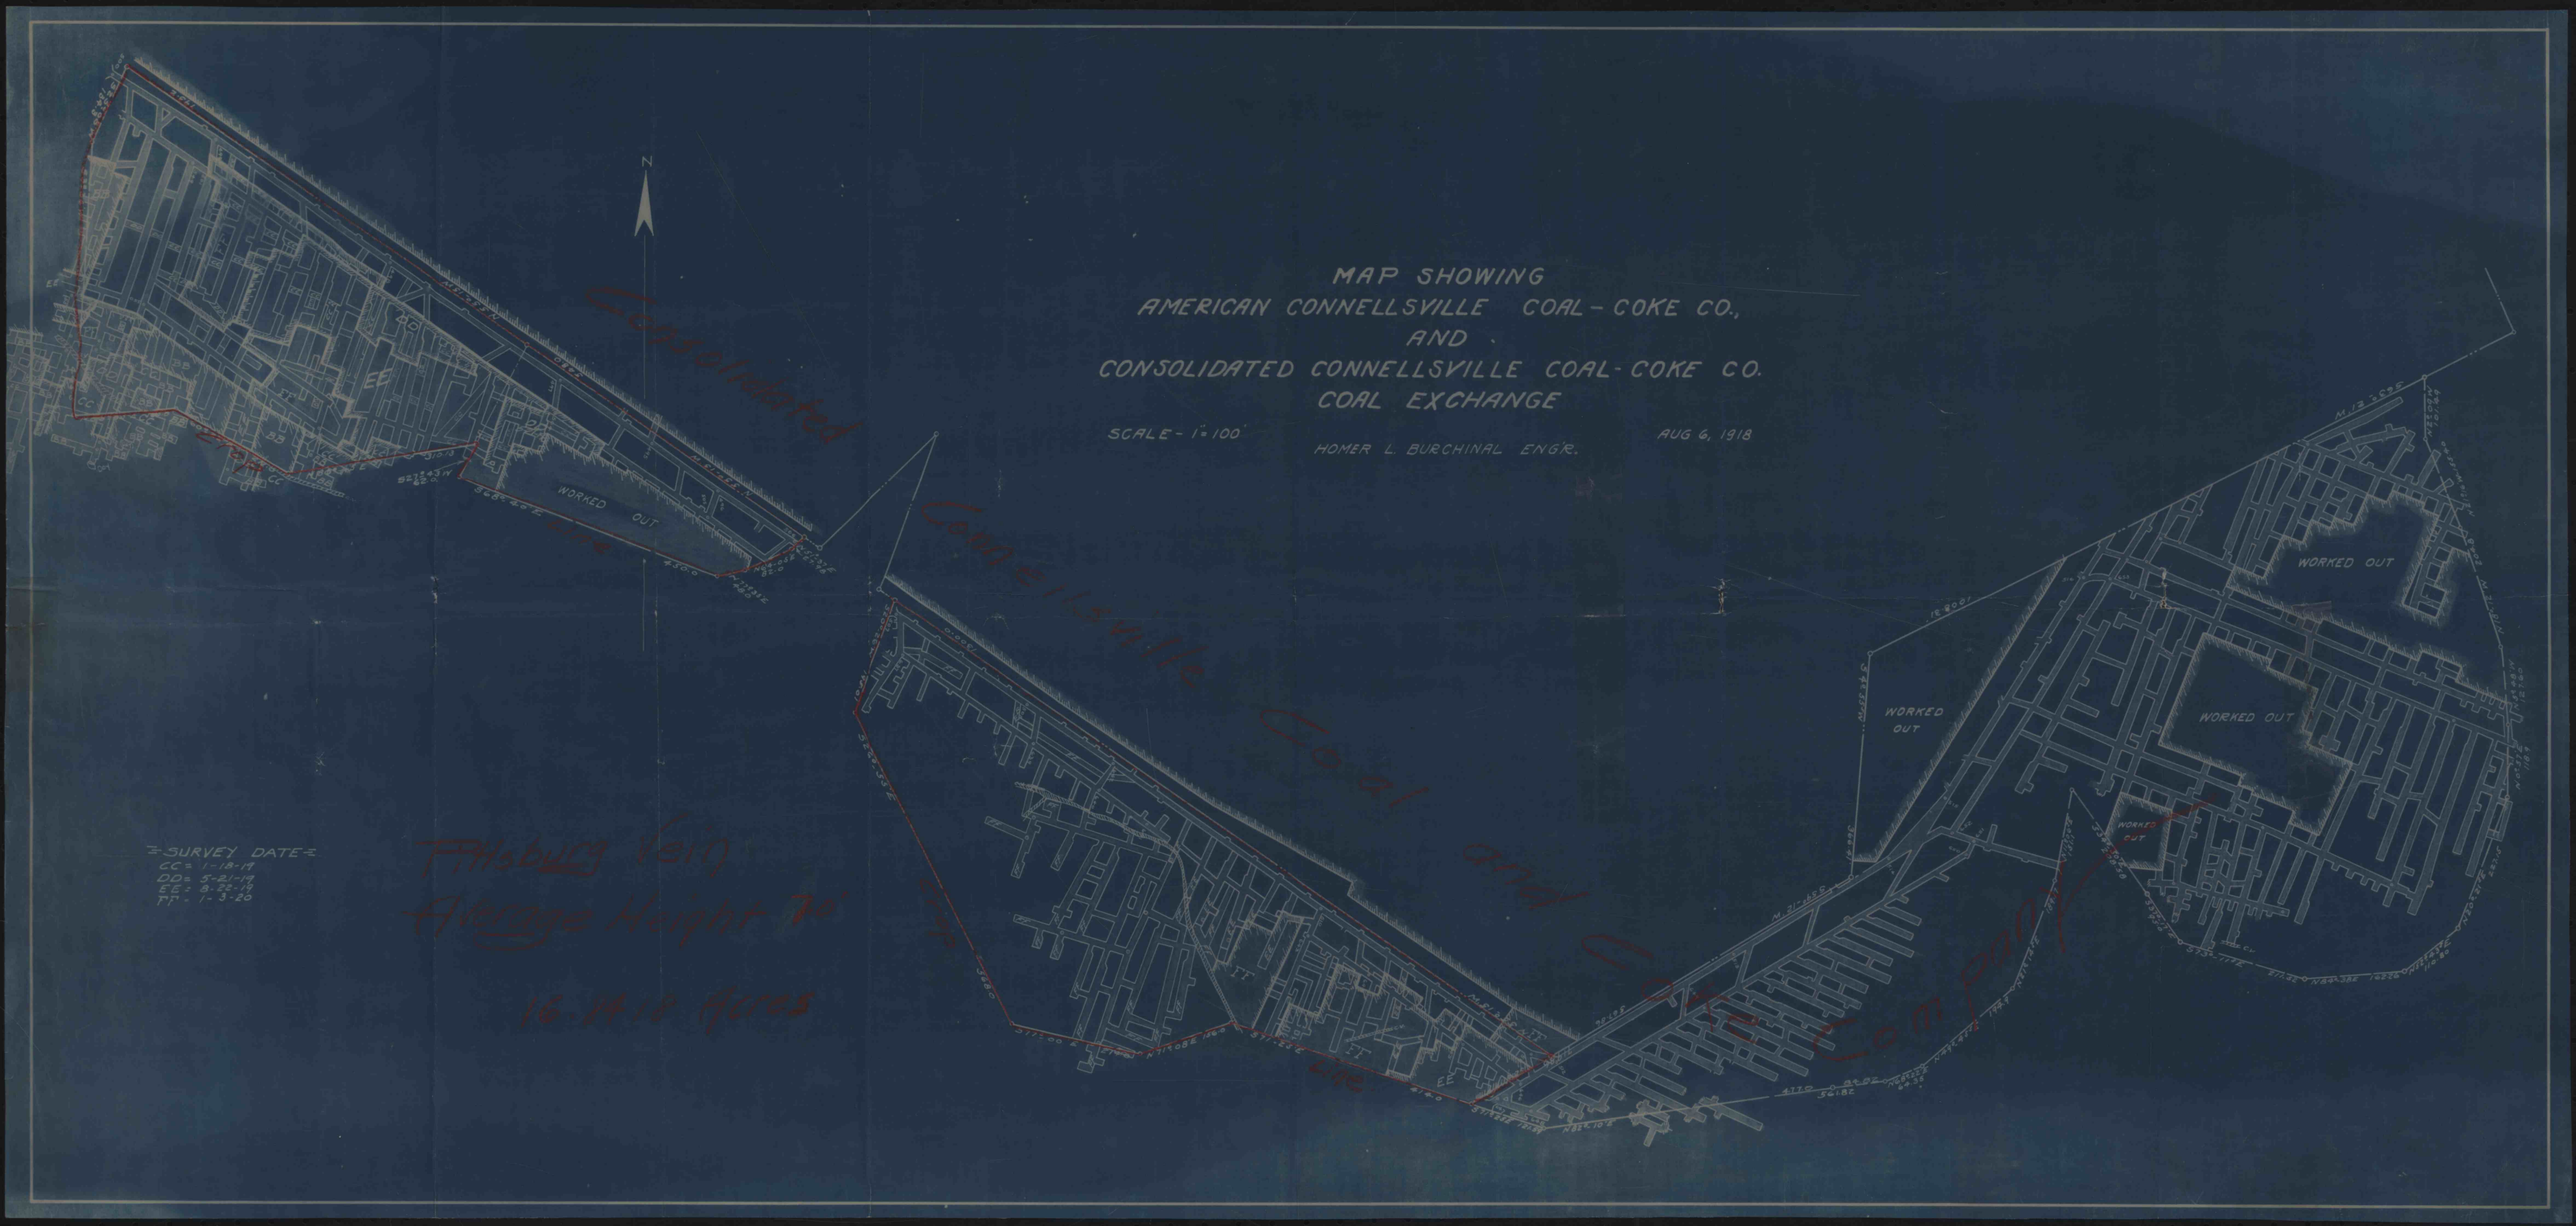
MAP SHOWING
AMERICAN CONNELLSVILLE COAL - COKE CO.,
AND
CONSOLIDATED CONNELLSVILLE COAL - COKE CO.
COAL EXCHANGE
SCALE - 1" = 100'
HOMER L. BURCHINAL ENG'R.
AUG 6, 1918
N
Consolidated
Connellsville Coal and Coke Co.
WORKED OUT
WORKED OUT
WORKED OUT
WORKED OUT
WORKED OUT
Pittsburg Vein
Average Height 7'
16.14 Acres
SURVEY DATE
CC = 1-18-19
DD = 5-21-19
EE = 8-22-19
FF = 1-3-20