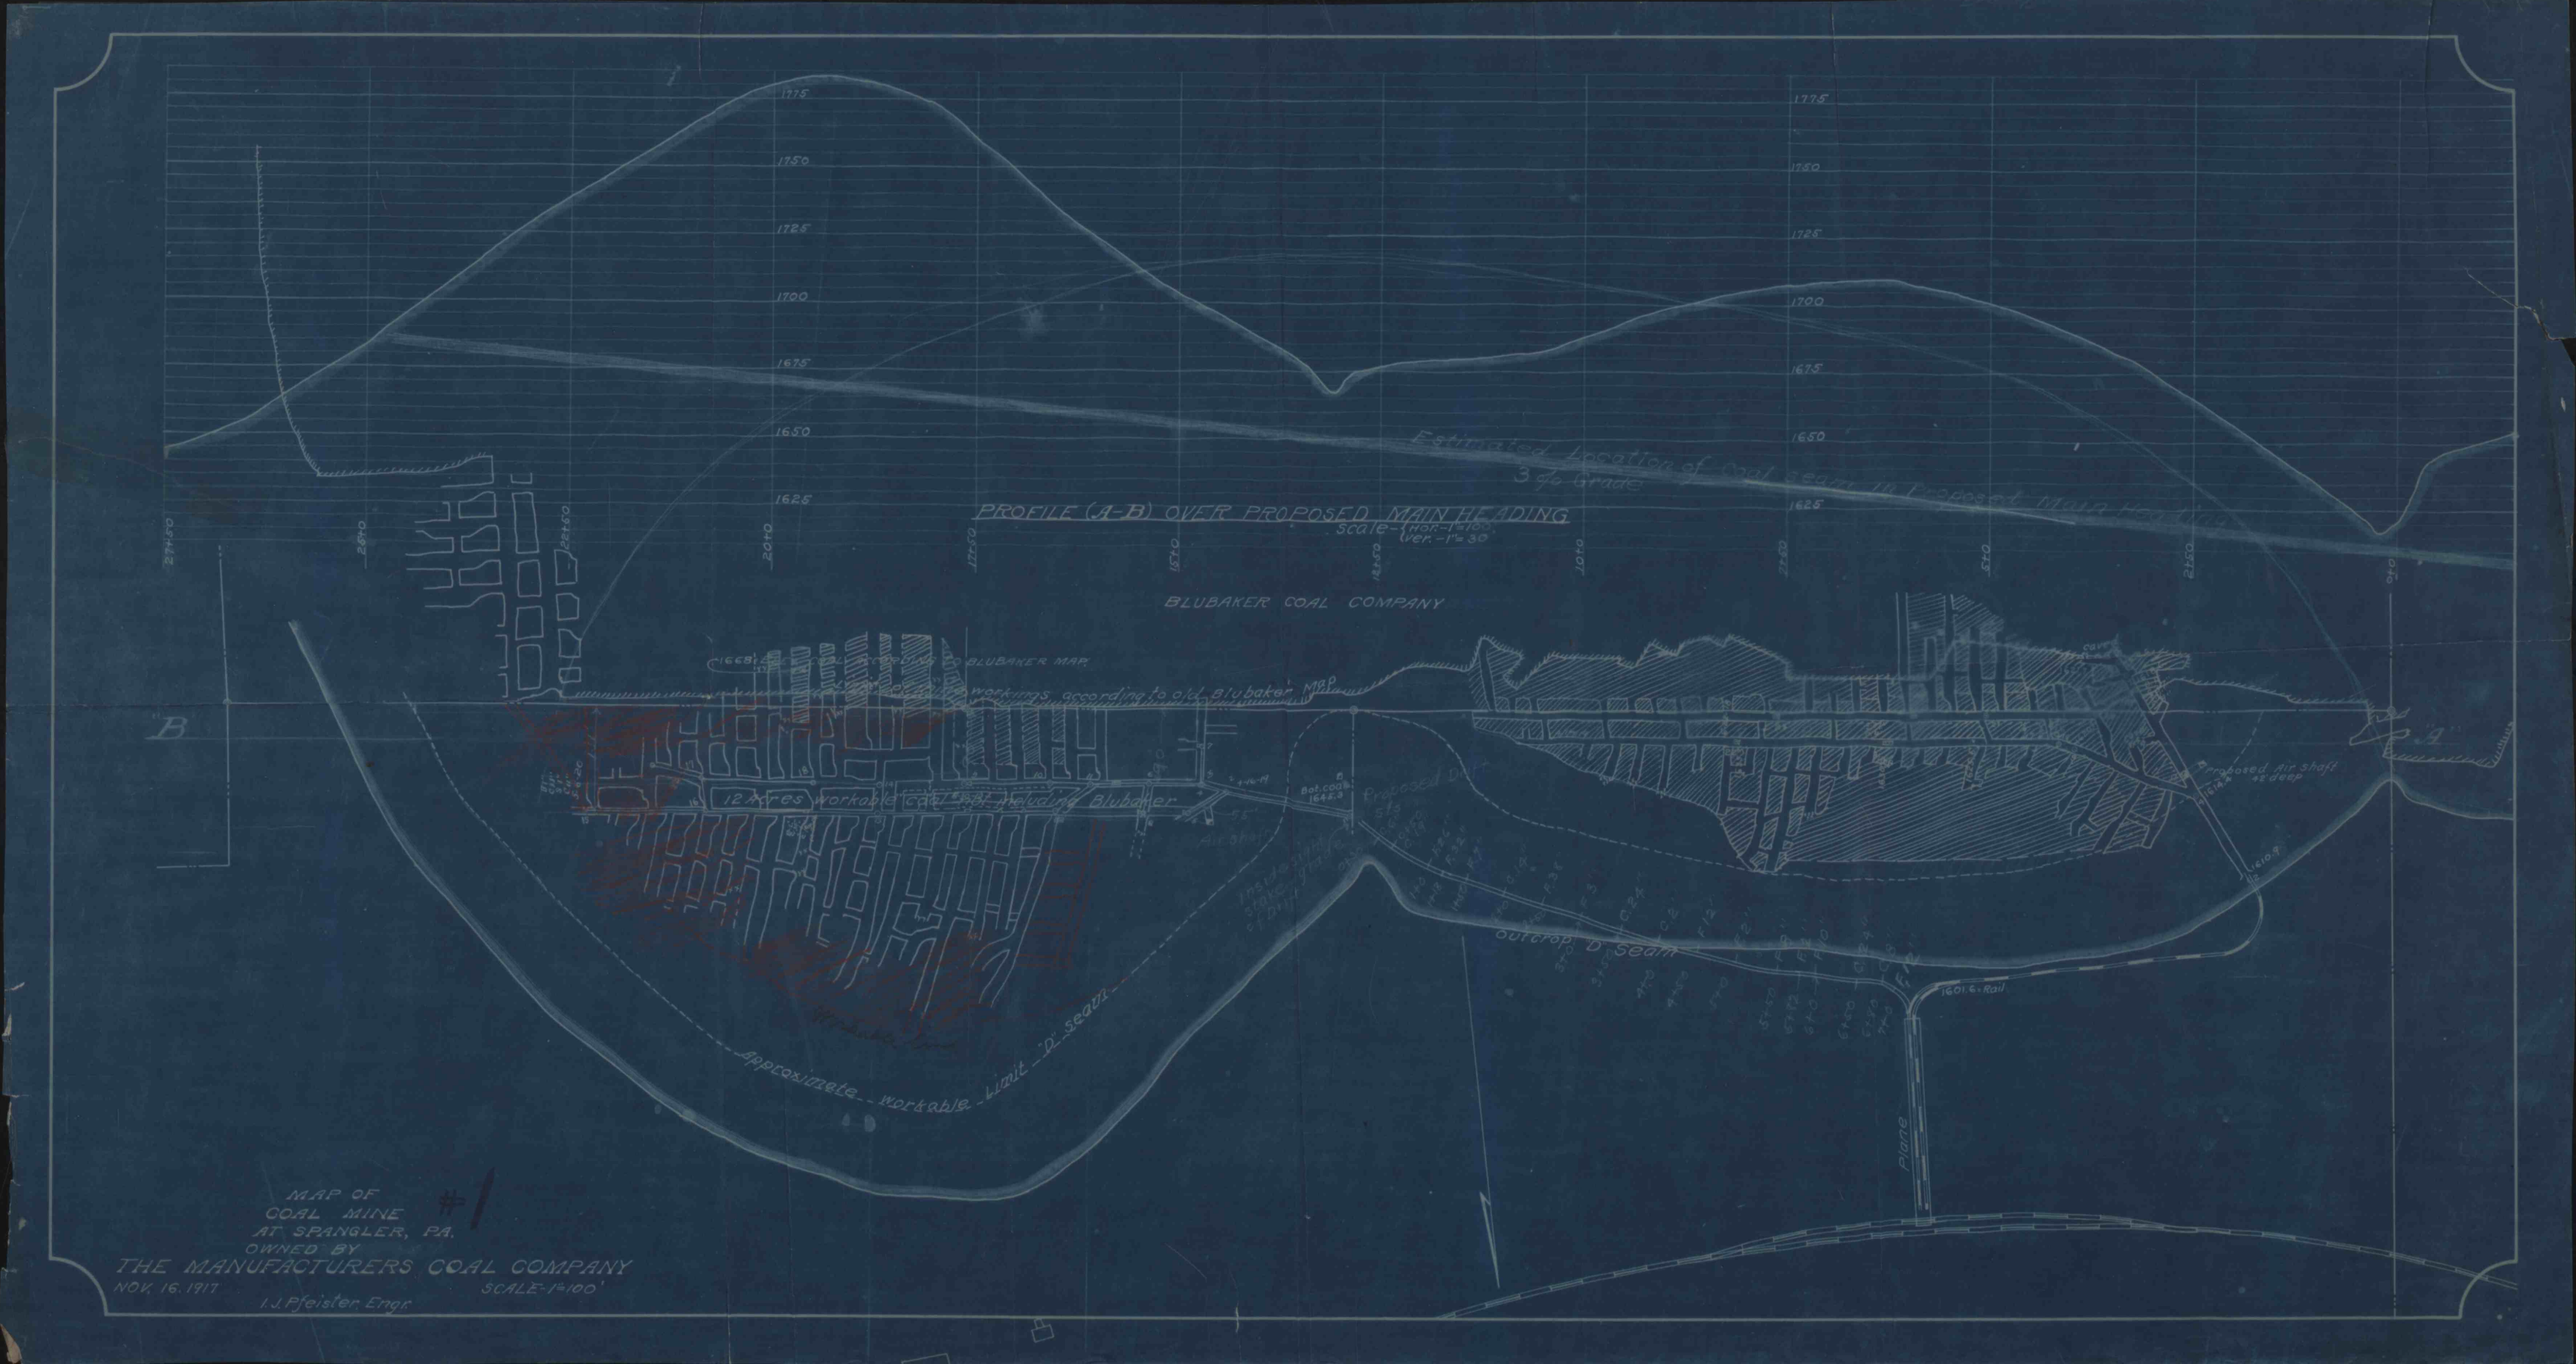

PROFILE (A-B) OVER PROPOSED MAIN HEADING
Scale-{Hor.-1"=100' Ver.-1"=30'
Estimated Location of Coal Seam in Proposed Main Heading
3% Grade
BLUBAKER COAL COMPANY
BLUBAKER MAP
Workings according to old Blubaker Map
12 Acres Workable Coal Not Including Blubaker
Proposed Air Shaft 42 deep
Outcrop "D" Seam
Approximate Workable Limit "D" Seam
Plane
MAP OF
COAL MINE
AT SPANGLER, PA.
OWNED BY
THE MANUFACTURERS COAL COMPANY
NOV. 16. 1917
SCALE-1"=100'
I. J. Pfeister, Engr.
#1