This Knob of Coal is on right side of road leading from Balsinger to Mectlellandtown.

Approximately 1¼ miles from Balsinger & about 500 North of Road.

MAP SHOWING PORTION OF McCLELLANDTOWN COAL CO'S. — MINE —

German Twp. Fayette County, Pa.

Scale 1" = 100'

H. L. Burchinal Engr. Uniontown, Pa.
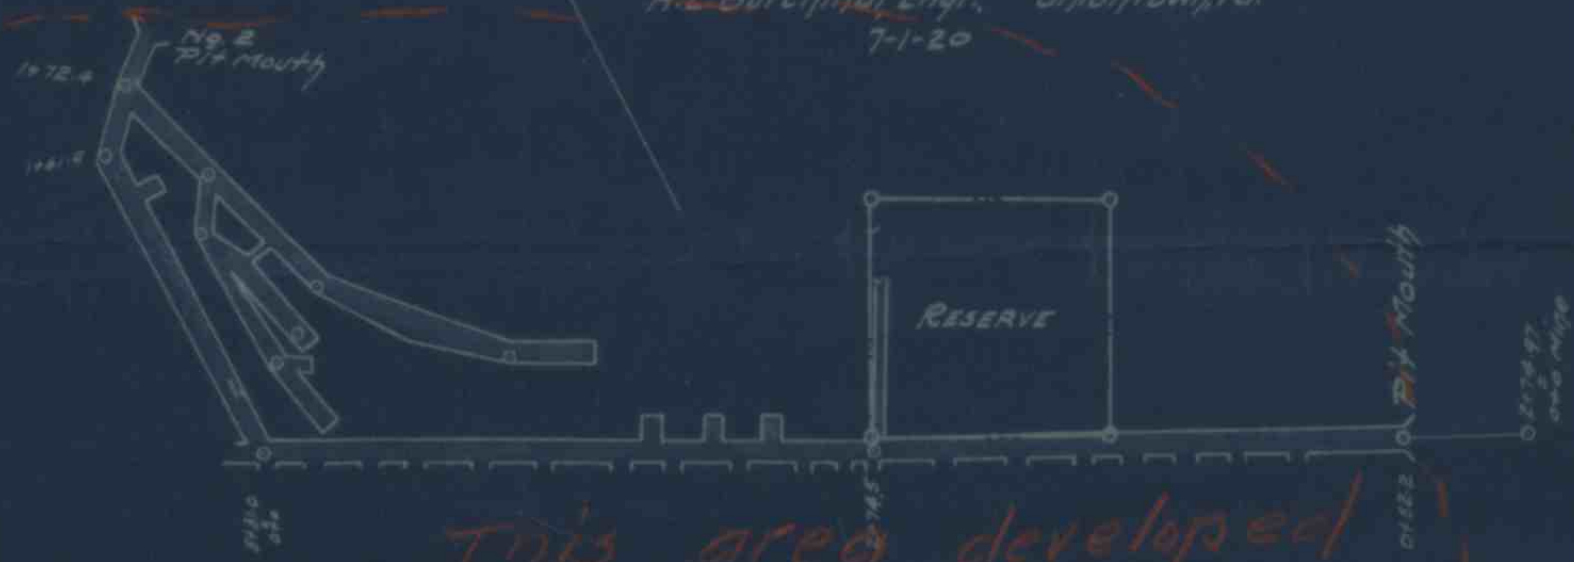
7-1-20