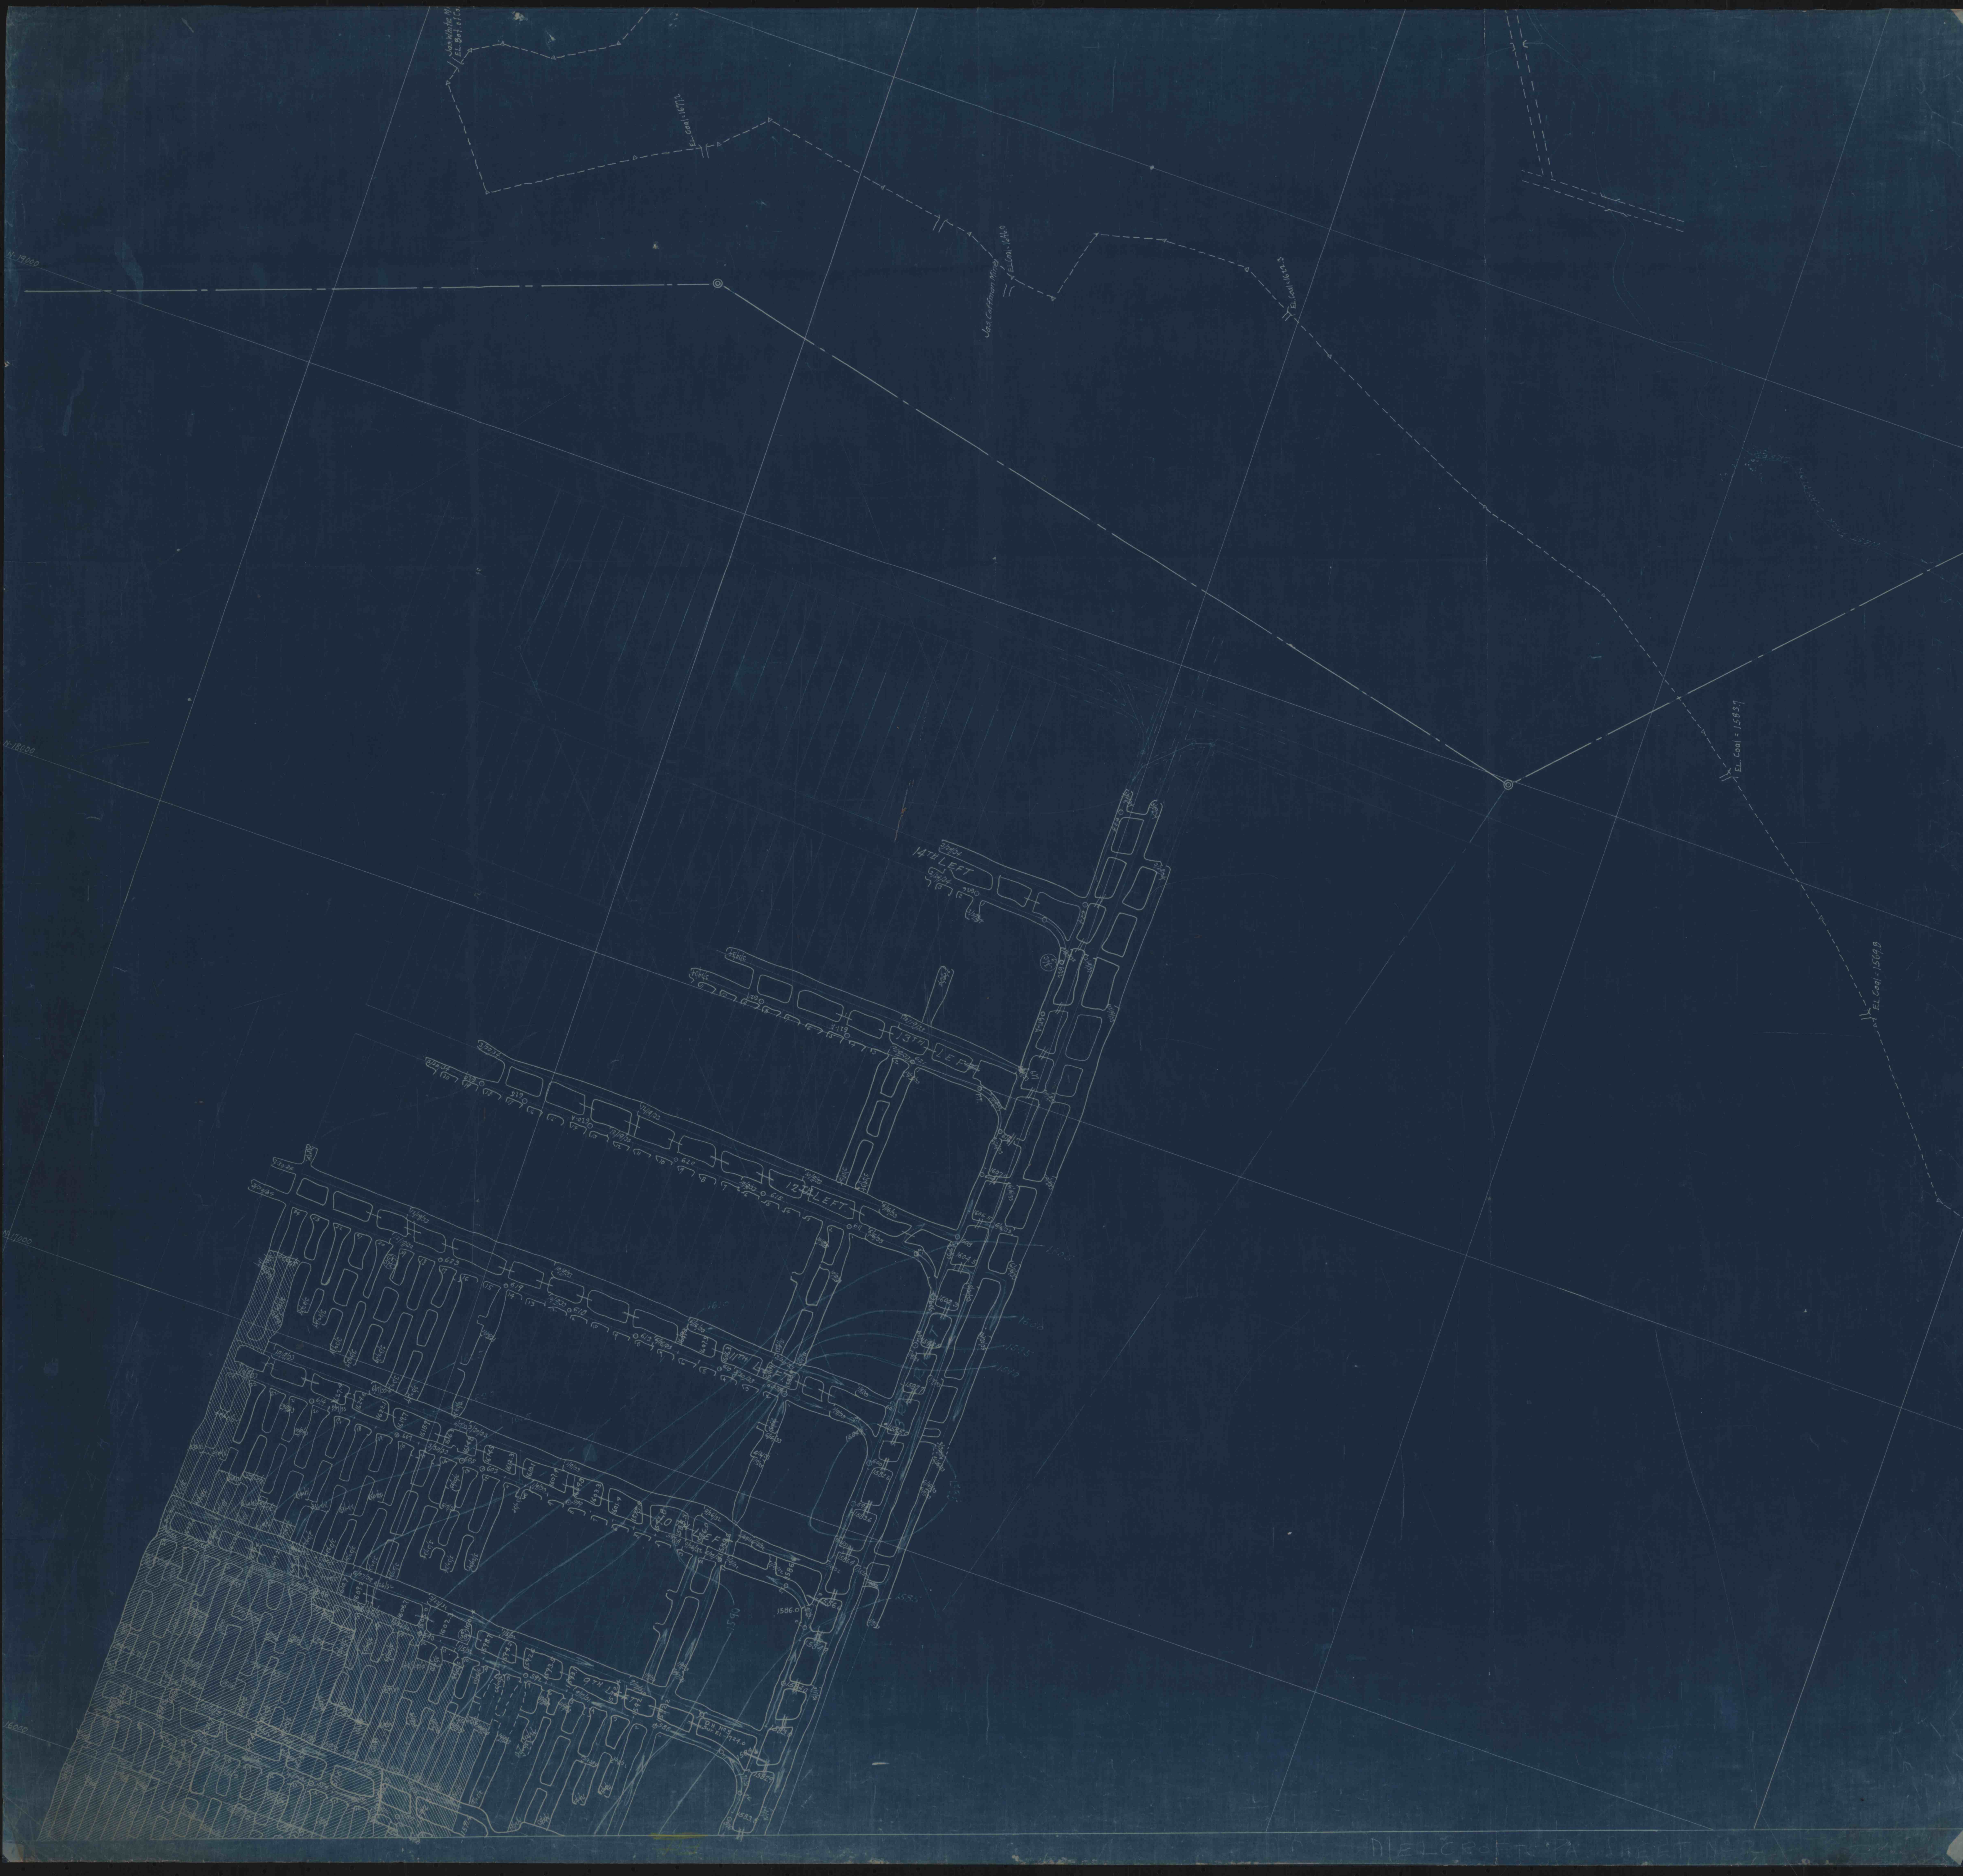
Jas. White Mine
EL. Bot. of Coal
EL. Coal = 1677.2
Jas. Coffman Mine
EL. Coal = 1646.0
EL. Coal = 1622.3
EL. Coal = 1583.7
EL. Coal = 1569.8
N-19000
N-18000
N-17000
16000
14TH LEFT
13TH LEFT
12TH LEFT.
11TH LEFT
O.H. No. 5
Sur. El. 1724.0