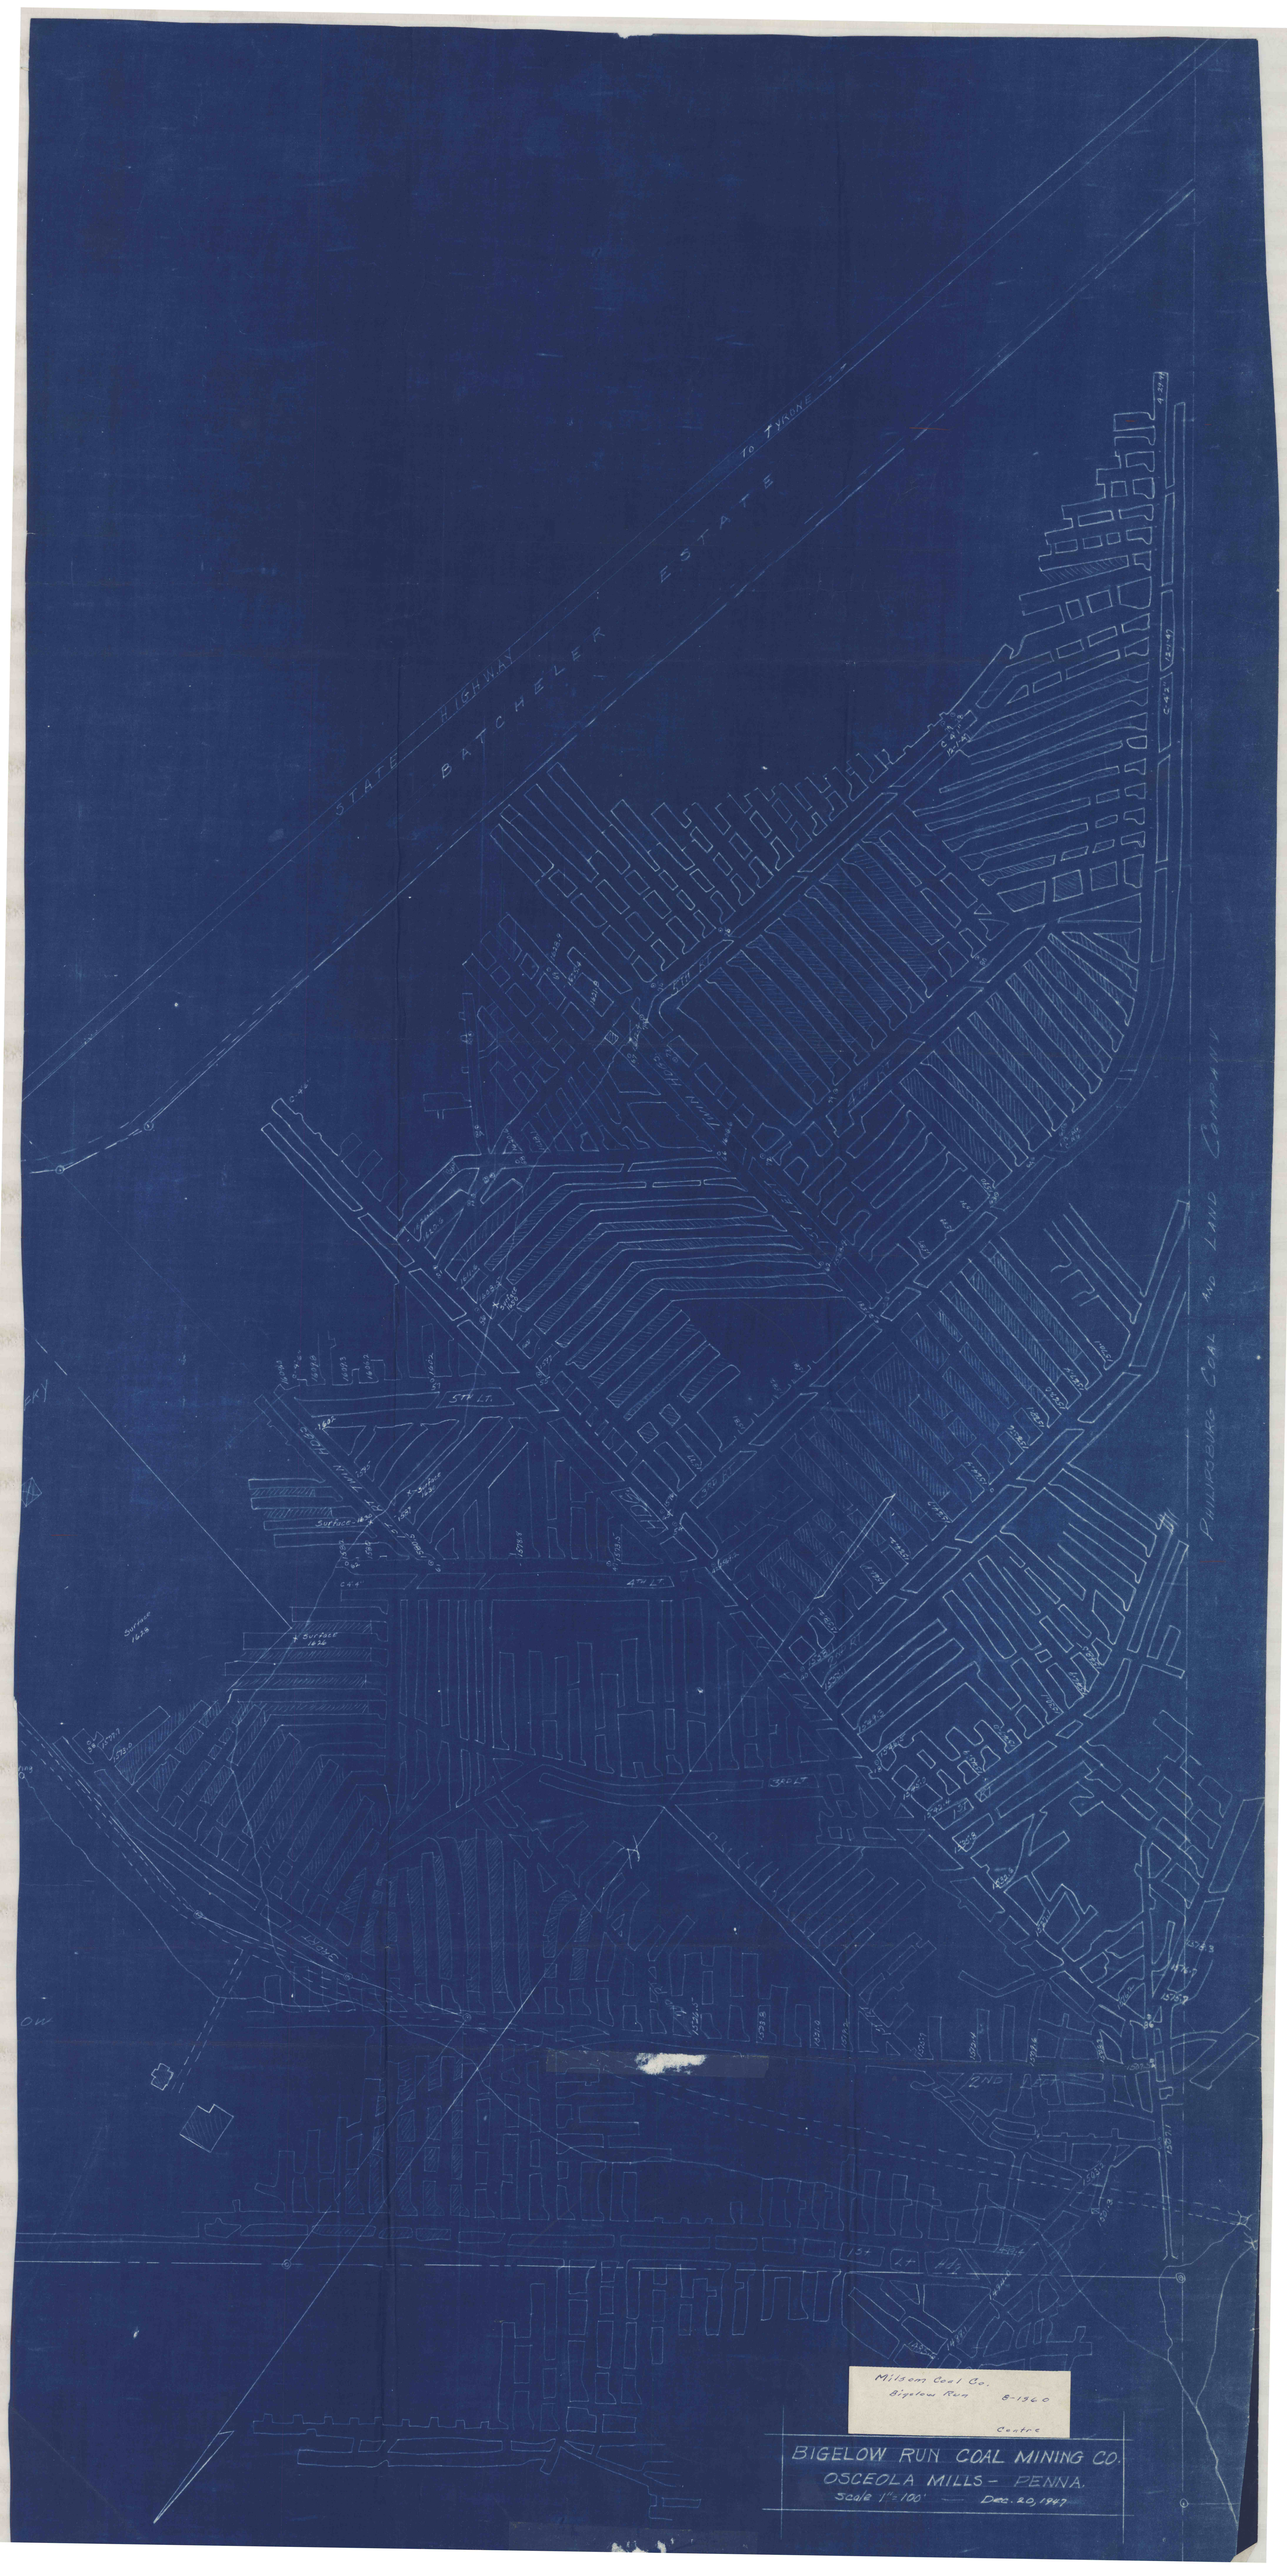
STATE HIGHWAY
BATCHELER ESTATE
PHILIPSBURG COAL AND LAND COMPANY
5TH LT.
4TH LT.
3RD LT.
2ND LT.
1ST LT.
SOUTH MAIN
Surface 1838
Surface 1838
Surface 1838
Milsom Coal Co.
Bigelow Run
B-1960
Centre
BIGELOW RUN COAL MINING CO.
OSCEOLA MILLS - PENNA.
Scale 1" = 100'
Dec. 20, 1947