


E I D A N D H O W L E Y

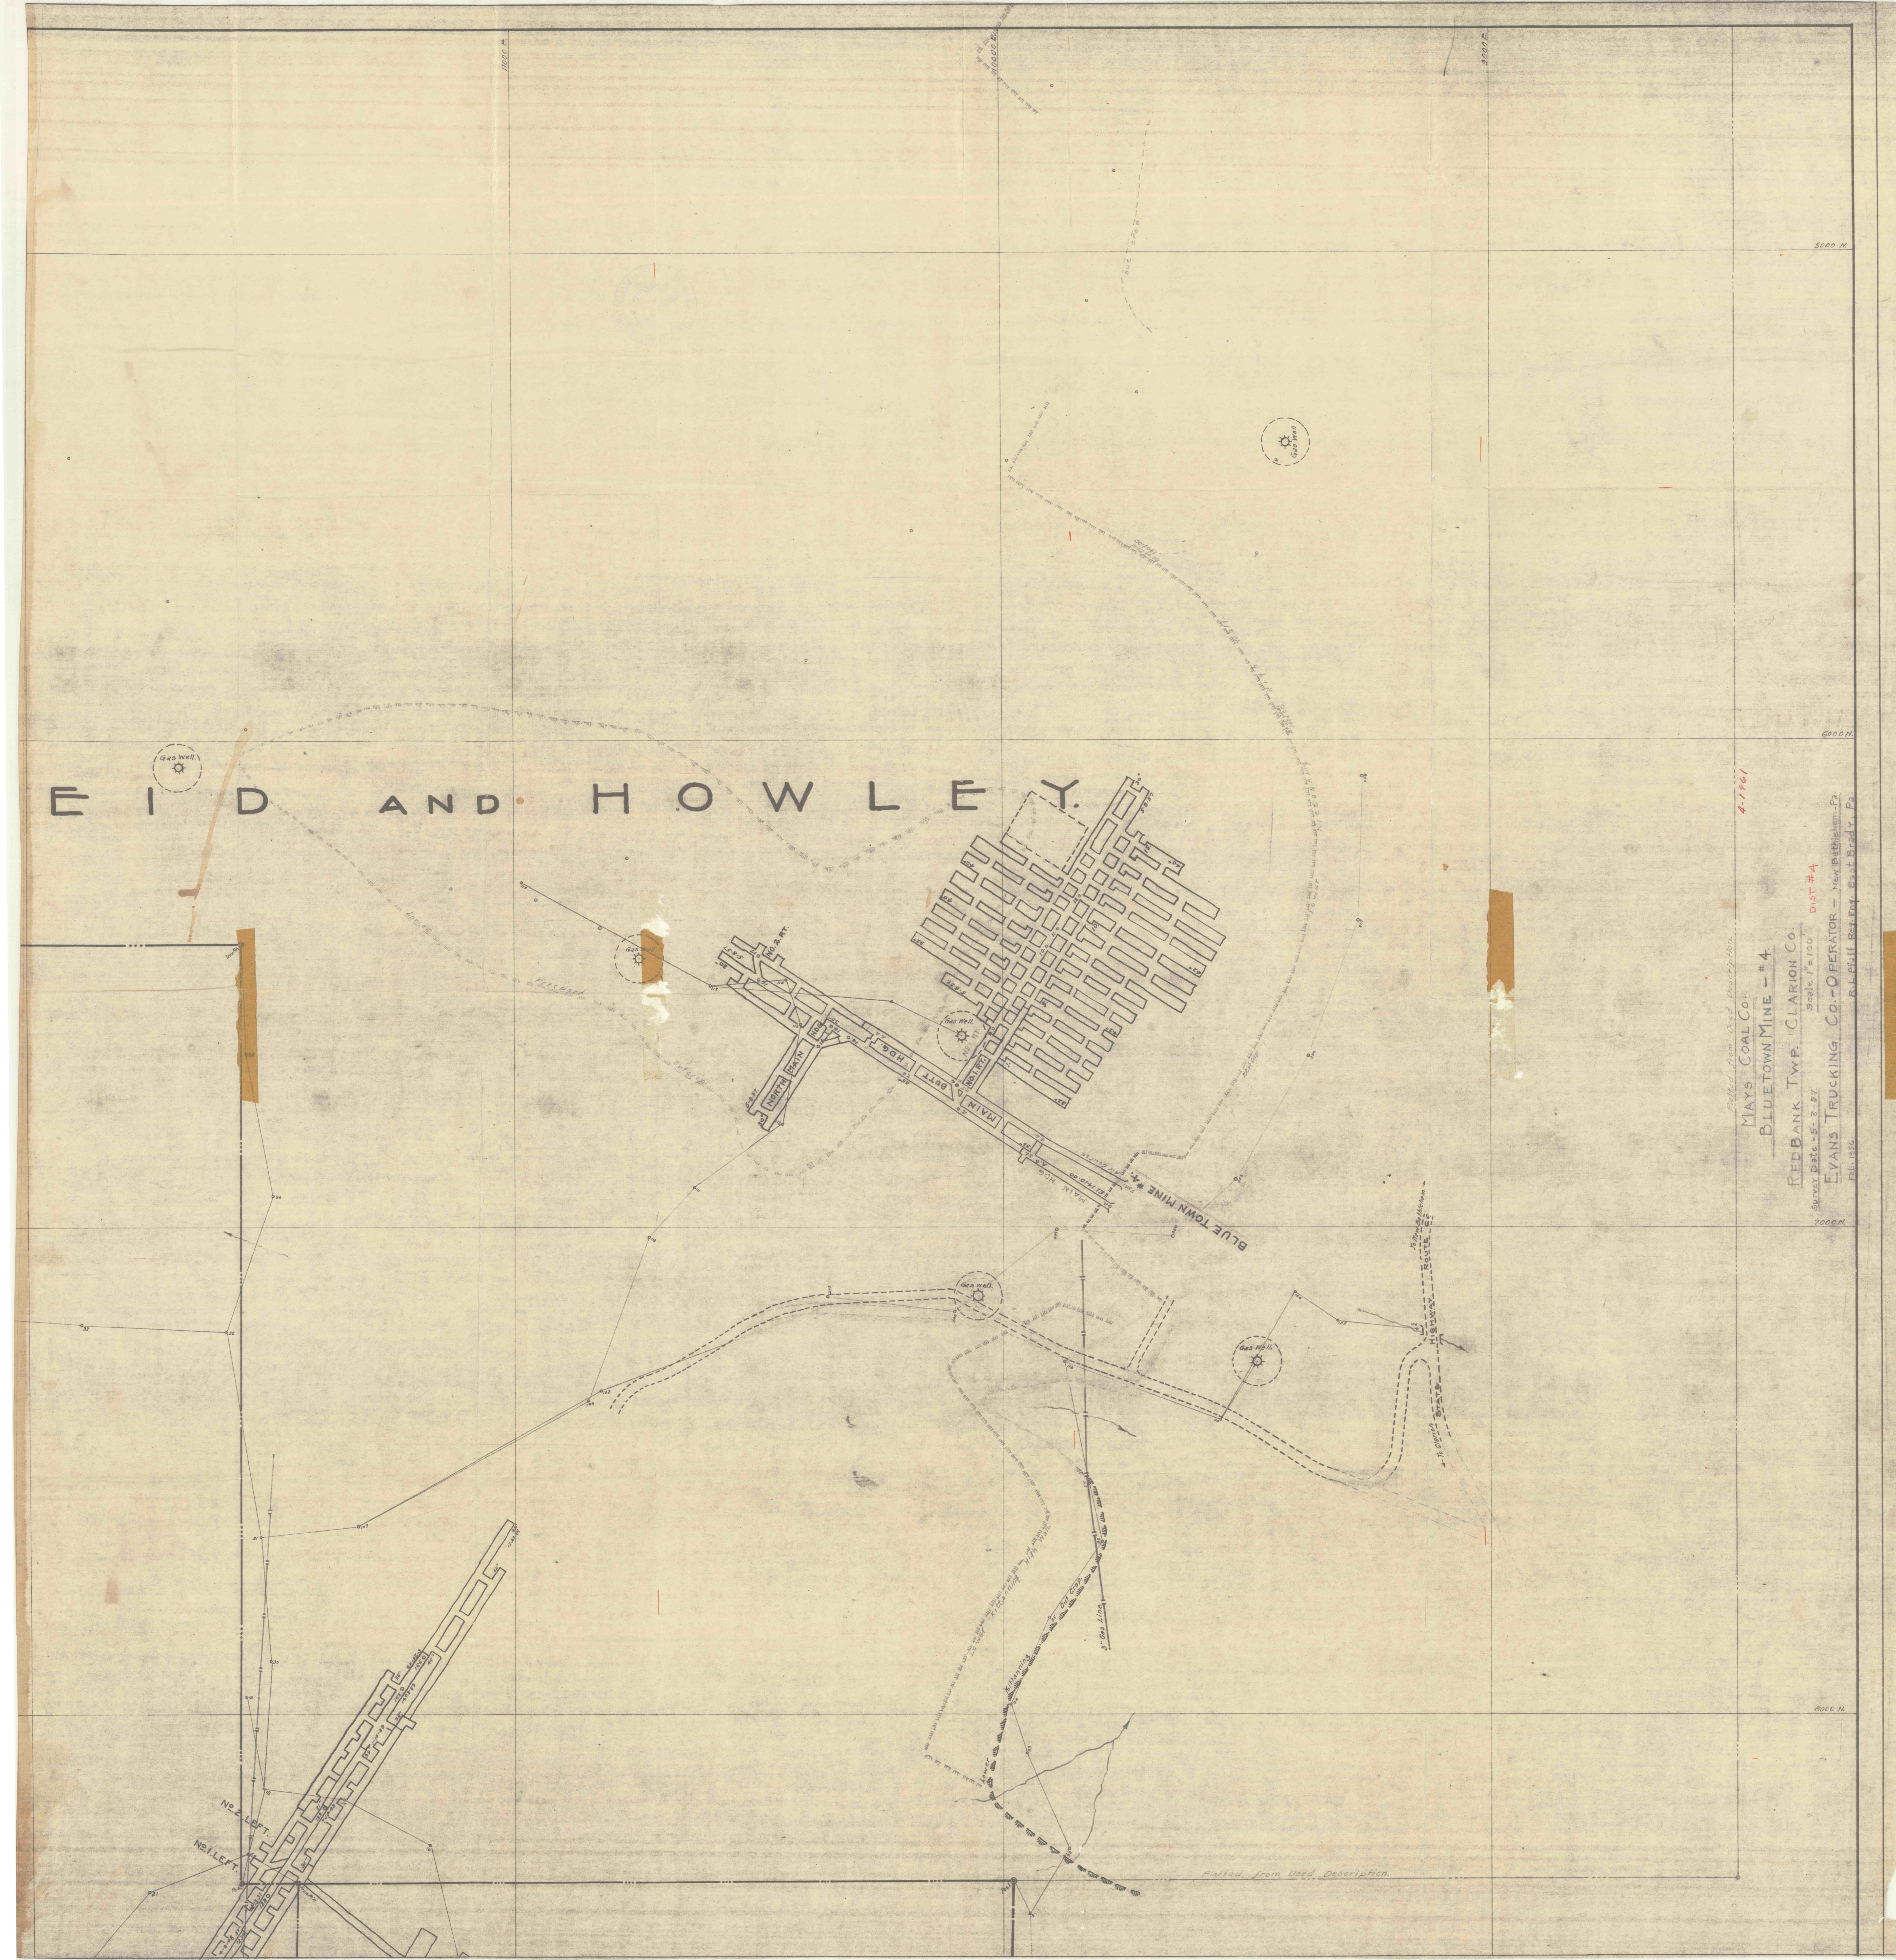

4-1861
MAYS COAL CO.
BLUETOWN MINE - # 4
REDBANK TWP. CLARION CO.
Scale 1" = 100'
Survey Date - 5-8-57 DIST # 4
EVANS TRUCKING CO. - OPERATOR - New Pittsburgh, Pa.
P.L. First Bldg. East Brady, Pa.
Feb. 1956

Platted from Deed Description.