


CULBERTSON AND MYERS COAL CO.  
 LOWER KITTANNING VEIN  
 TOBY TOWNSHIP CLARION COUNTY PENNA.  
 SCALE 1"=100'

SURVEYED JAN 19 1957  
 PROPOSED DEVELOPMENT  
 E. J. MYERS, P.E.  
 1150 Street  
 East Brady, Pa.

REVISED 9-26-57

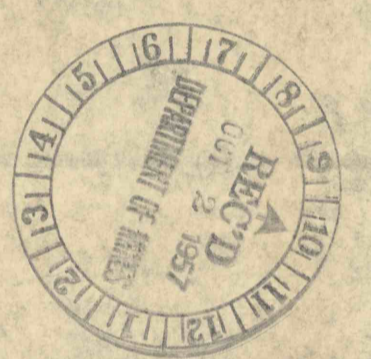

E 11000

E 11000

E 10000

E 10000

N 10000

N 9000

N 8000

N 7000

N 10000

N 9000

N 8000

N 7000

2551 TT-10