



STATE
GAME
LANDS

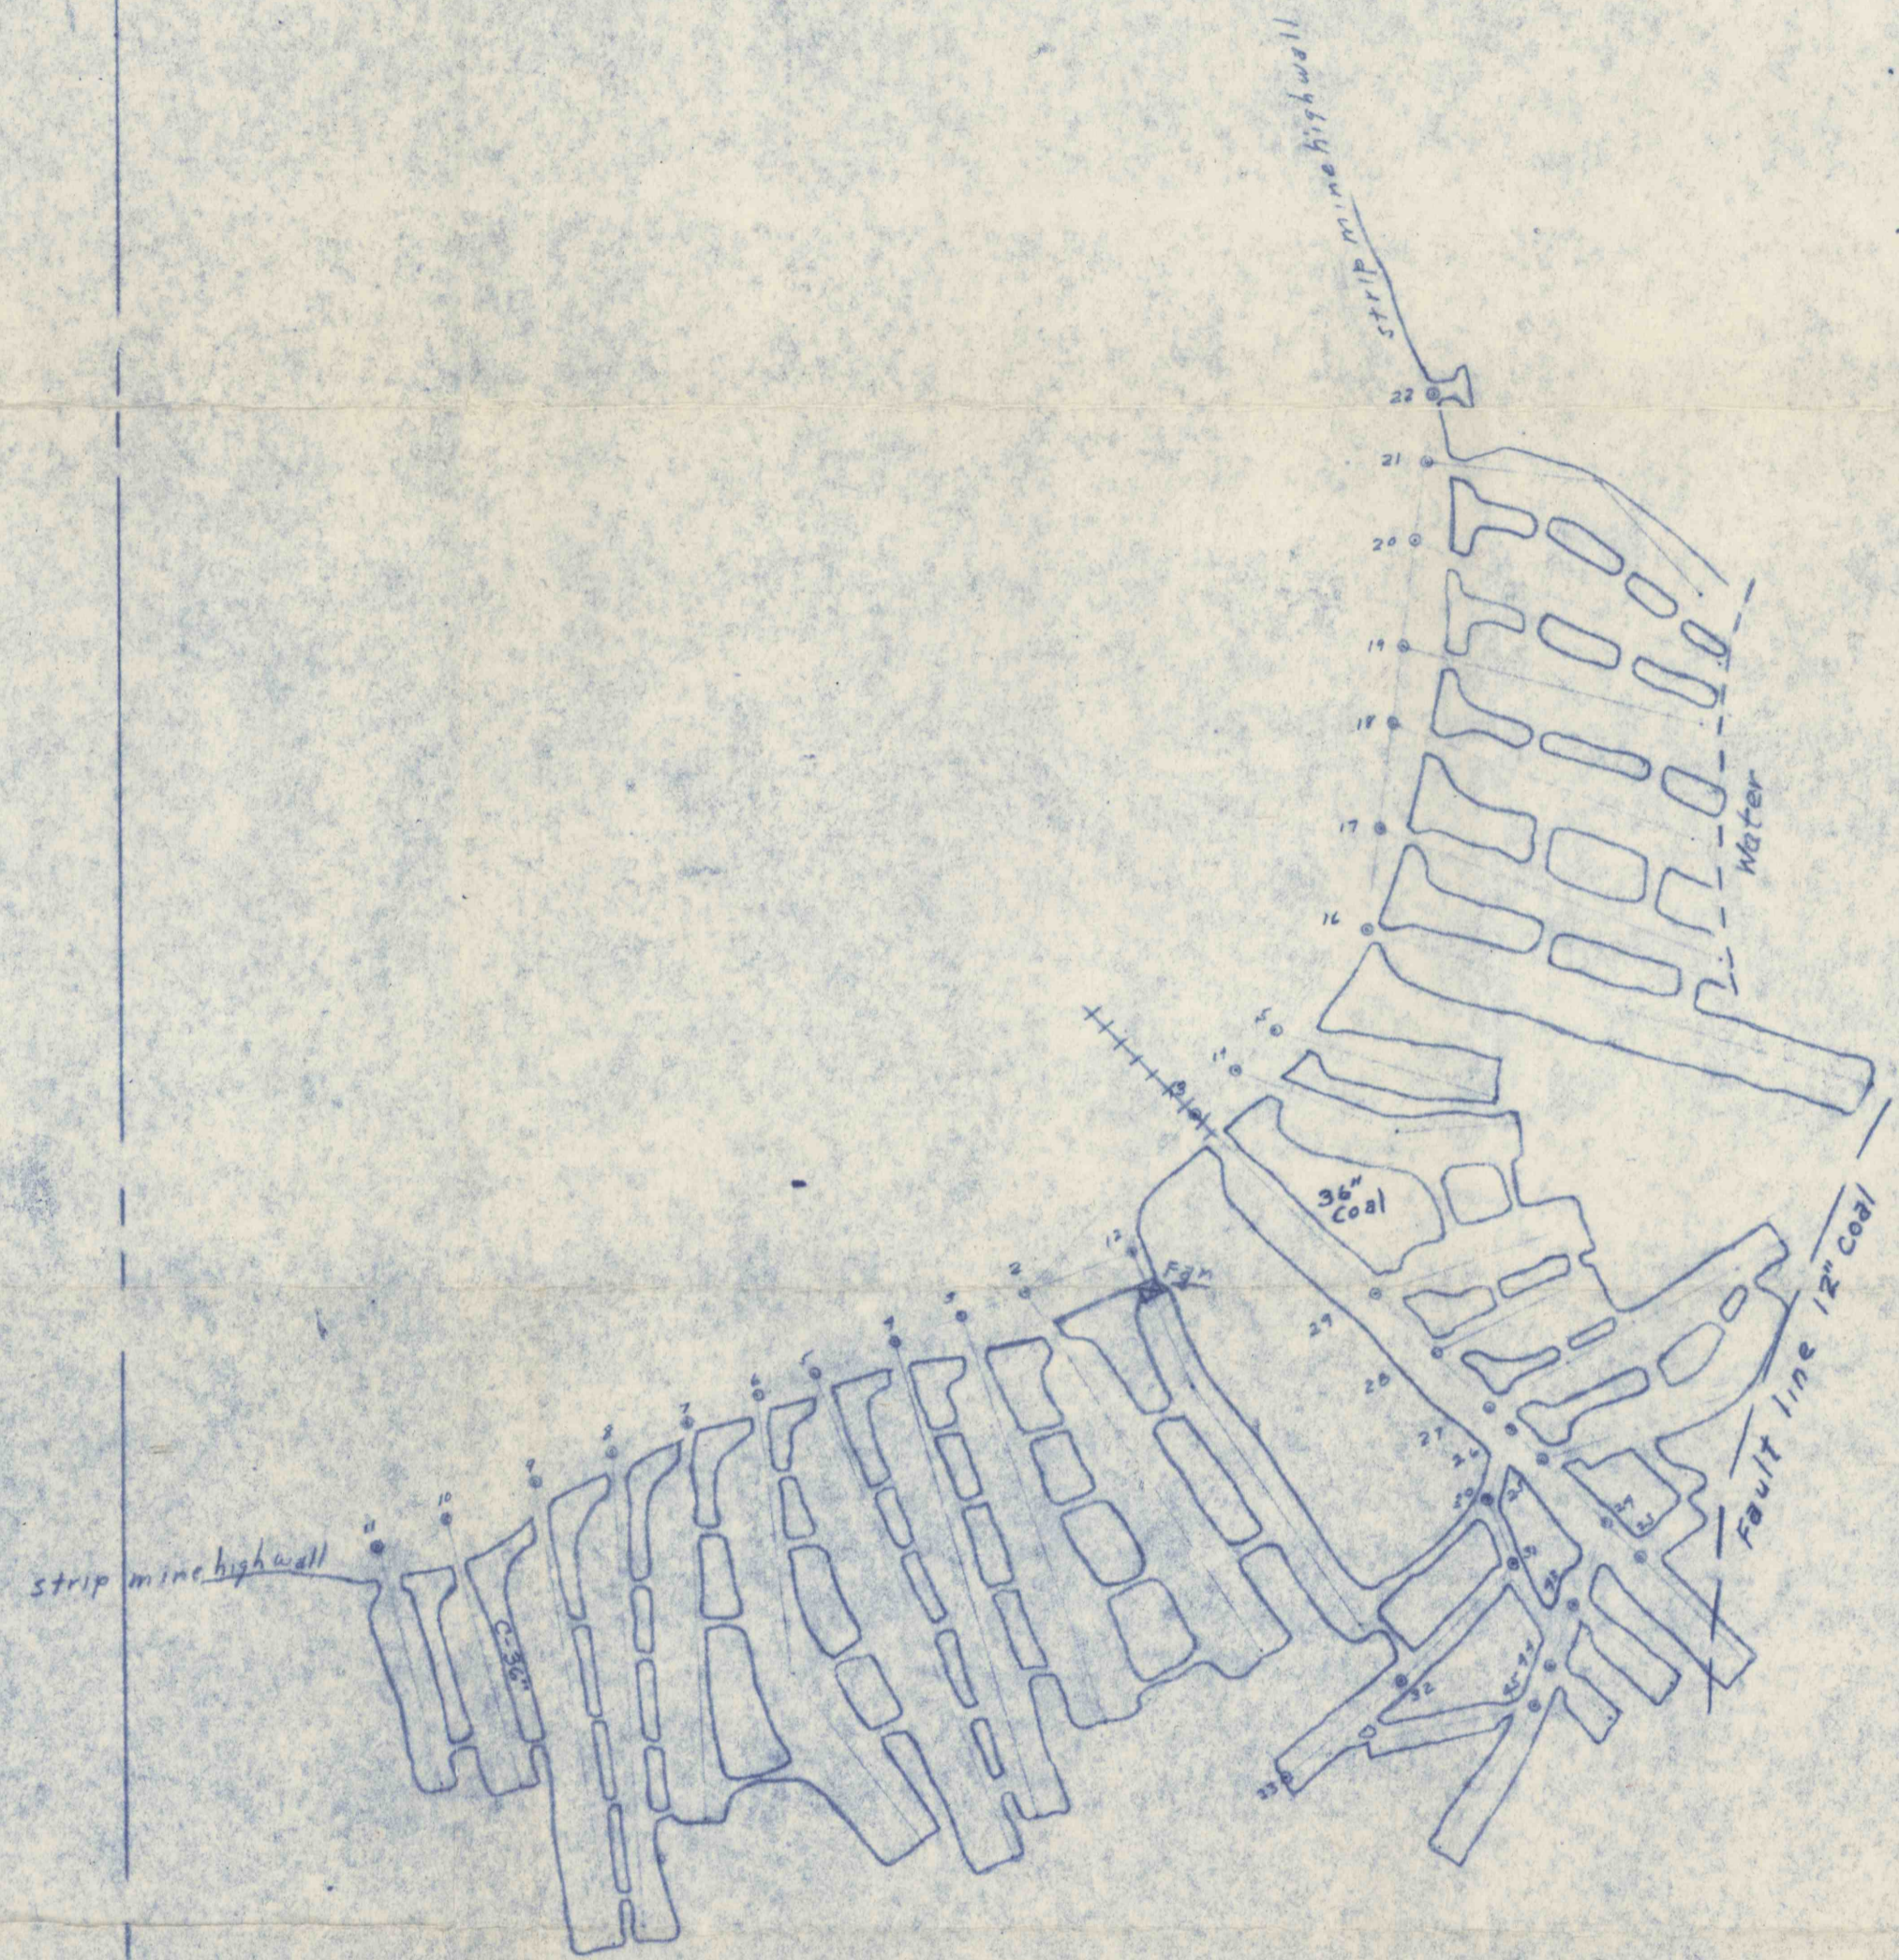

LITKE AND HESS
FISHER WARRANT

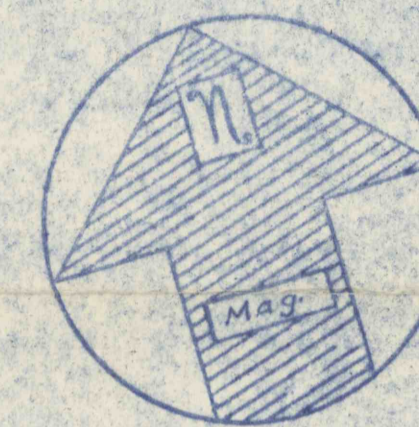

Survey Dates
1. 7-6-56
2.

H. AND R. COAL CO.
SNOW SHOE, PA.

Plot of Survey of Deep Mine
Operations in "A" Seam in Snow
Shoe Twp. Centre Co. Pa.

SCALE: 1" = 100' DATE: 7-13-56 DRAWN BY: *W.S.M.*

ALLEN G. BUTLER
PROFESSIONAL ENGINEER NO. 30037