
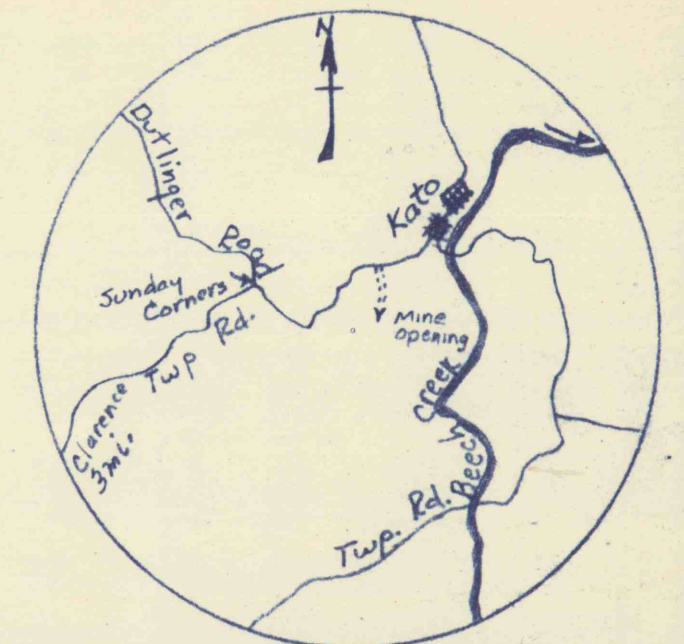


PA. DEPT. OF FORESTS & WATERS SURFACE  
RIVER HILL COAL CO. COAL

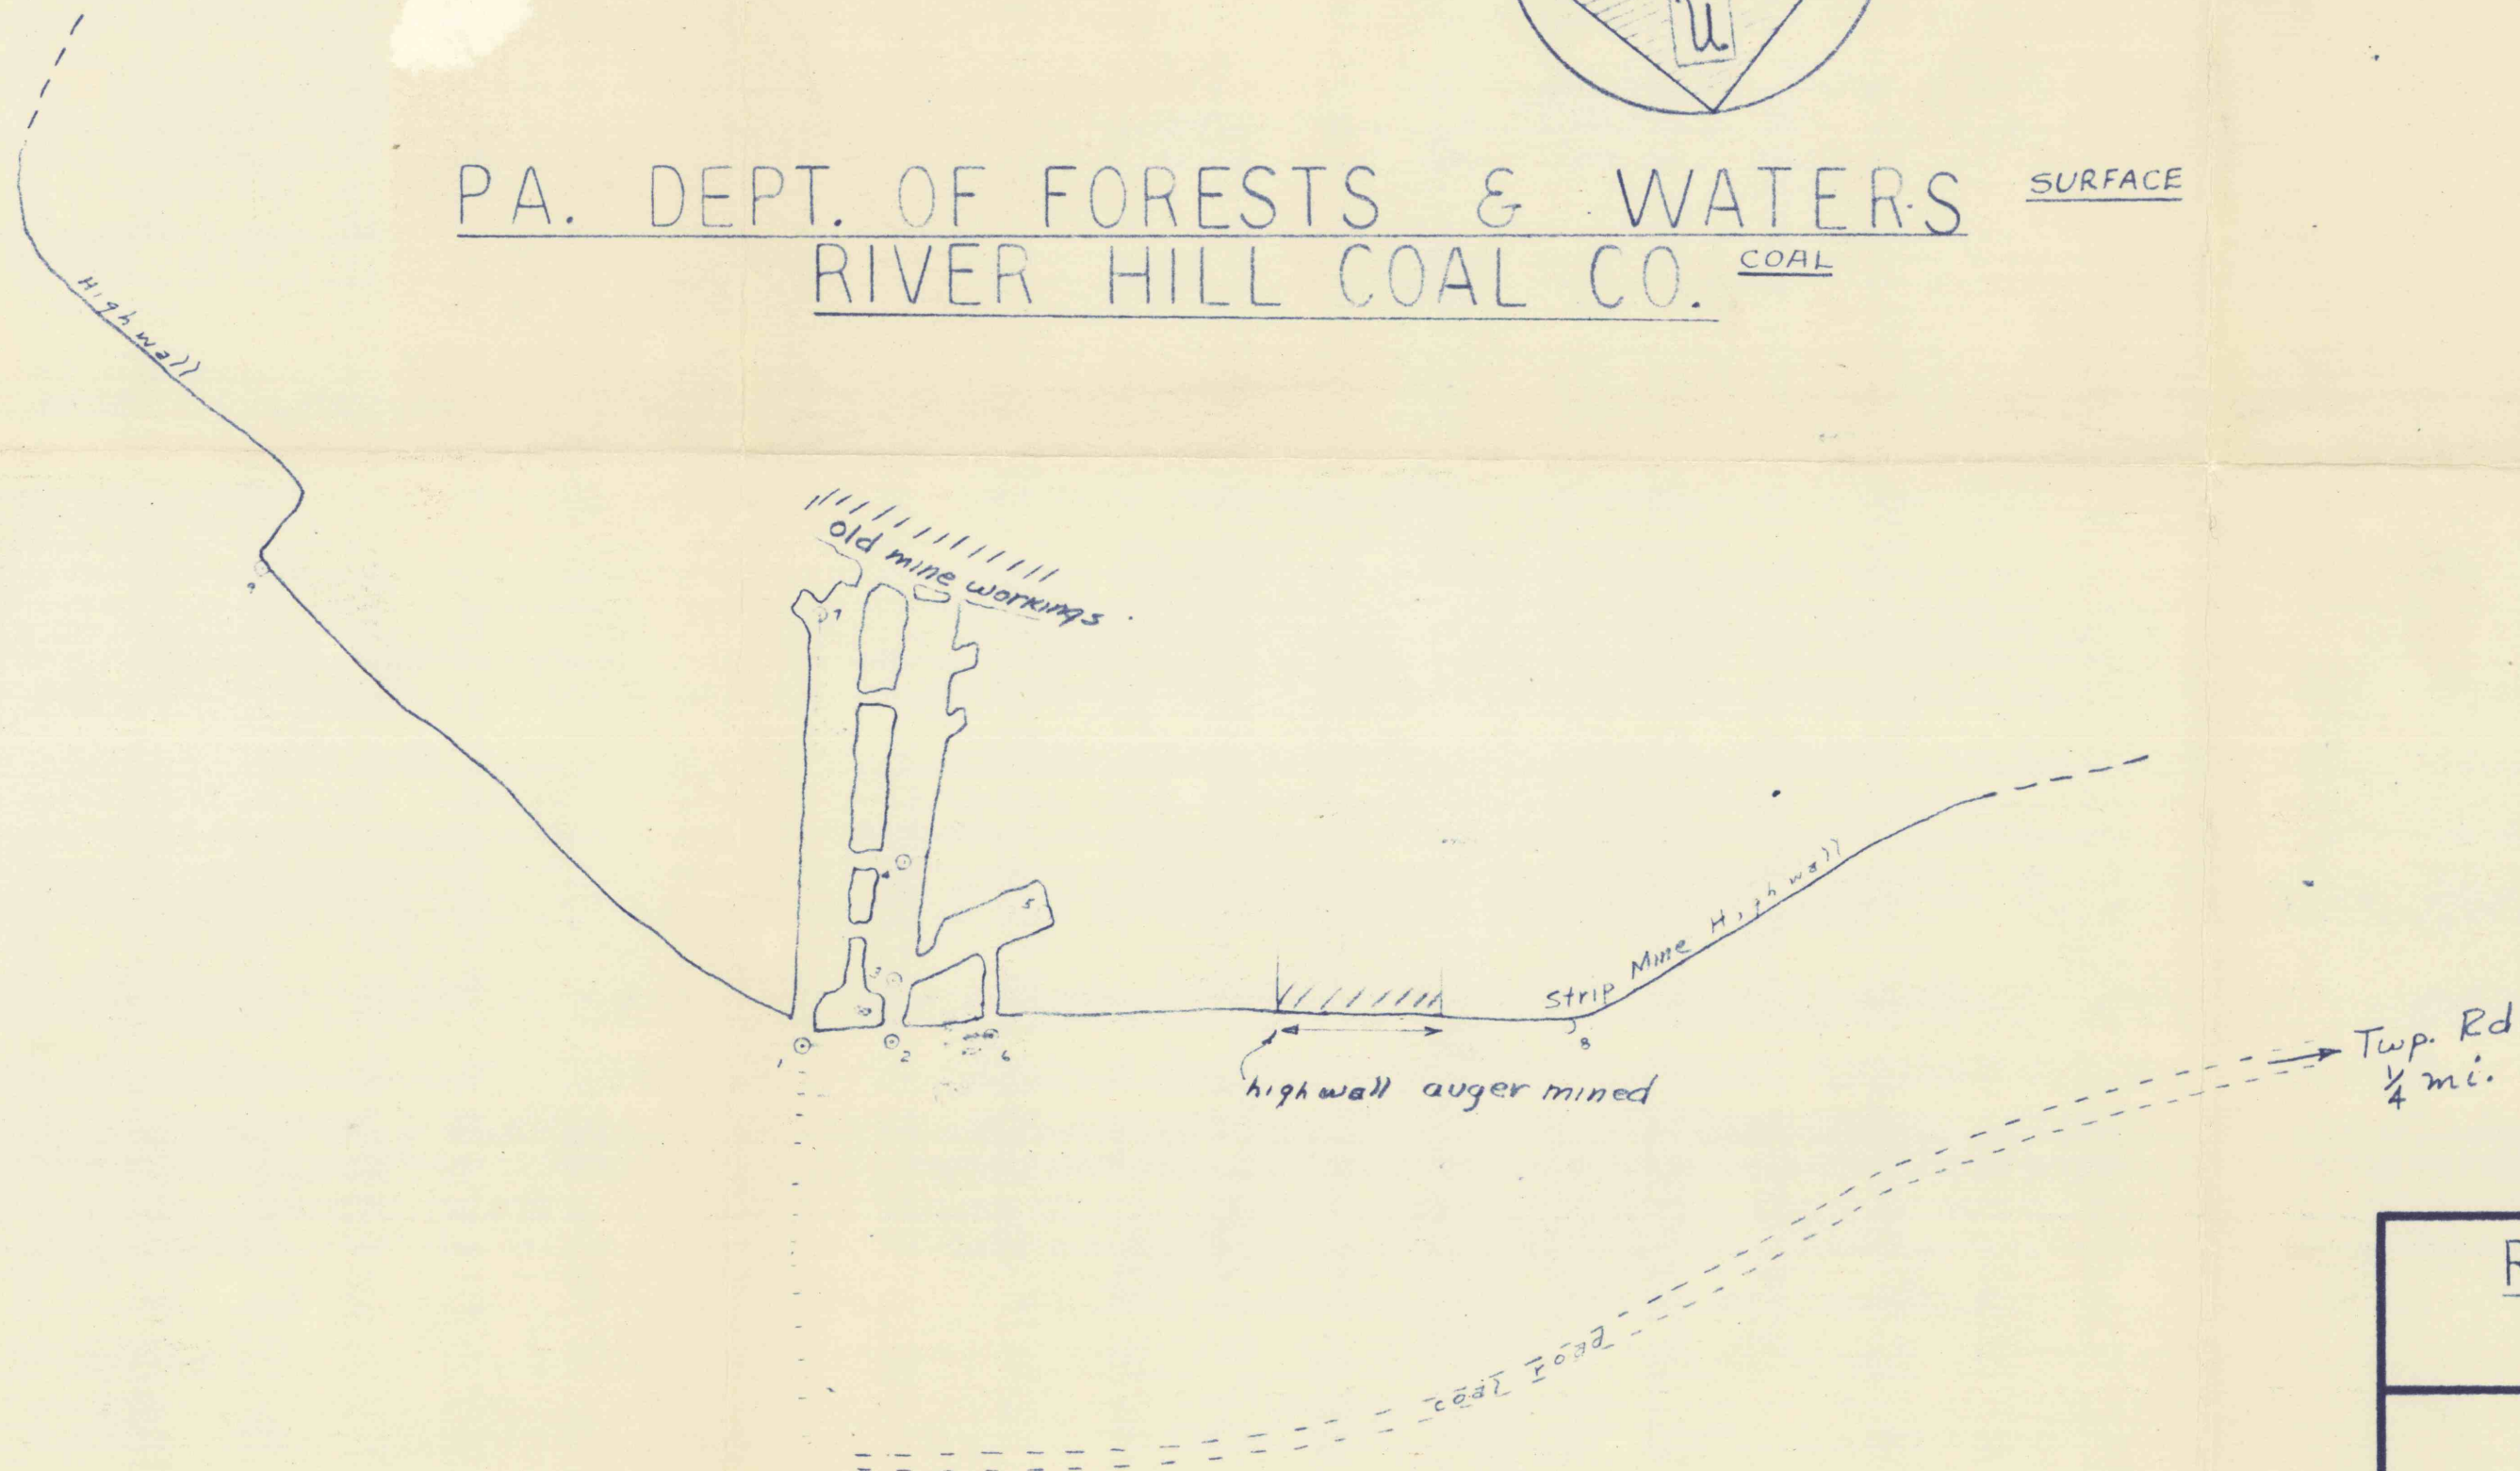

Location Map

RIVER HILL COAL CO.  
KYLERTOWN, PA.

Kato Deep Mine *Dist. 8*  
Snow Shoe Twp. Centre Co. Pa.

SCALE: 1" = 100'	DATE: 10-11-57	DRAWN BY: W.S.M.
ALLEN G. BUTLER PROFESSIONAL ENGINEER		NO. 40091

