


APPLY LINE LEASE

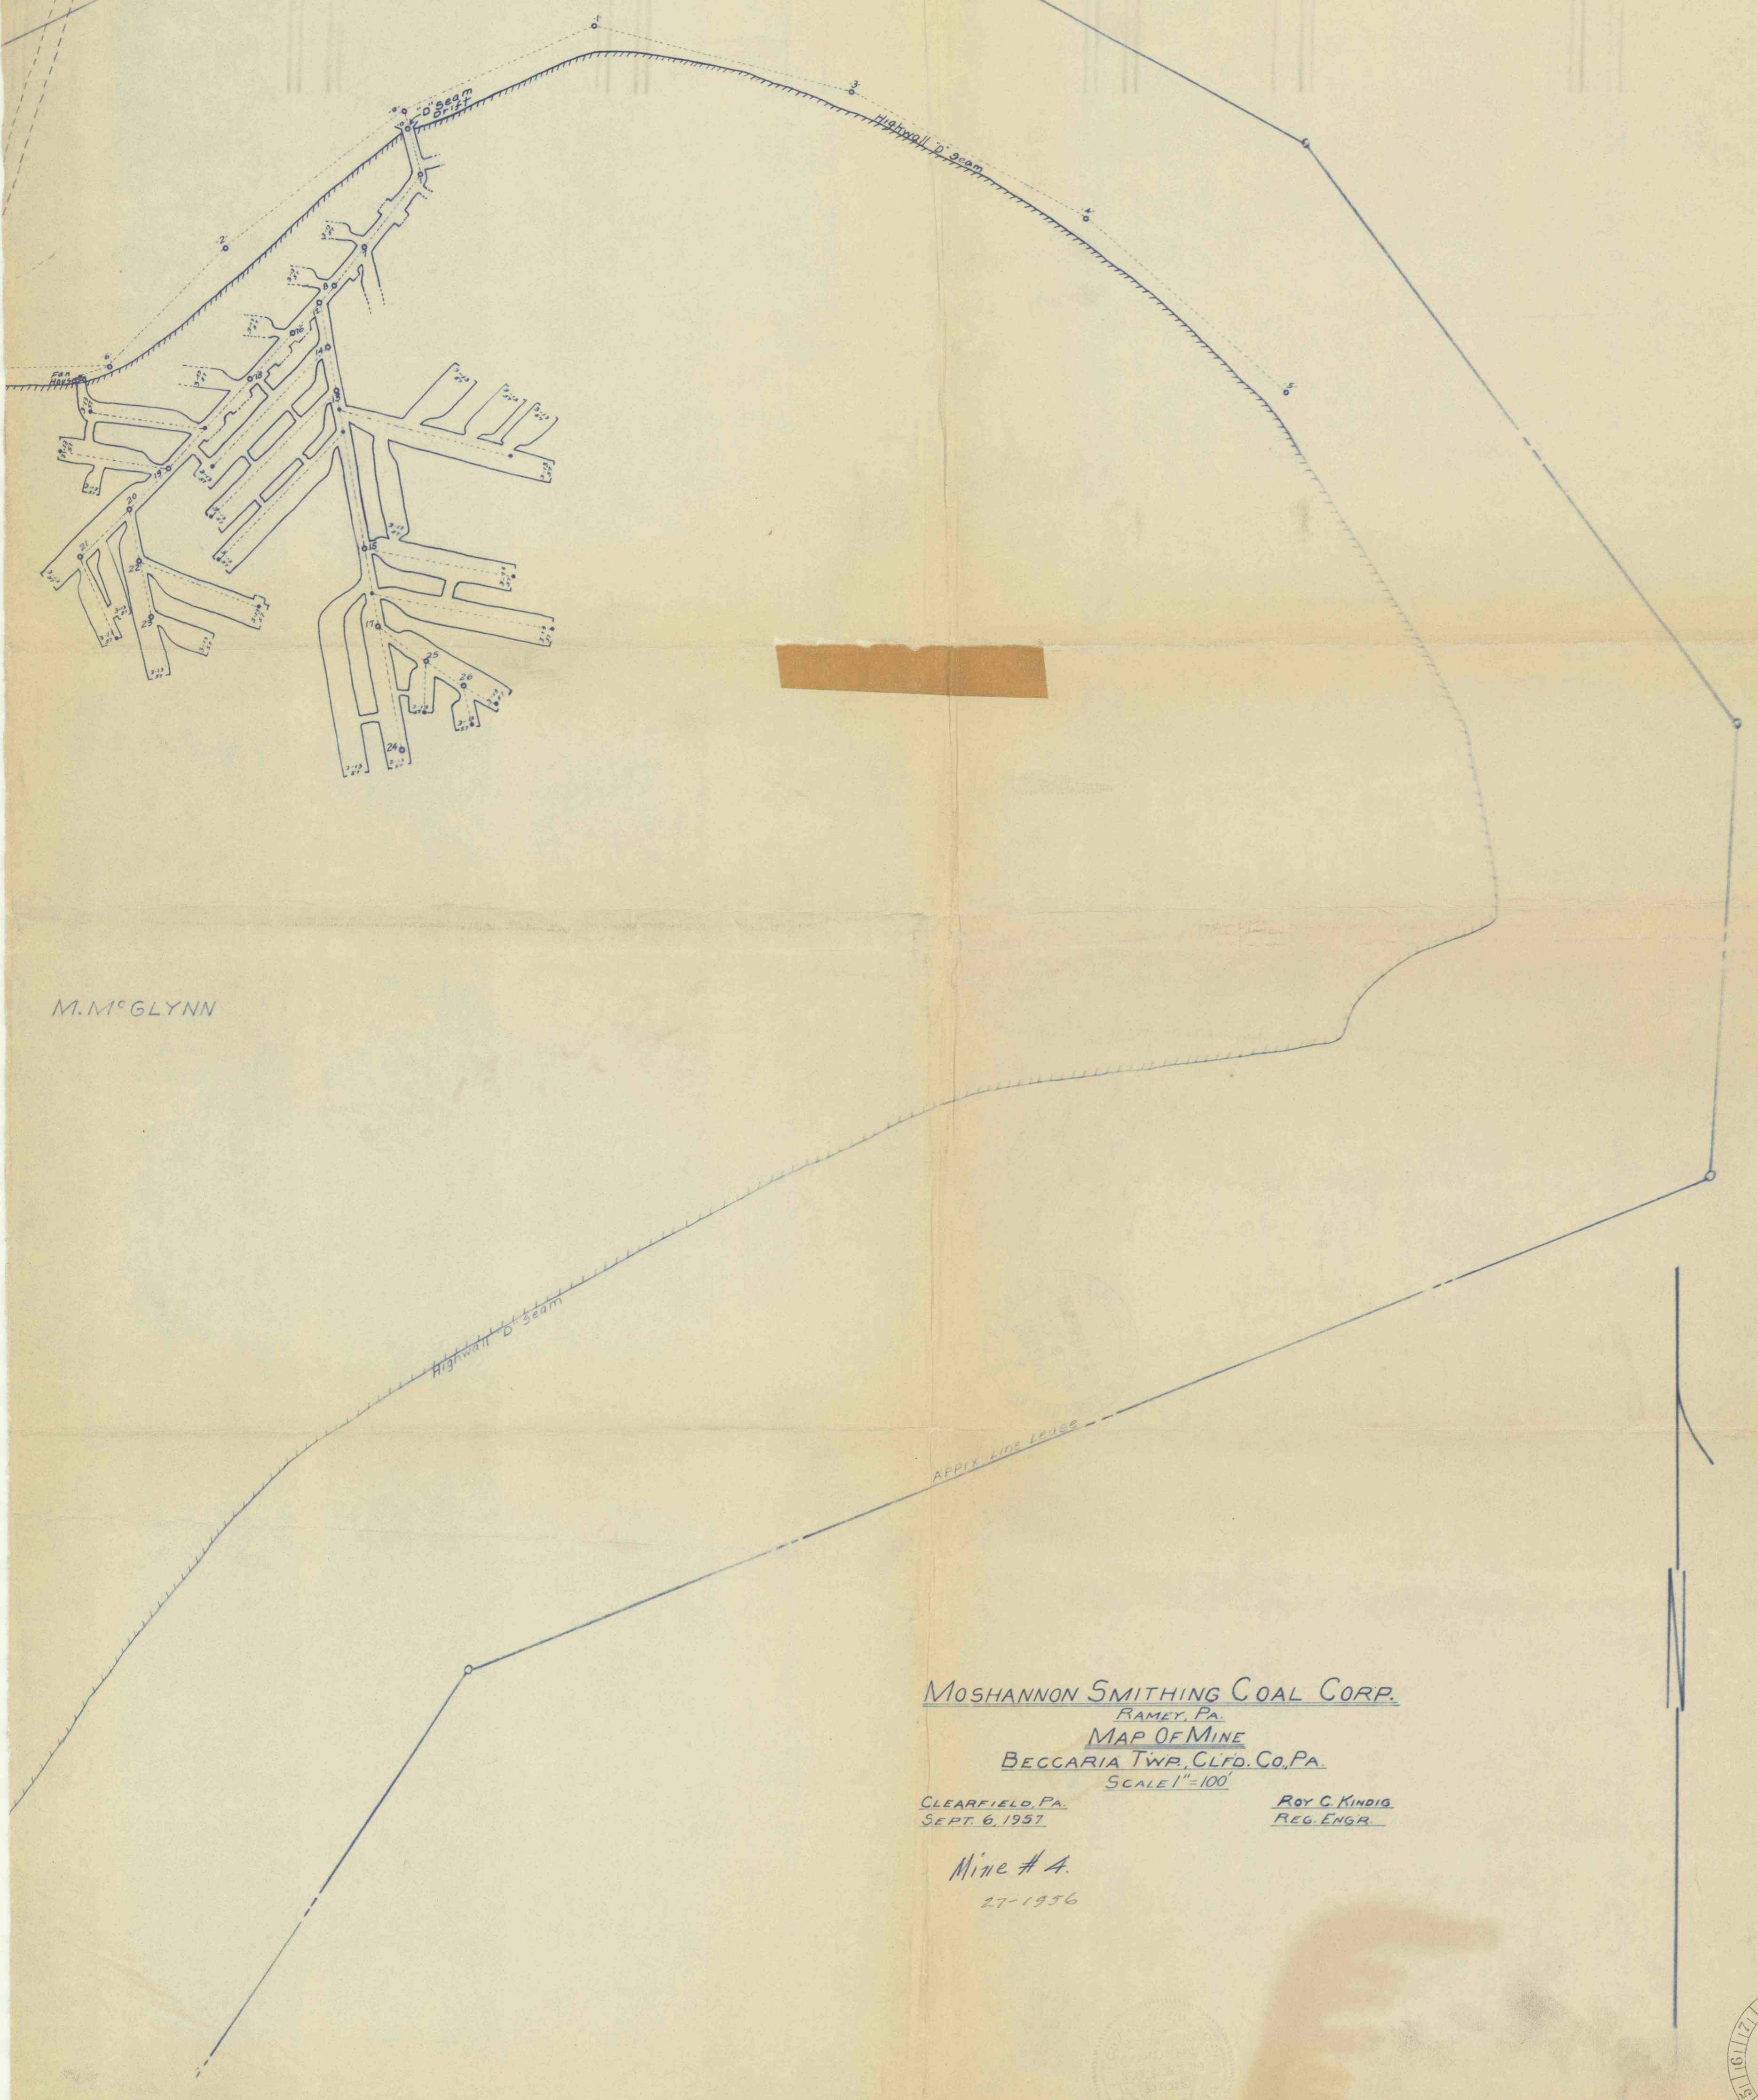

M. M^cGLYNN

MOSHANNON SMITHING COAL CORP.
 RAMEY, PA.
 MAP OF MINE
 BECCARIA TWP., CLFD. CO., PA.
 SCALE 1"=100'

CLEARFIELD, PA.
 SEPT. 6, 1957.

ROY C. KINDIG
 REG. ENGR.

Mine # 4.
 27-1956

RECEIVED
 SEP 8 1957
 DEPARTMENT OF REVENUE
 1958