




FIELD COPY

VENTURINI BROTHERS MINE
 IN UPPER FREEPORT SEAM
 ALLEGHENY TWP-WESTMORLAND CO-PA
 SCALE 1 INCH=100 FEET-SEPT.23, 1955

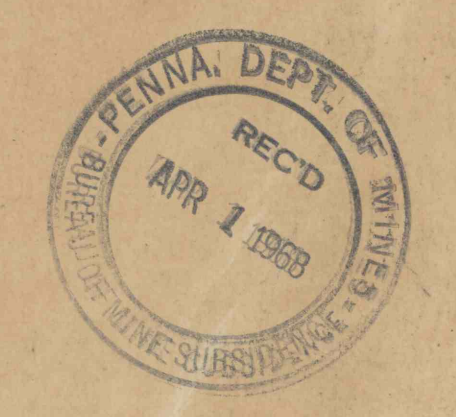

DATA ON THIS MAP FROM SURVEYS BY THE CRICHTON CO.ENGRS.
 GEORGE S. BATON & CO. AND D.E.TAYLOR, REG.ENGR.

CHARLES S. KLINGENSMITH
 R.P.S.No.228E

LEGEND:
 PROPERTY OUTLINE RED
 SIX MONTH PROJECTION GREEN
 MINING COMPLETED BLUE

REVISED TO 3-25-68
 3-25-68 TO 9-25-68