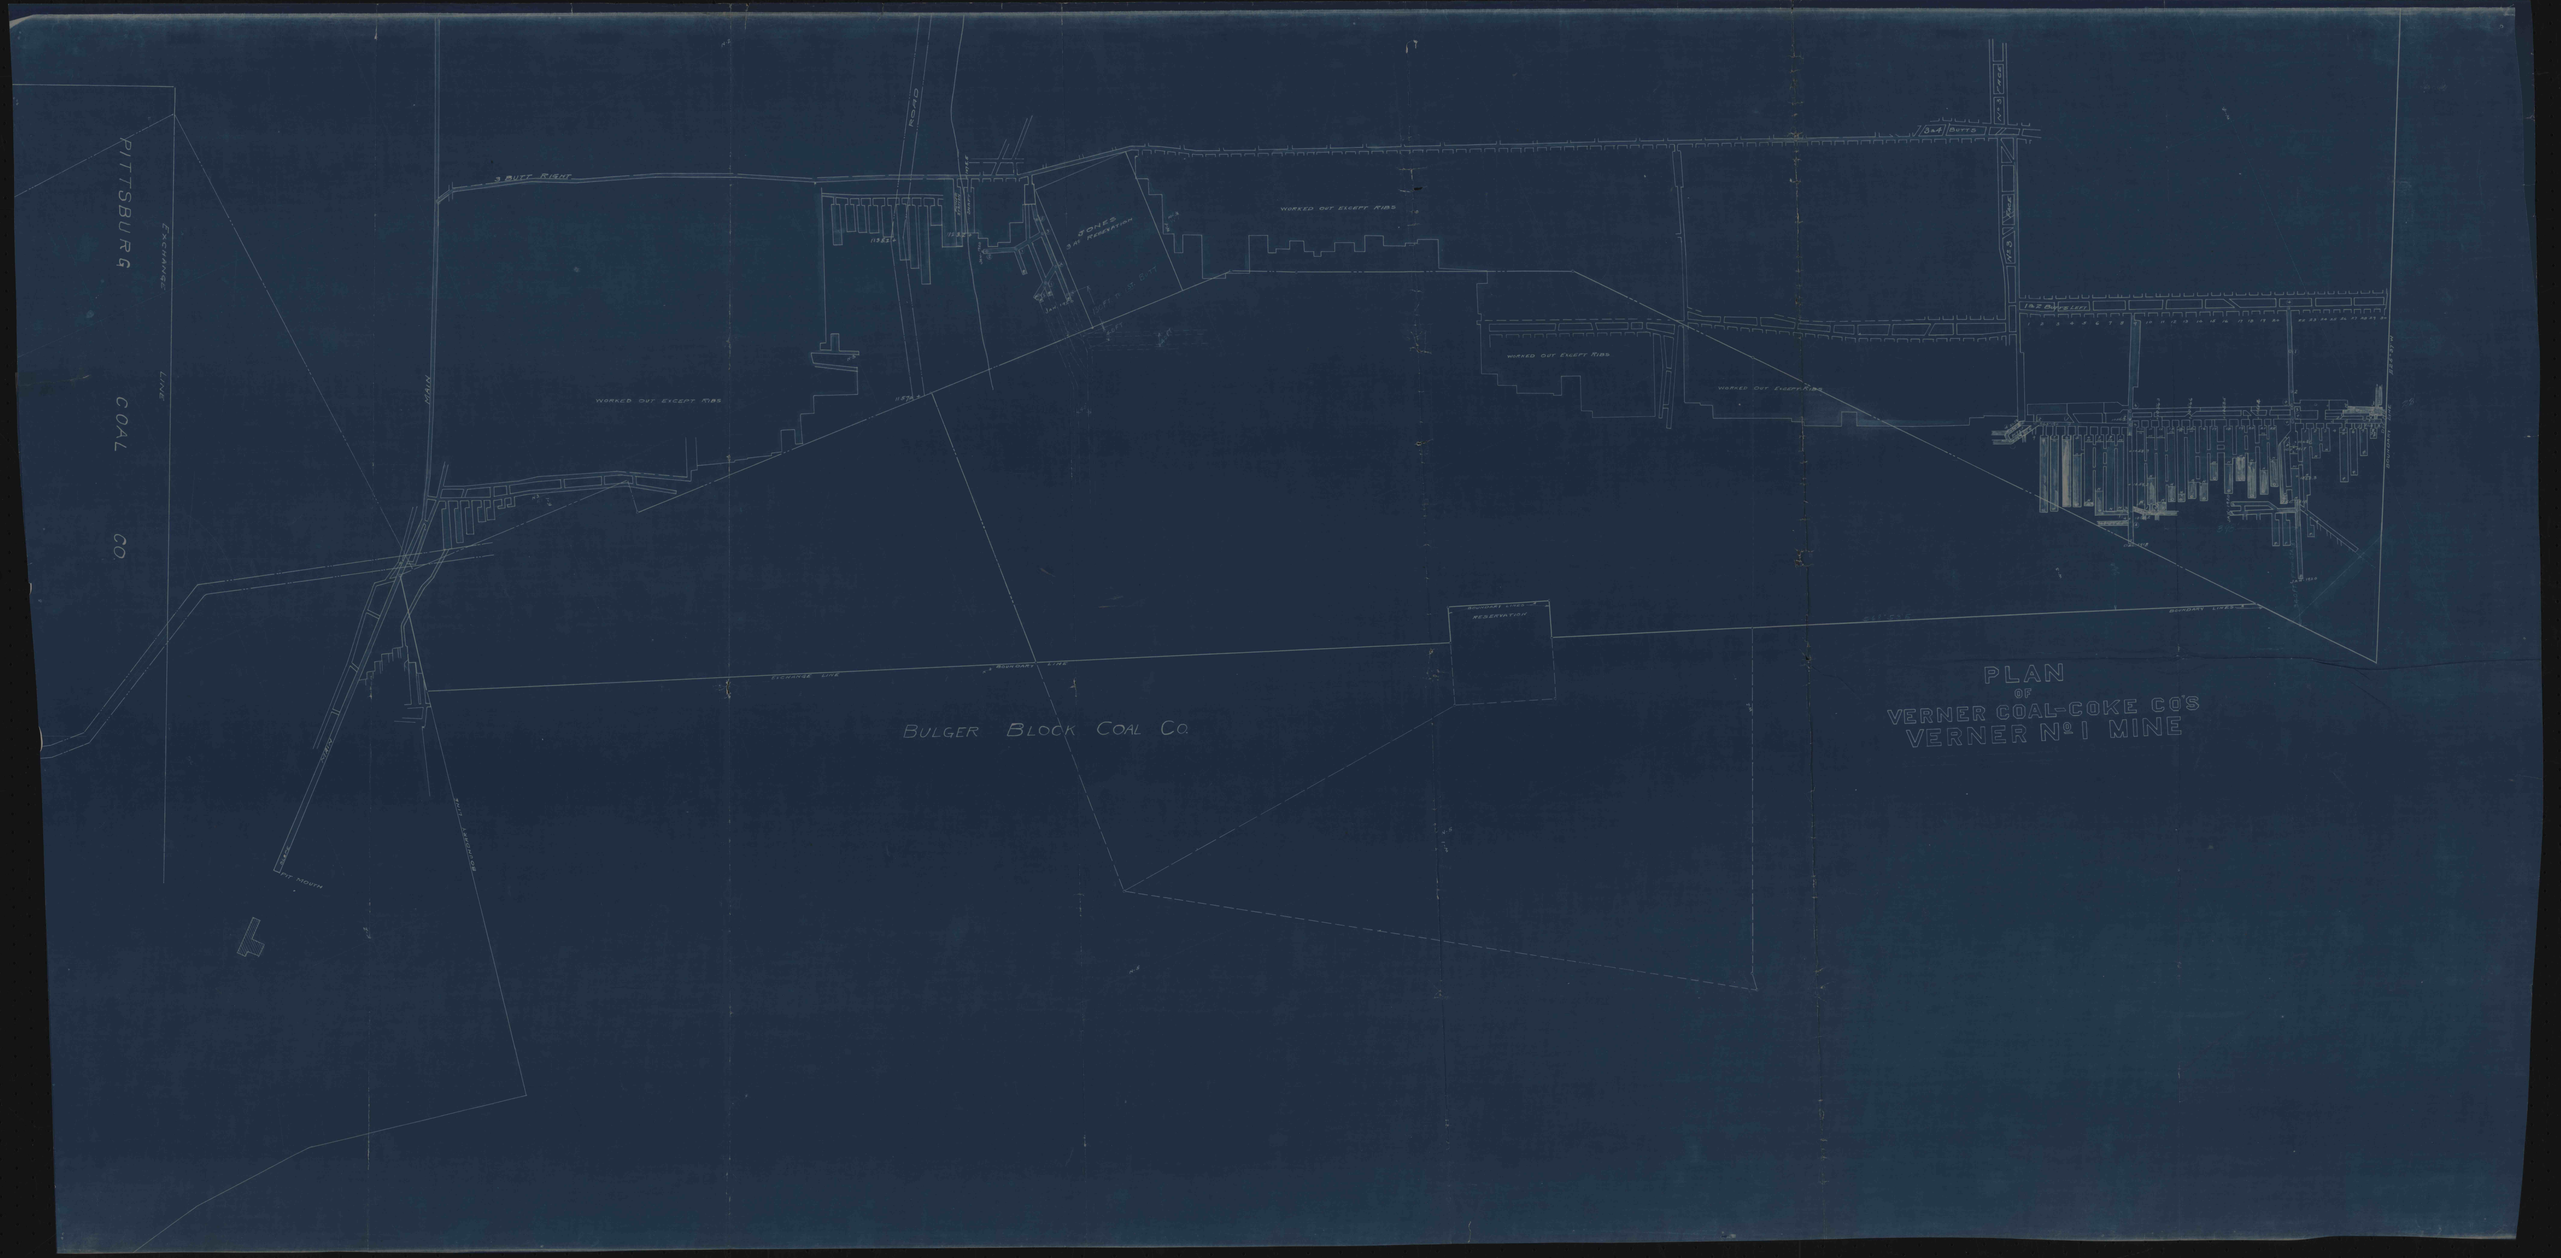
PITTSBURG COAL CO.
EXCHANGE LINE
3 BUTT RIGHT
ROAD
WORKED OUT EXCEPT RIBS
3 JONES 3 AIR RESERVATION
WORKED OUT EXCEPT RIBS
WORKED OUT EXCEPT RIBS
WORKED OUT EXCEPT RIBS
3 BUTTS
BOUNDARY LINES RESERVATION
EXCHANGE LINE
BULGER BLOCK COAL CO.
PLAN
OF
VERNER COAL-COKE CO'S
VERNER No. 1 MINE