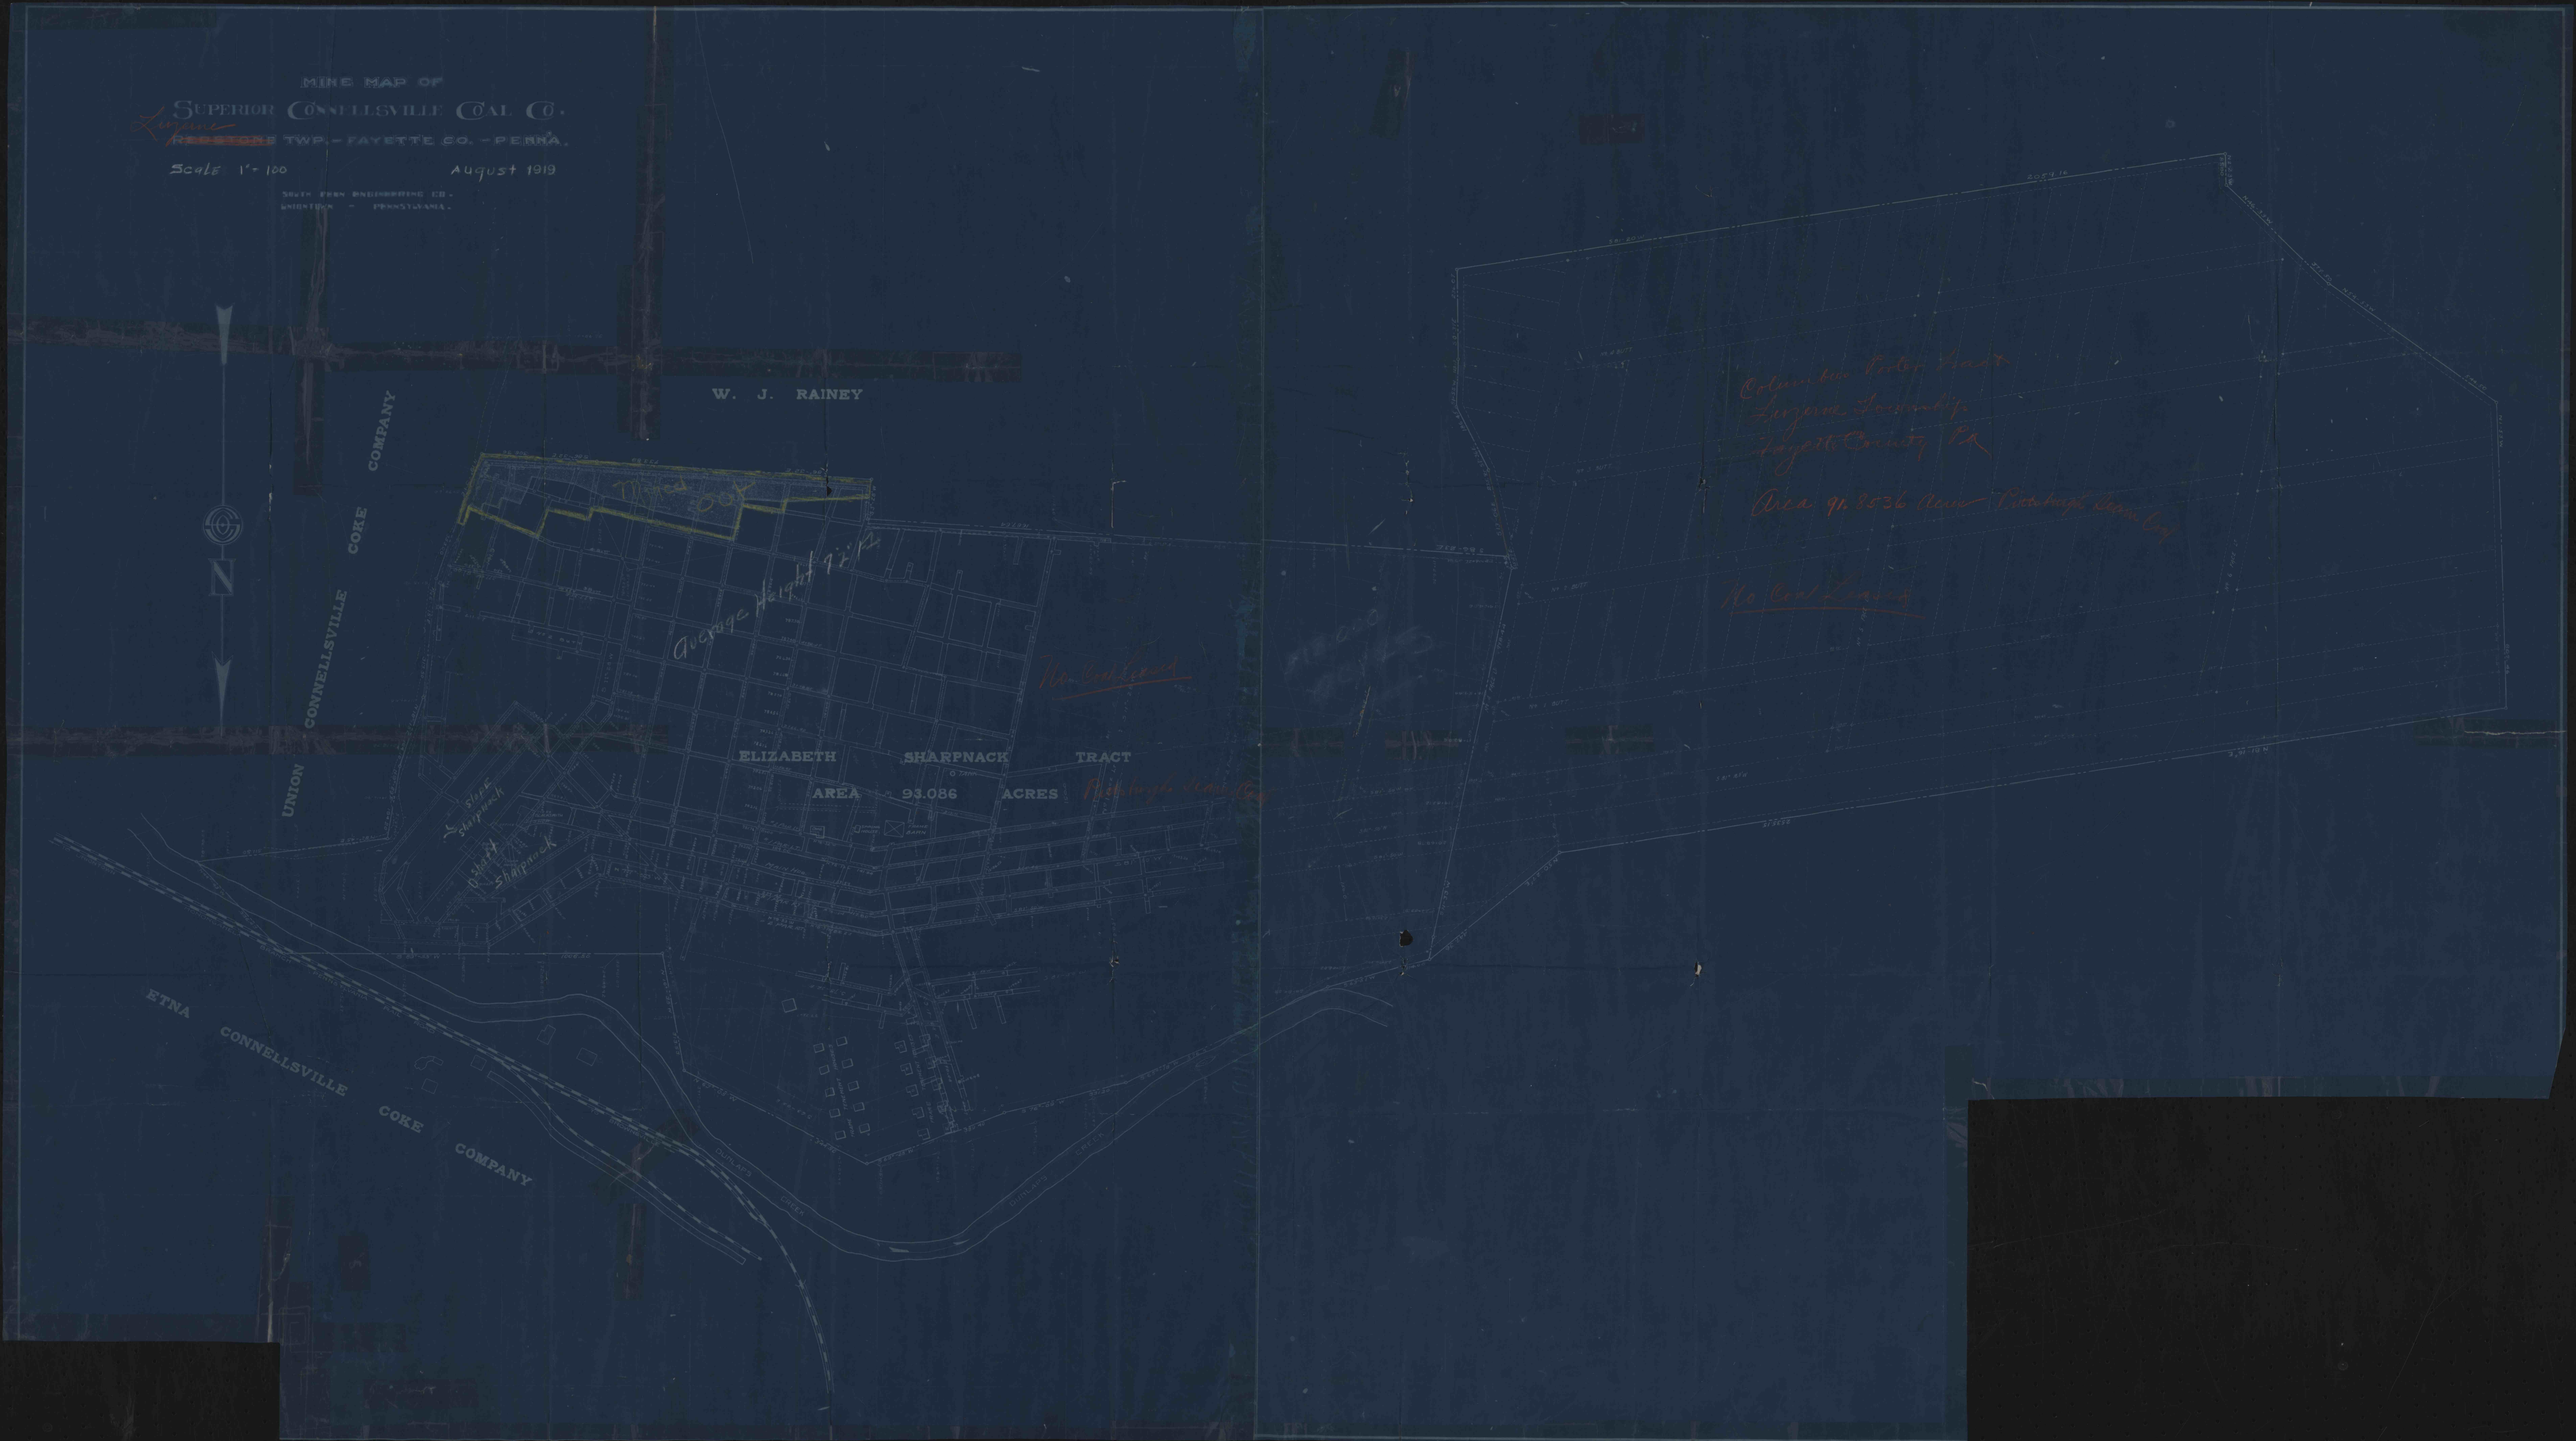
MINE MAP OF
SUPERIOR CONNELLSVILLE COAL CO.
Luzerne ~~REDSTONE~~ TWP. - FAYETTE CO. - PENNA.
Scale 1" = 100
August 1919
SOUTH PENN ENGINEERING CO.
WASHINGTON - PENNSYLVANIA.
W. J. RAINEY
UNION CONNELLSVILLE COKE COMPANY
ETNA CONNELLSVILLE COKE COMPANY
N
Average Height 92 ft
No Coal Leased
ELIZABETH SHARPNACK TRACT
AREA 93.086 ACRES
Pittsburgh Seam Coal
Columbus Porter Tract
Luzerne Township
Fayette County Pa
Area 91.8536 Acres Pittsburgh Seam Coal
No Coal Leased