
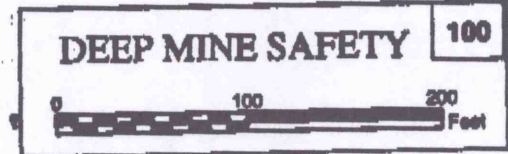


ENOCH WALSH WAR.


SOMERSET COUNTY  
CAMBRIA COUNTY

CAMBRIA IRON COMPANY.  
MINERAL

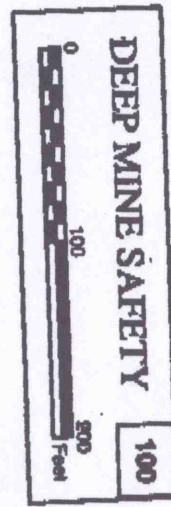

CABLE MINE

UPPER KITTANNING SEAM  
PRIME  
OFFCROP

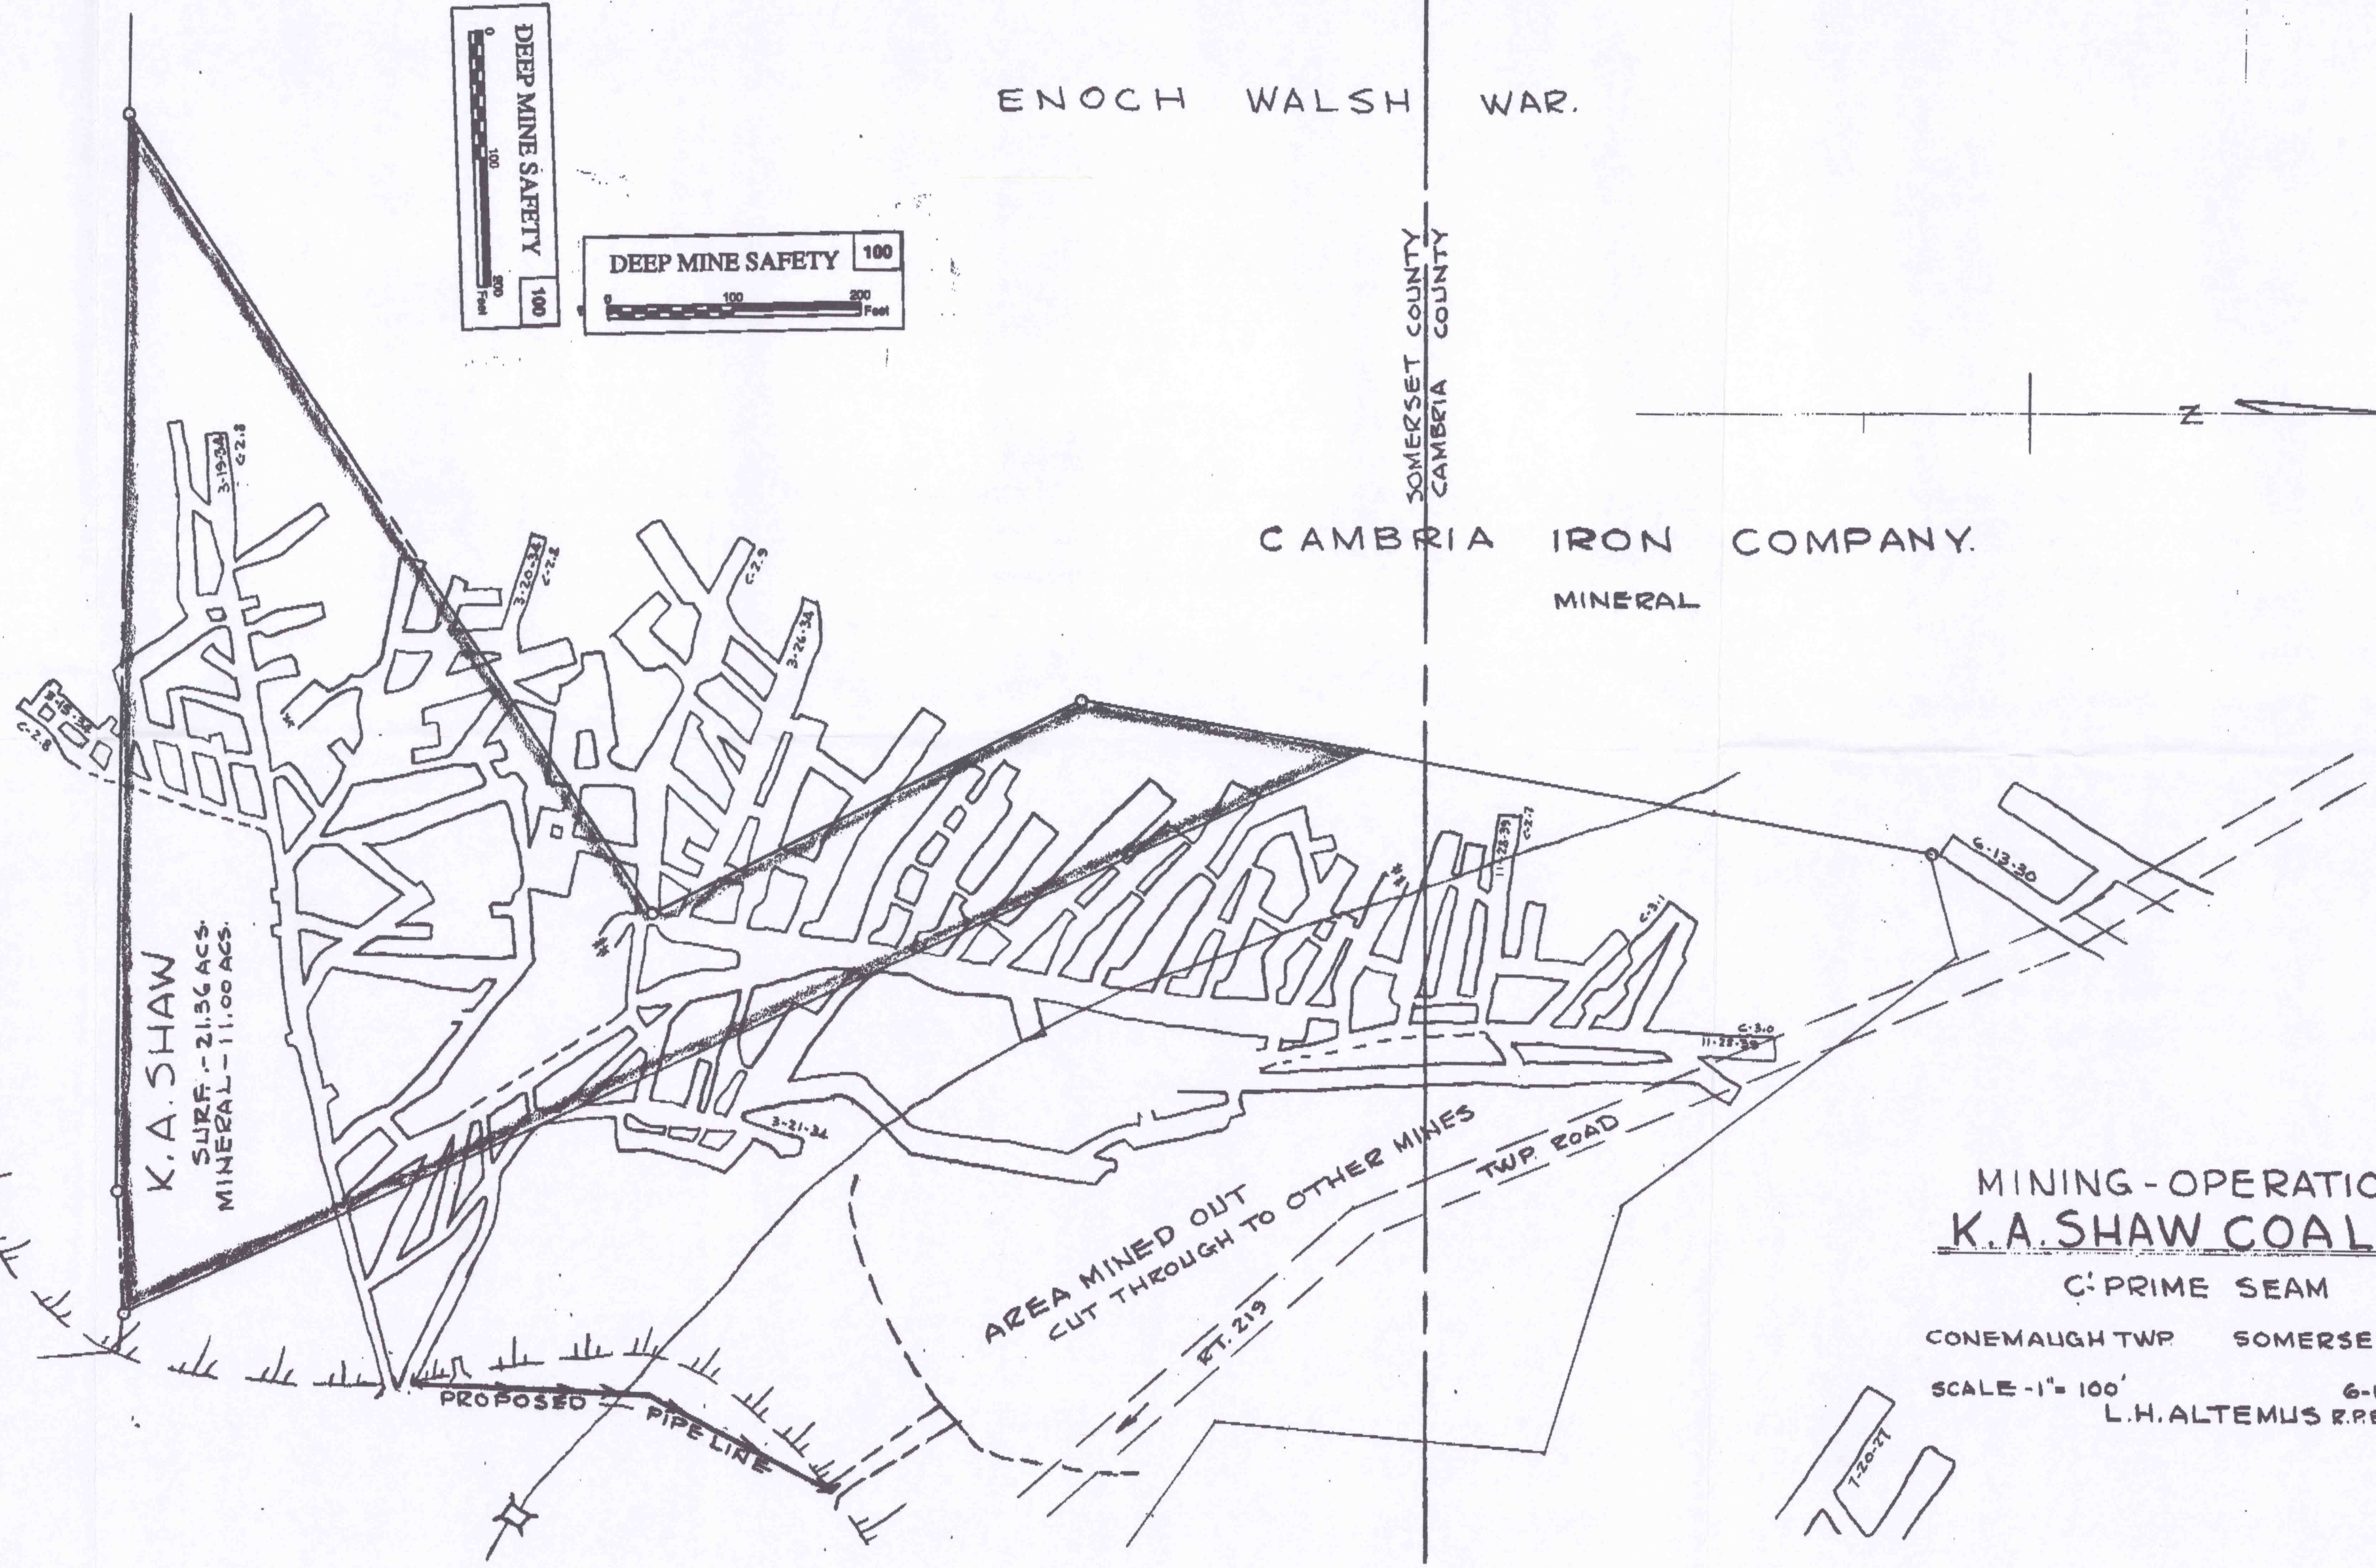

K.A. SHAW  
SURF - 21.36 ACS.  
MINERAL - 11.00 ACS.

AREA MINED OUT  
CUT THROUGH TO OTHER MINES

FT. 219


TWP. ROAD

MINING - OPERATION  
K.A. SHAW COAL CO.

C: PRIME SEAM

CONEMAUGH TWP. SOMERSET CO. PA.

SCALE - 1" = 100' 6-18-1960  
L.H. ALTEMUS R.P.E.

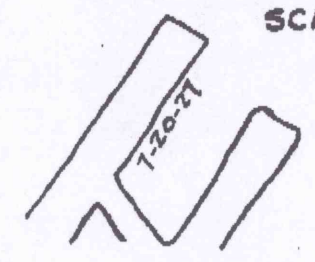

# 2785

MAB-202