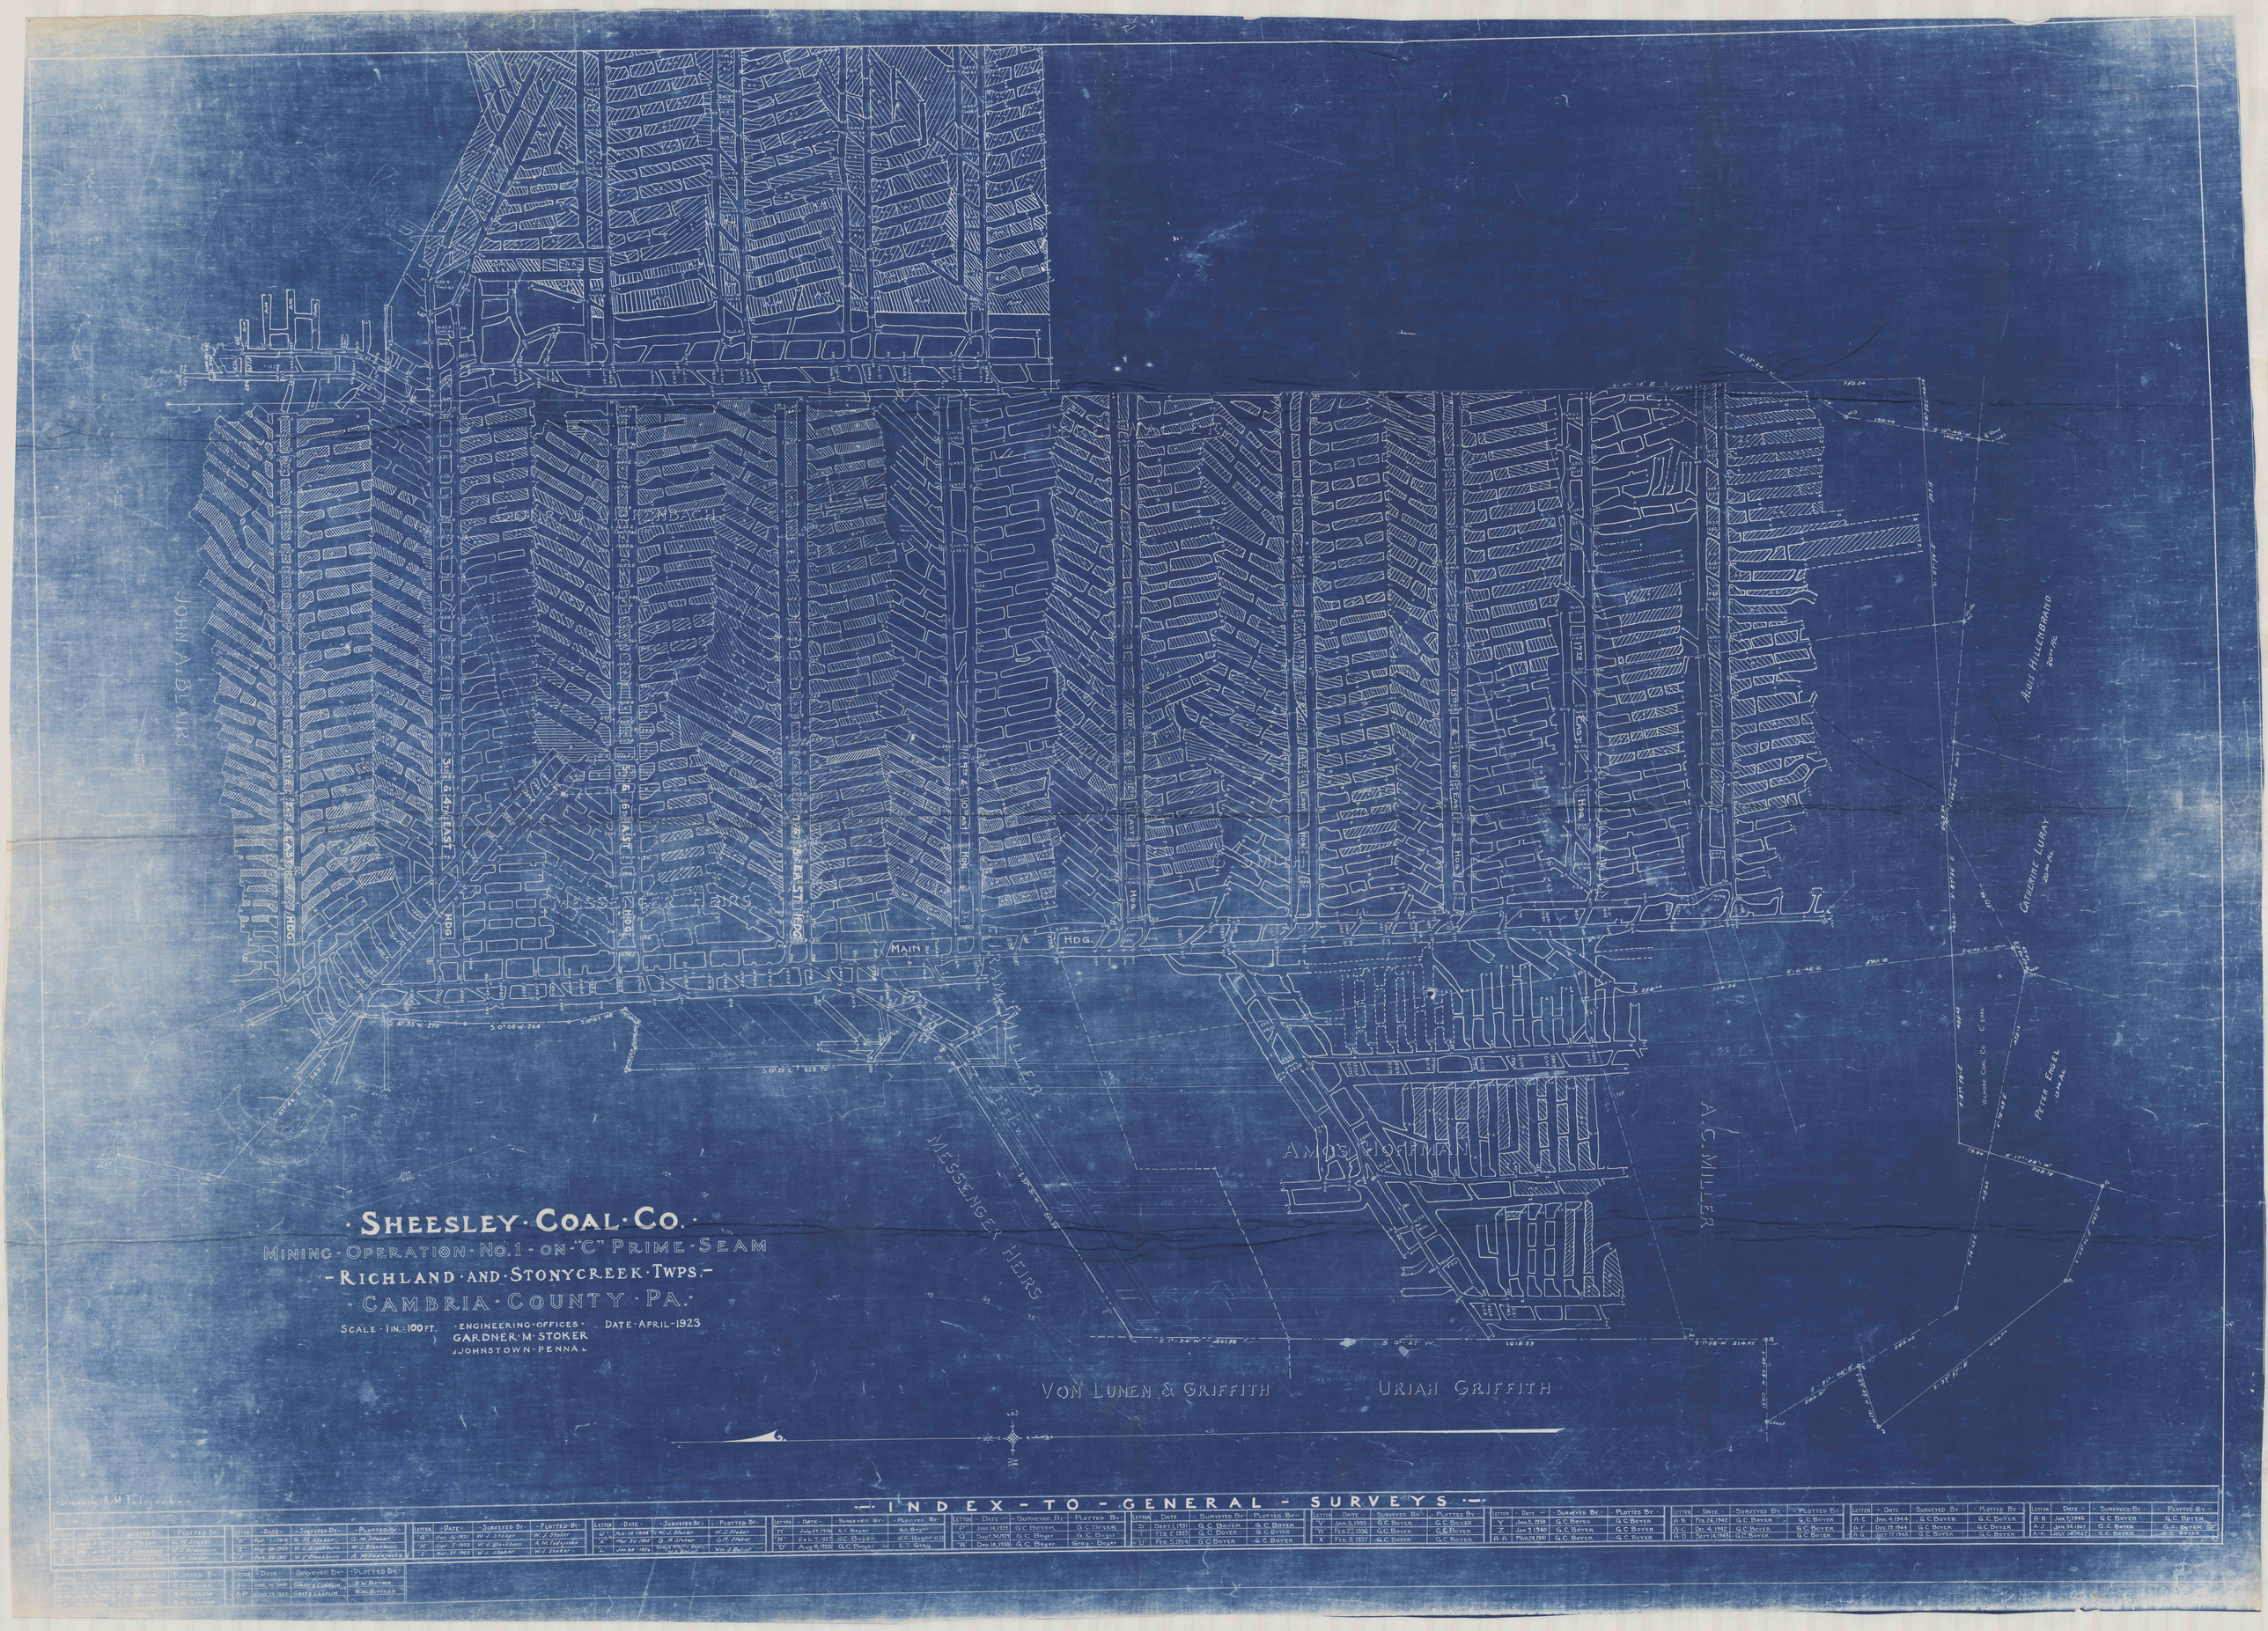

- INDEX - TO - GENERAL - SURVEYS -

Letter	Date	Surveyed By	Plotted By
D	Jan. 1, 1919	G. M. Stoker	G. M. Stoker
E	Aug. 2, 1919	W. J. Blackburn	W. J. Blackburn
F	Feb. 28, 1920	W. J. Blackburn	W. J. Blackburn
G	Dec. 16, 1921	W. J. Stoker	W. J. Stoker
H	Sept. 7, 1922	W. J. Blackburn	G. M. Stoker
I	Mar. 27, 1923	W. J. Stoker	W. J. Stoker
J	Feb. 12, 1924	W. J. Stoker	W. J. Stoker
K	Mar. 30, 1924	G. M. Stoker	G. M. Stoker
L	Jan. 22, 1924	Gray & Claflin	W. J. Blackburn
M	Feb. 14, 1924	G. C. Boyer	G. C. Boyer
N	Feb. 7, 1927	G. C. Boyer	G. C. Boyer
O	Aug. 8, 1928	G. C. Boyer	G. C. Boyer
P	Jan. 14, 1929	G. C. Boyer	G. C. Boyer
Q	Sept. 30, 1929	G. C. Boyer	G. C. Boyer
R	Dec. 18, 1930	G. C. Boyer	Gray - Boyer
S	Sept. 1, 1931	G. C. Boyer	G. C. Boyer
T	Feb. 2, 1933	G. C. Boyer	G. C. Boyer
U	Feb. 5, 1934	G. C. Boyer	G. C. Boyer
V	Jan. 3, 1935	G. C. Boyer	G. C. Boyer
W	Feb. 27, 1936	G. C. Boyer	G. C. Boyer
X	Feb. 5, 1937	G. C. Boyer	G. C. Boyer
Y	Jan. 3, 1938	G. C. Boyer	G. C. Boyer
Z	Jan. 3, 1940	G. C. Boyer	G. C. Boyer
A-A	Mar. 24, 1941	G. C. Boyer	G. C. Boyer
A-B	Feb. 26, 1942	G. C. Boyer	G. C. Boyer
A-C	Dec. 4, 1942	G. C. Boyer	G. C. Boyer
A-D	Sept. 14, 1943	G. C. Boyer	G. C. Boyer
A-E	Jan. 4, 1944	G. C. Boyer	G. C. Boyer
A-F	Dec. 28, 1944	G. C. Boyer	G. C. Boyer
A-G	July 17, 1945	G. C. Boyer	G. C. Boyer
A-H	Jan. 7, 1946	G. C. Boyer	G. C. Boyer
A-J	Jan. 30, 1947	G. C. Boyer	G. C. Boyer
A-K	July 14, 1947	G. C. Boyer	G. C. Boyer
A-L	Jan. 10, 1949	G. C. Boyer	G. C. Boyer
A-M	Jan. 23, 1950	Gray & Claflin	R. W. Bittner
A-N	June 23, 1950	Gray & Claflin	R. W. Bittner