

Permit No. 356-1


CHANNEL COAL INC.

SHERE MINE
SUSQUEHANNA TWP. CAMBRIA CO., PA.

SCALE - 1 inch = 100 feet

JUNE 20, 1920
CLEARFIELD, PA.

JOHN W. HESS
ENGINEER

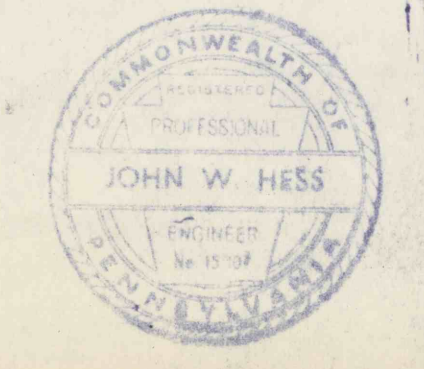

OFFICE COPY

- CONTEMPLATED MINING 7 Acres
 Pulling Pillars
 March 15, 1920 to September 15, 1920
- COMPLETED MINING 24 Acres

Revised by date	4/17/20	W.H.
Drawn by date	4/17/20	W.H.
Checked by date	4/17/20	W.H.
Approved by date	4/17/20	W.H.
Scale	1" = 100'	
Sheet No.	1	
Total Sheets	1	