
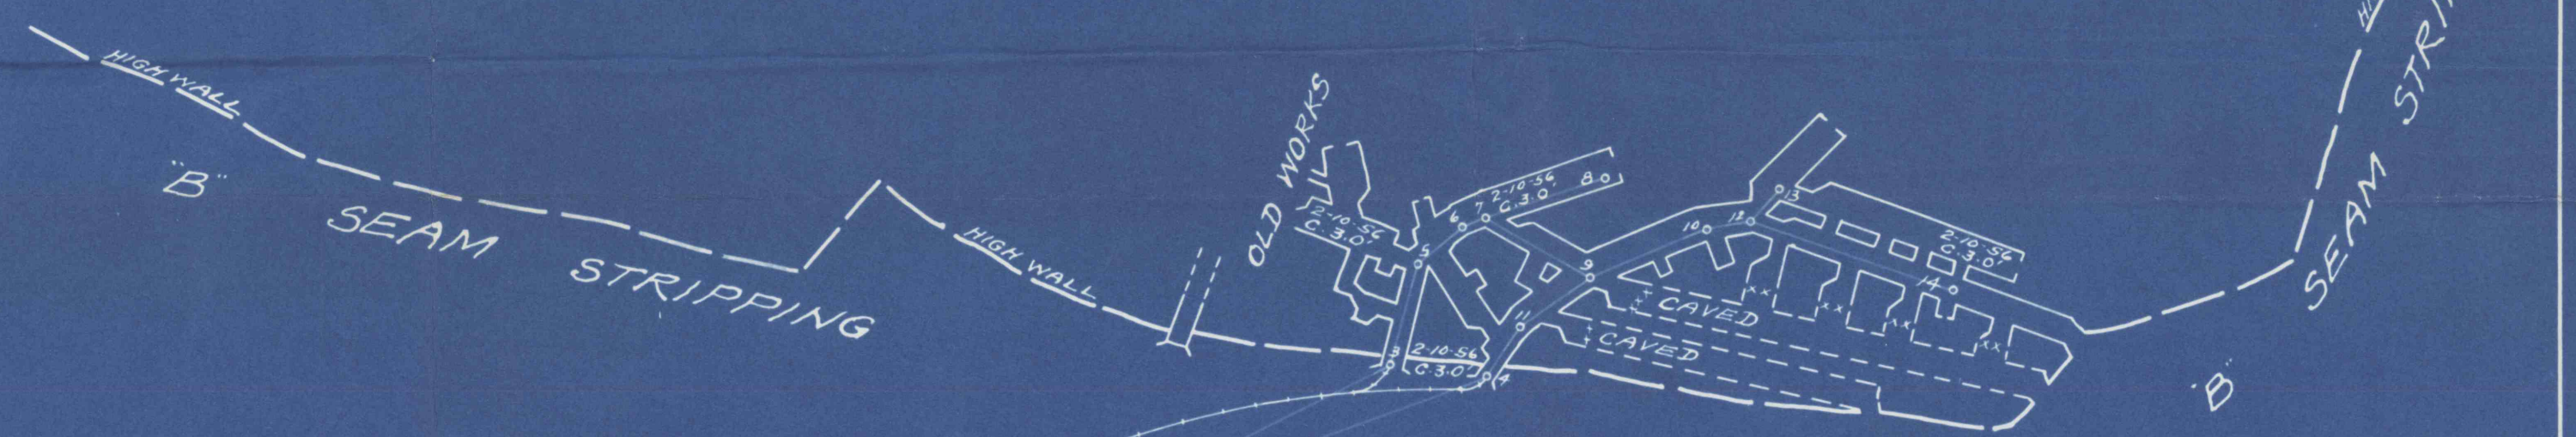


RICHARD HUMPTON TRACT

C. B. C. CORP.

MARTHA S. SNYDER TRACT

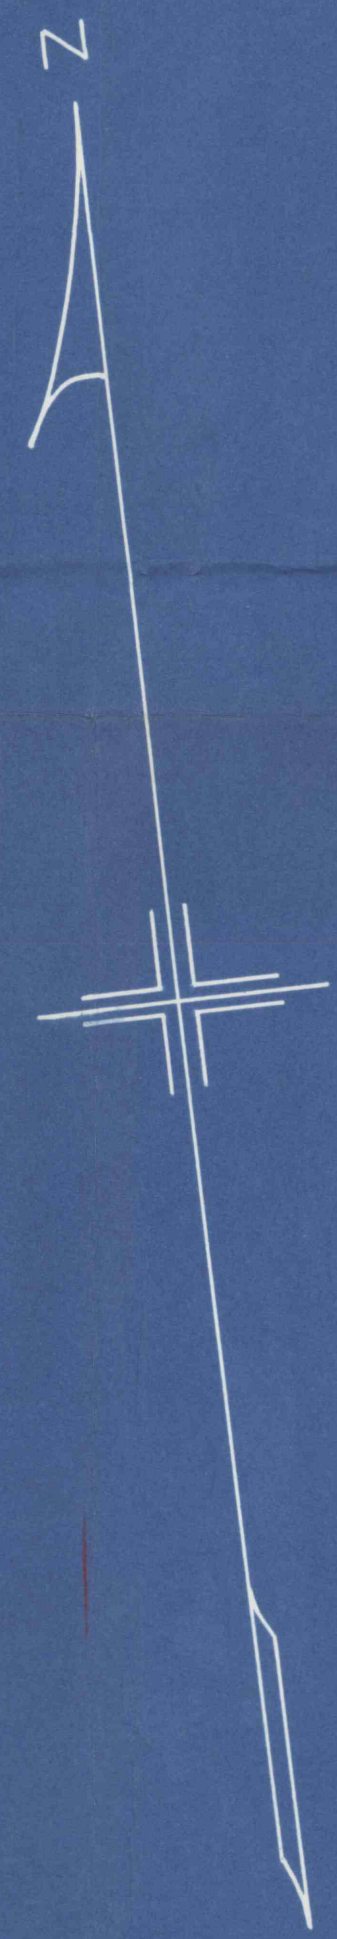

— MAP OF VIADUCT NO. 1 "B" SEAM MINE —  
— OPERATED BY R. LARSON & M. EMANUELSON —  
— COOPER TWP. CLEARFIELD COUNTY PENNA. —  
— SCALE 1"=100' — FEB. 13, 1956 —  
— BERNARD LUCAS ASSOC. —