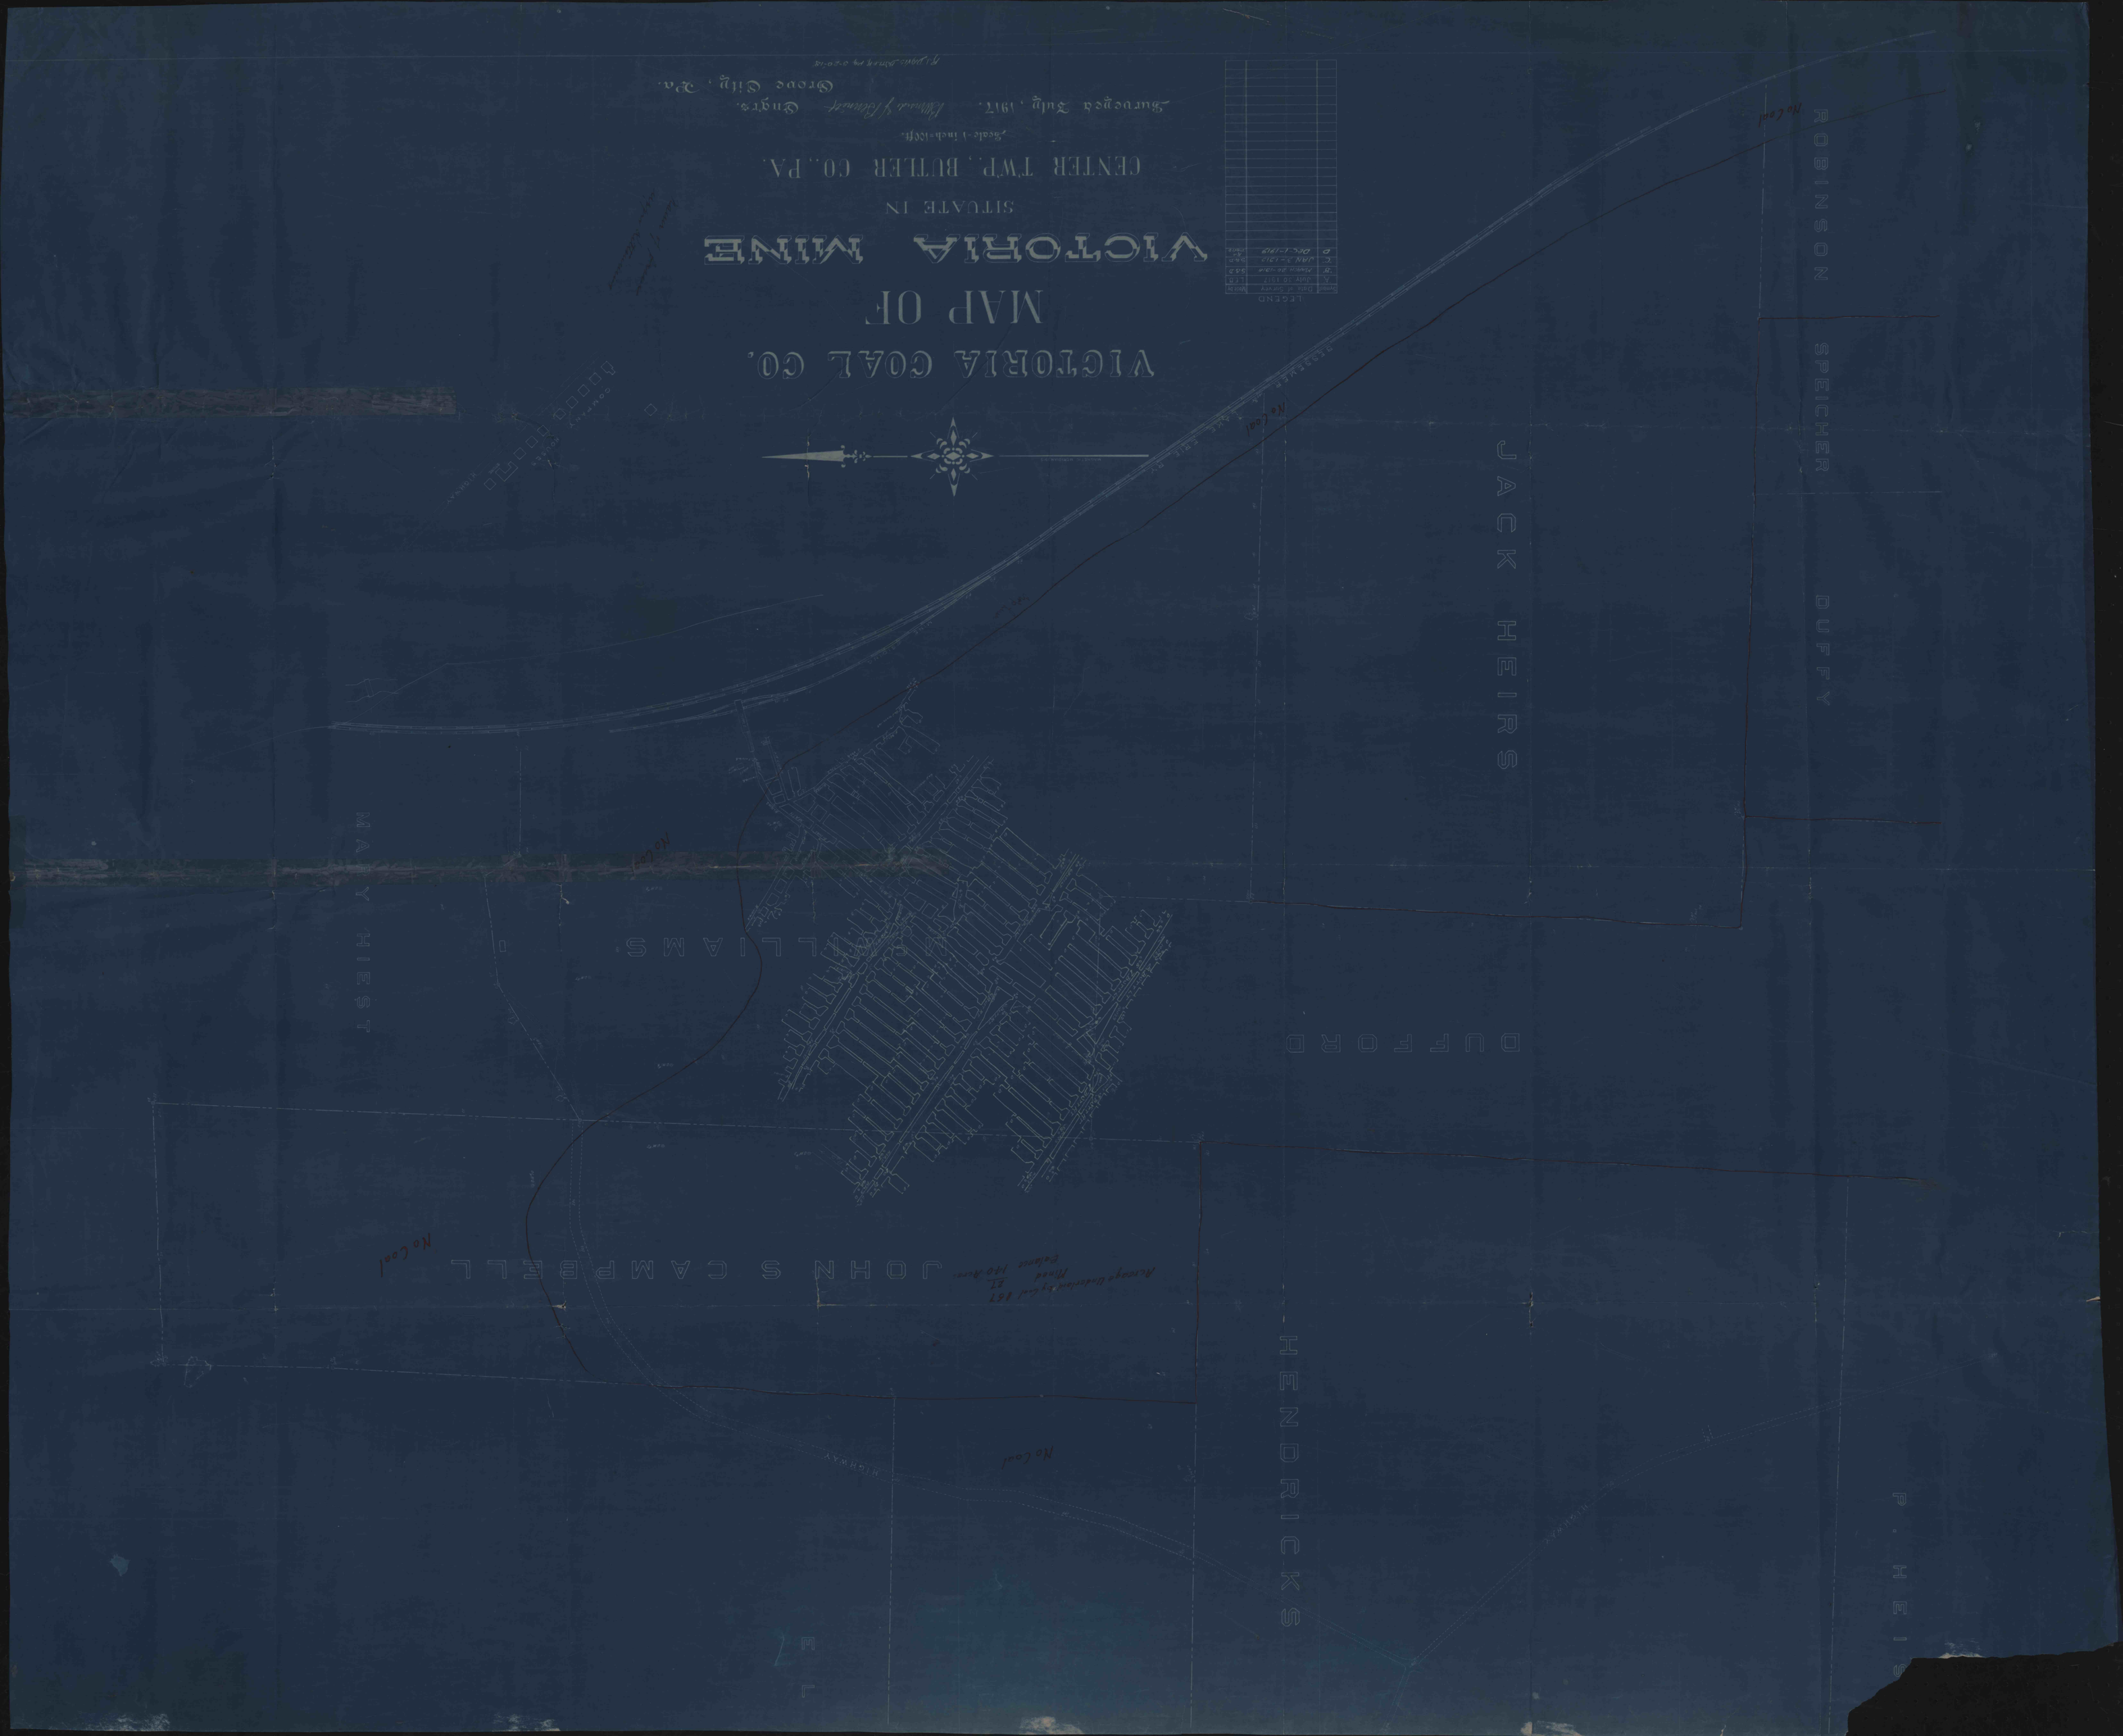
VICTORIA COAL CO.
MAP OF
VICTORIA MINE
SITUATE IN
CENTER TWP., BUTLER CO., PA.
Scale-1 inch=100ft.
Surveyed July, 1917.
Grove City, Pa.
LEGEND
ROBINSON
SPEICHER
DUFFY
JACK HEIRS
DUFFORD
HENDRICKS
JOHN S CAMPBELL
MCWILLIAMS
No Coal
HIGHWAY