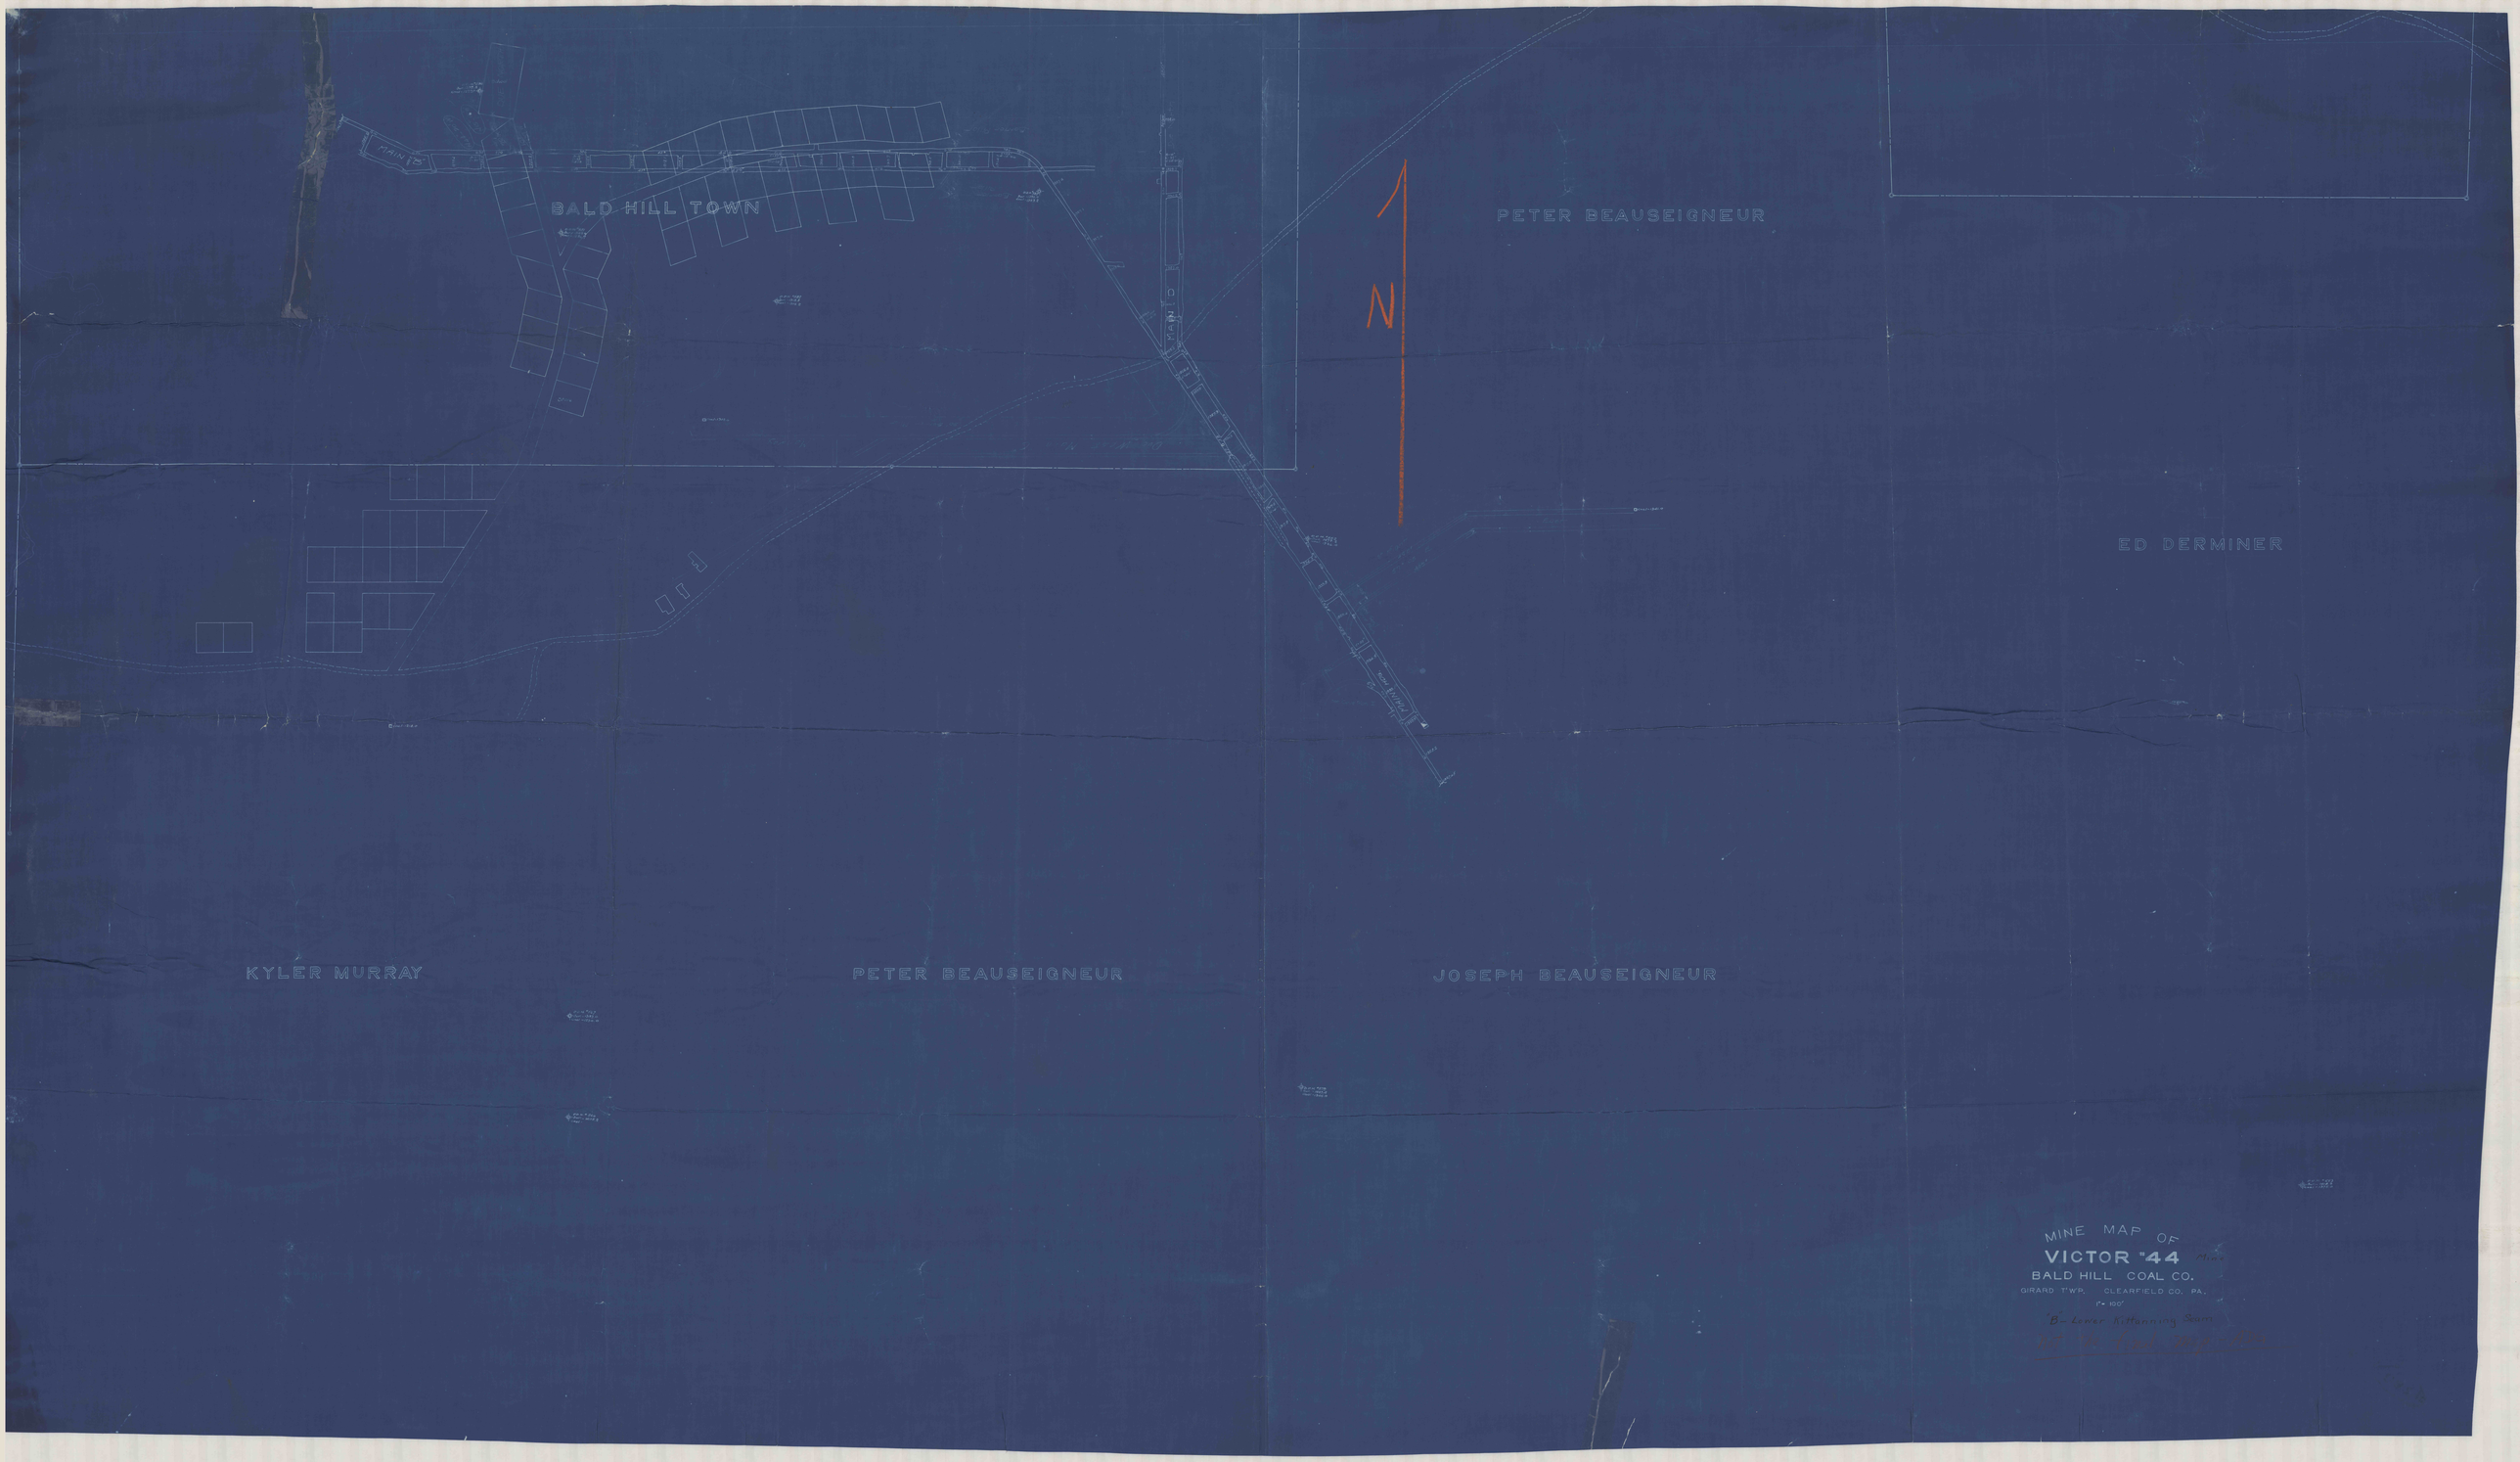
BALD HILL TOWN
MAIN ST
MAIN
PETER BEAUSEIGNEUR
N
ED DERMINER
KYLER MURRAY
PETER BEAUSEIGNEUR
JOSEPH BEAUSEIGNEUR
MINE MAP OF
VICTOR #44 Mine
BALD HILL COAL CO.
GIRARD T'WP. CLEARFIELD CO. PA.
1" = 100'
"B" Lower Kittanning Seam