



GEORGE THOMPSON

Mc KNIGHT

George Thompson

Glasgow

Zell

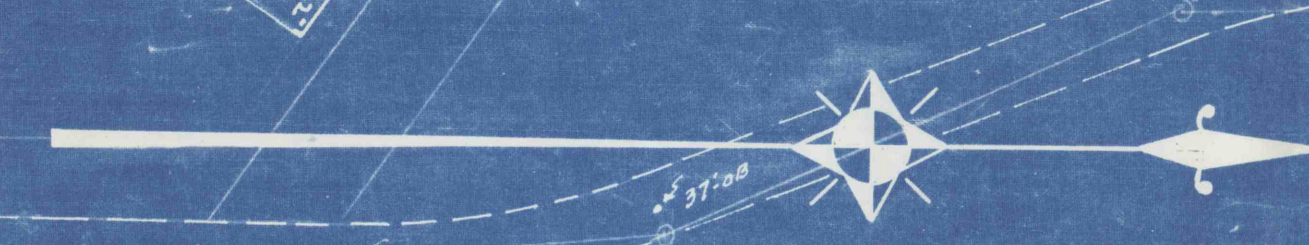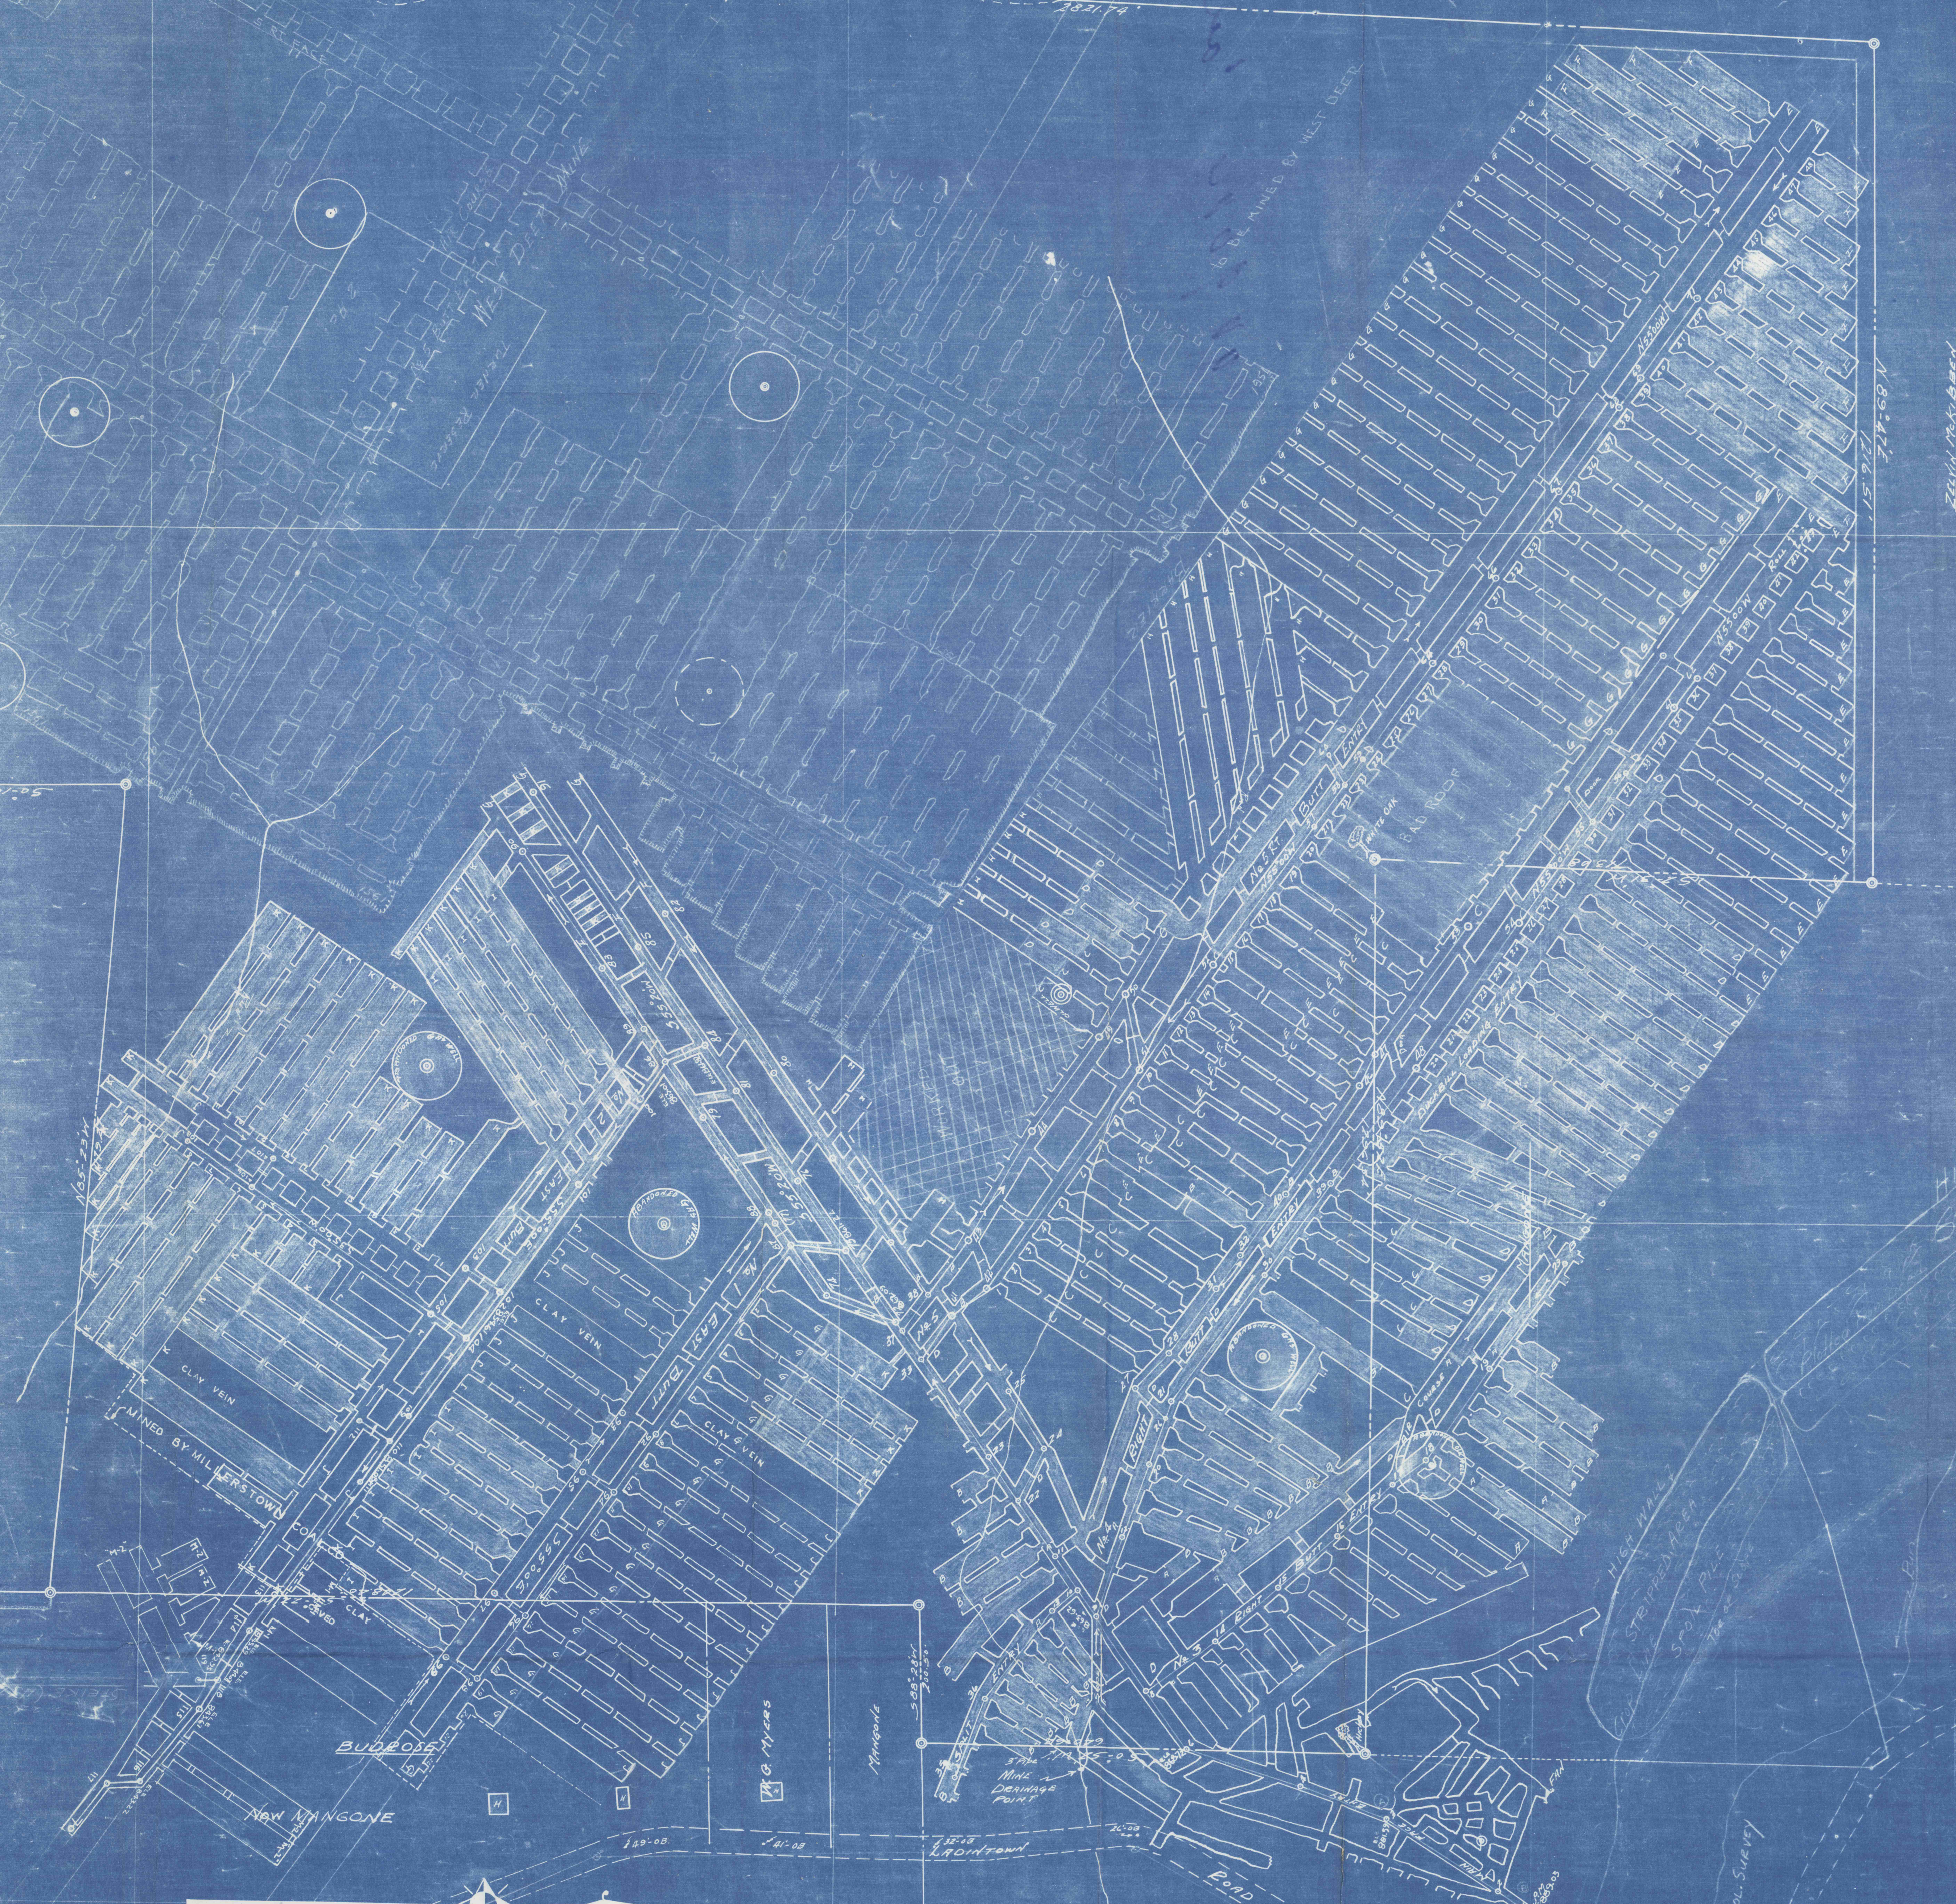

MINE MAP

VICTORY MINE
MILLERSTOWN COAL CO.
FAWN TWP. ALLEG. CO. & CLINTON TWP. BUT. CO.
PENNSYLVANIA

SCALE 1 IN. = 100 FT.
APRIL 19, 1943 A.J. LUCAS-M.E.
COMPLETED FEB. 1953

REOPENED-MAY 1953 BY MANGONE COAL CO

SYMBOL	DATE	ENGINEER
M	4-10-43	A.J. LUCAS
N	6-9-44	"
O	6-20-45	"
P	FEB. 47	"
Q	FEB. 48	"
R	JUN. 49	"
S	12-1-50	"
T	AUG. 51	"
U	JUNE 52	"
V	FEB. 1953	"
W	MAR. 1954	"

MANGONE COAL CO.		
LEGEND OF SURVEYS		
SYMBOL	DATE	ENGINEER
M-1	JUNE 1953	A.J. LUCAS
M-2	APRIL 1955	"

HIGHWAY 7
STRIPPED - TREES
SPOKE PILE
FOR BRIDGE

HIGH WALL
STRIPPED AREA
SPOKE PILE

188100
F.M. U.S. GEOLOG. SURVEY

BLITHE E. M. GINNES

To Bull Creek