



LEASE LINE
 MINING COMPLETED
 6 MOS. PROJECTED
 12/2/67 to 6-2-68

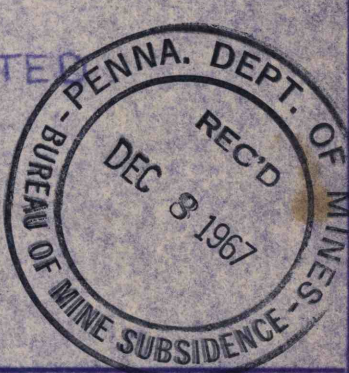

DRAWN	R.B.M.	12/2/64
CHECKED		
APPROVED		
REVISIONS		

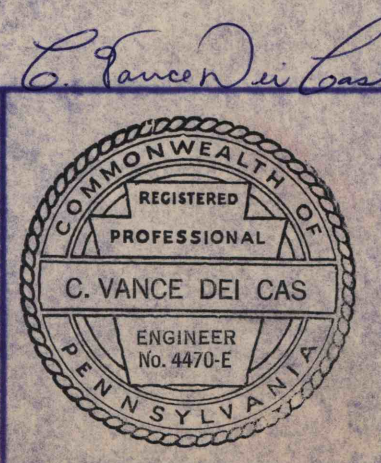

A&W COAL COMPANY
 McDONALD ASSOCIATES ENGINEERING
 CHARLEROI, PA.

SCALE 1" = 100'
 JOB 1532
 SHEET No. 6

F
 NB
 T-30