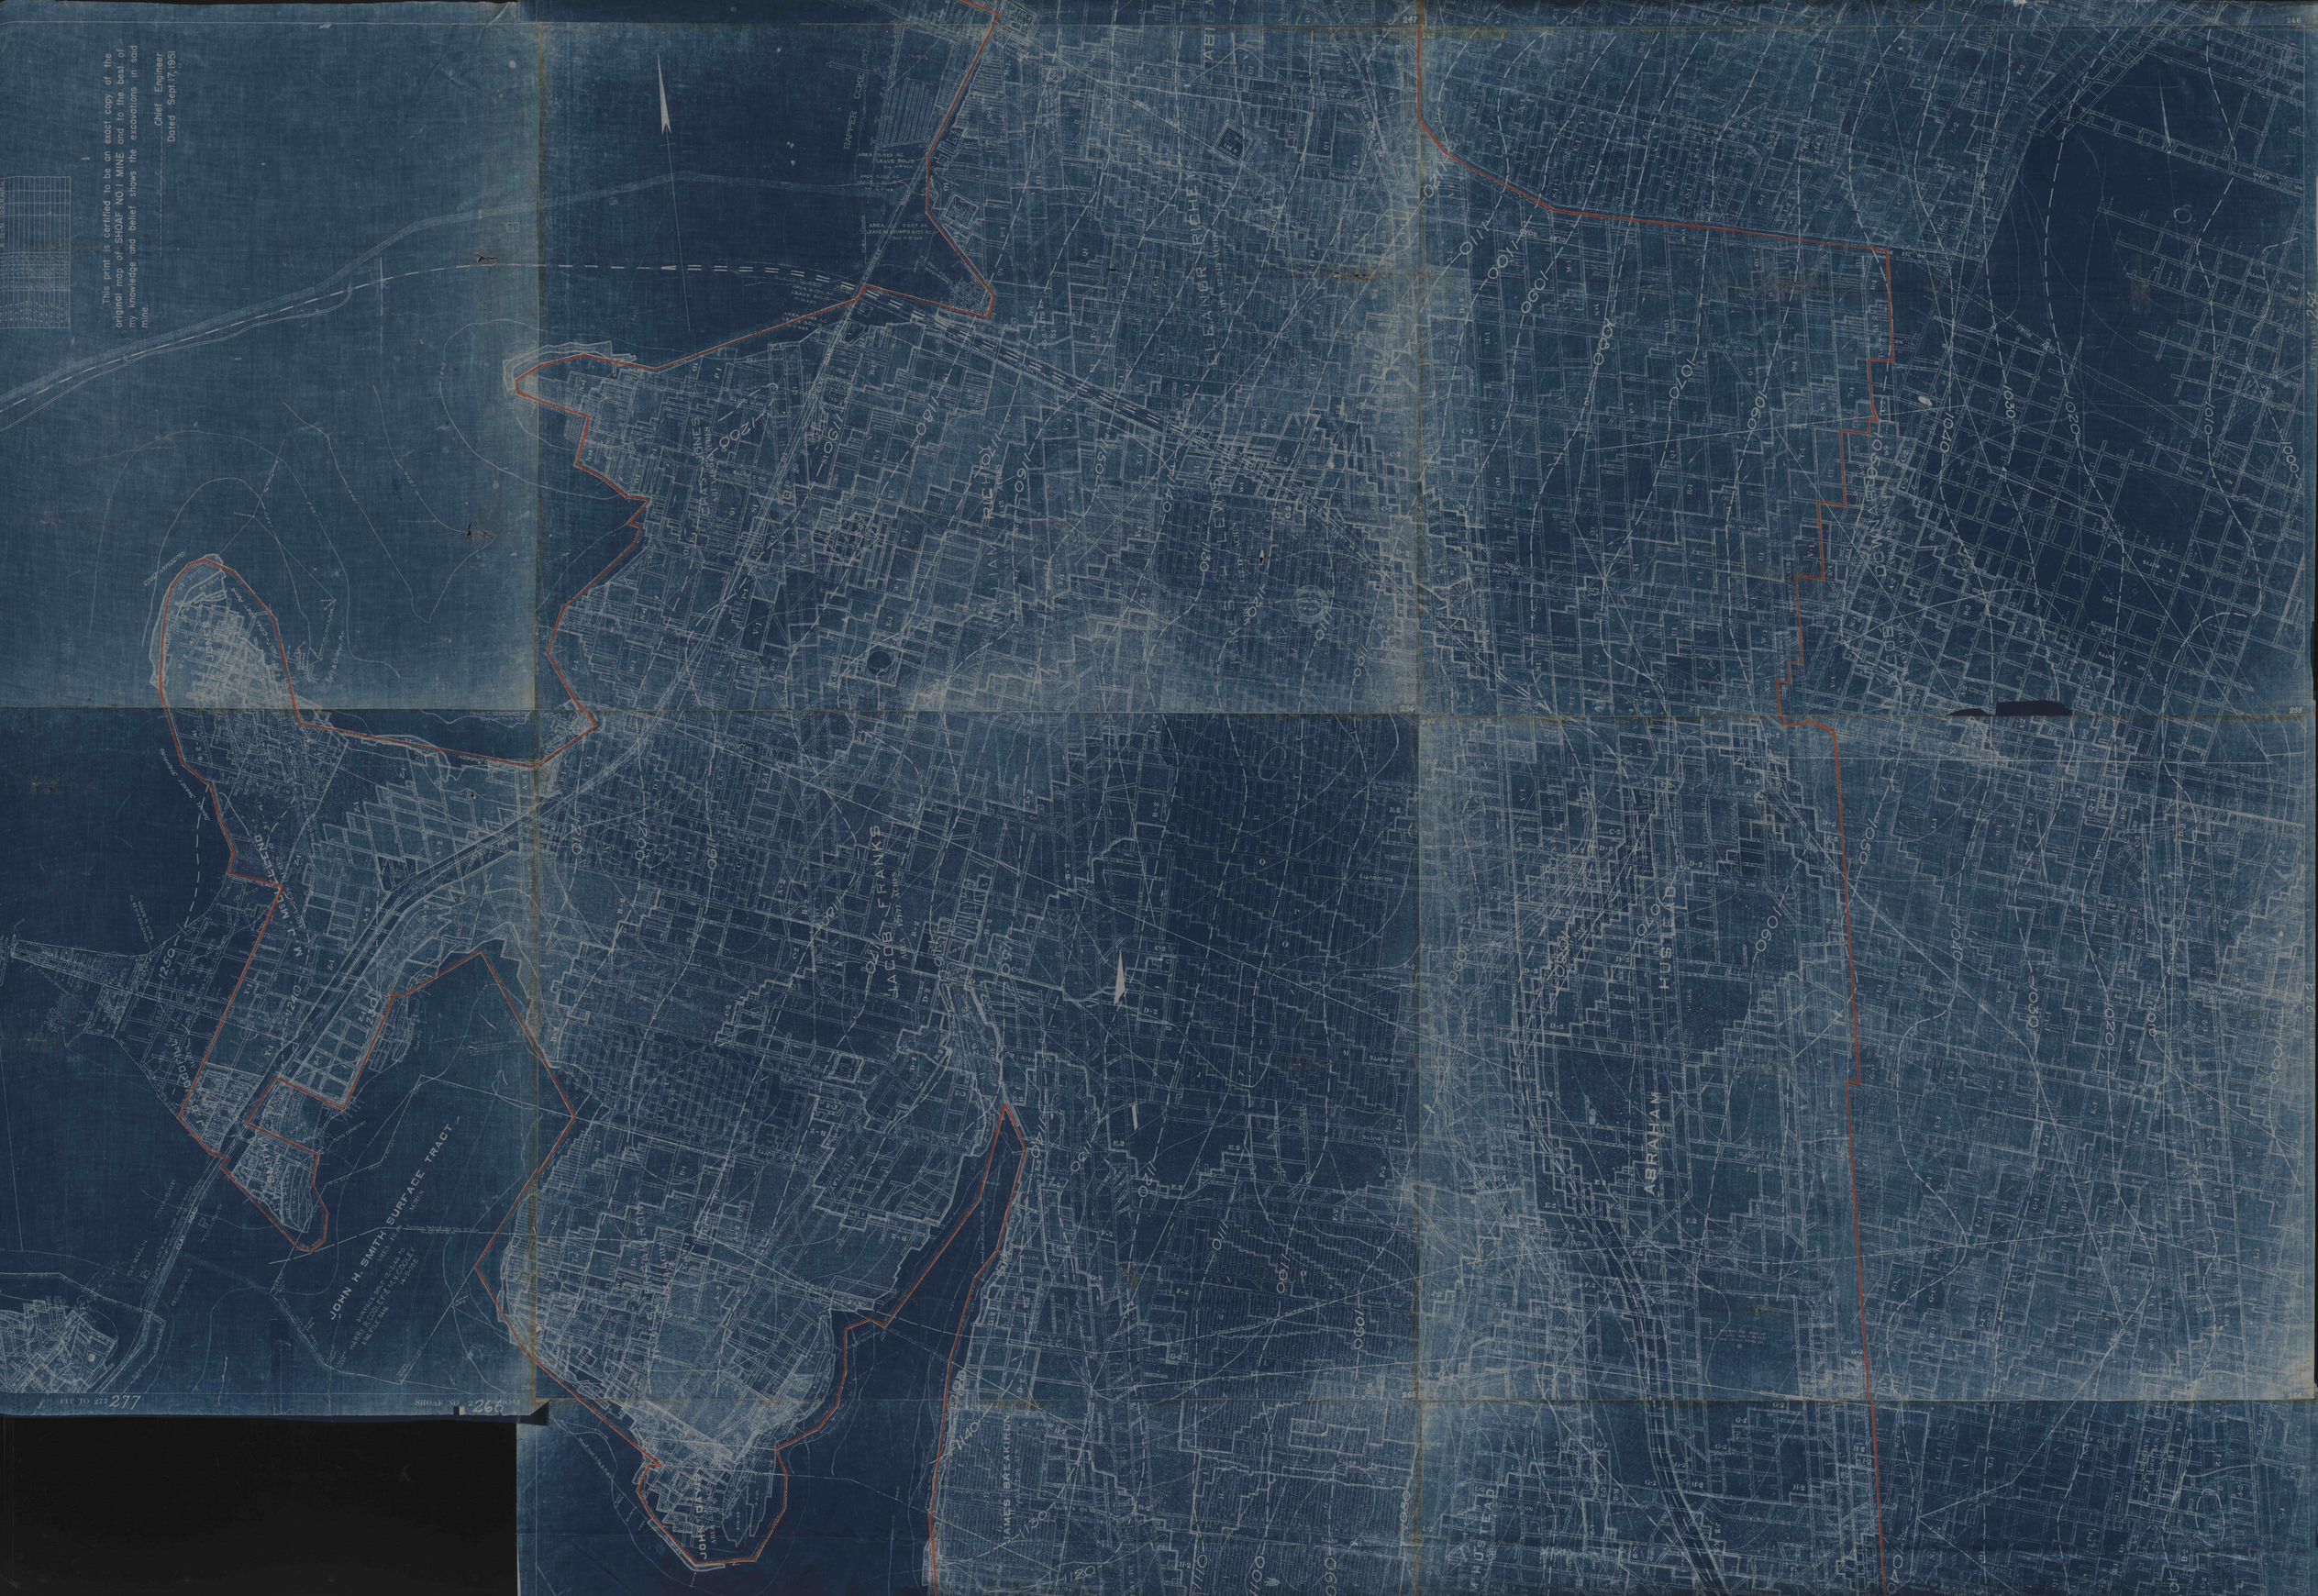
This print is certified to be an exact copy of the original map of SHOAF NO. 1 MINE and to the best of my knowledge and belief shows the excavations in said mine.
Chief Engineer
Dated Sept. 17, 1951
JOHN H. SMITH SURFACE TRACT
JACOB FRANKS
ABRAHAM HUSTEAD
JAMES BREAKIRON
FIT TO 277
277
SHOAF NO. 2
266