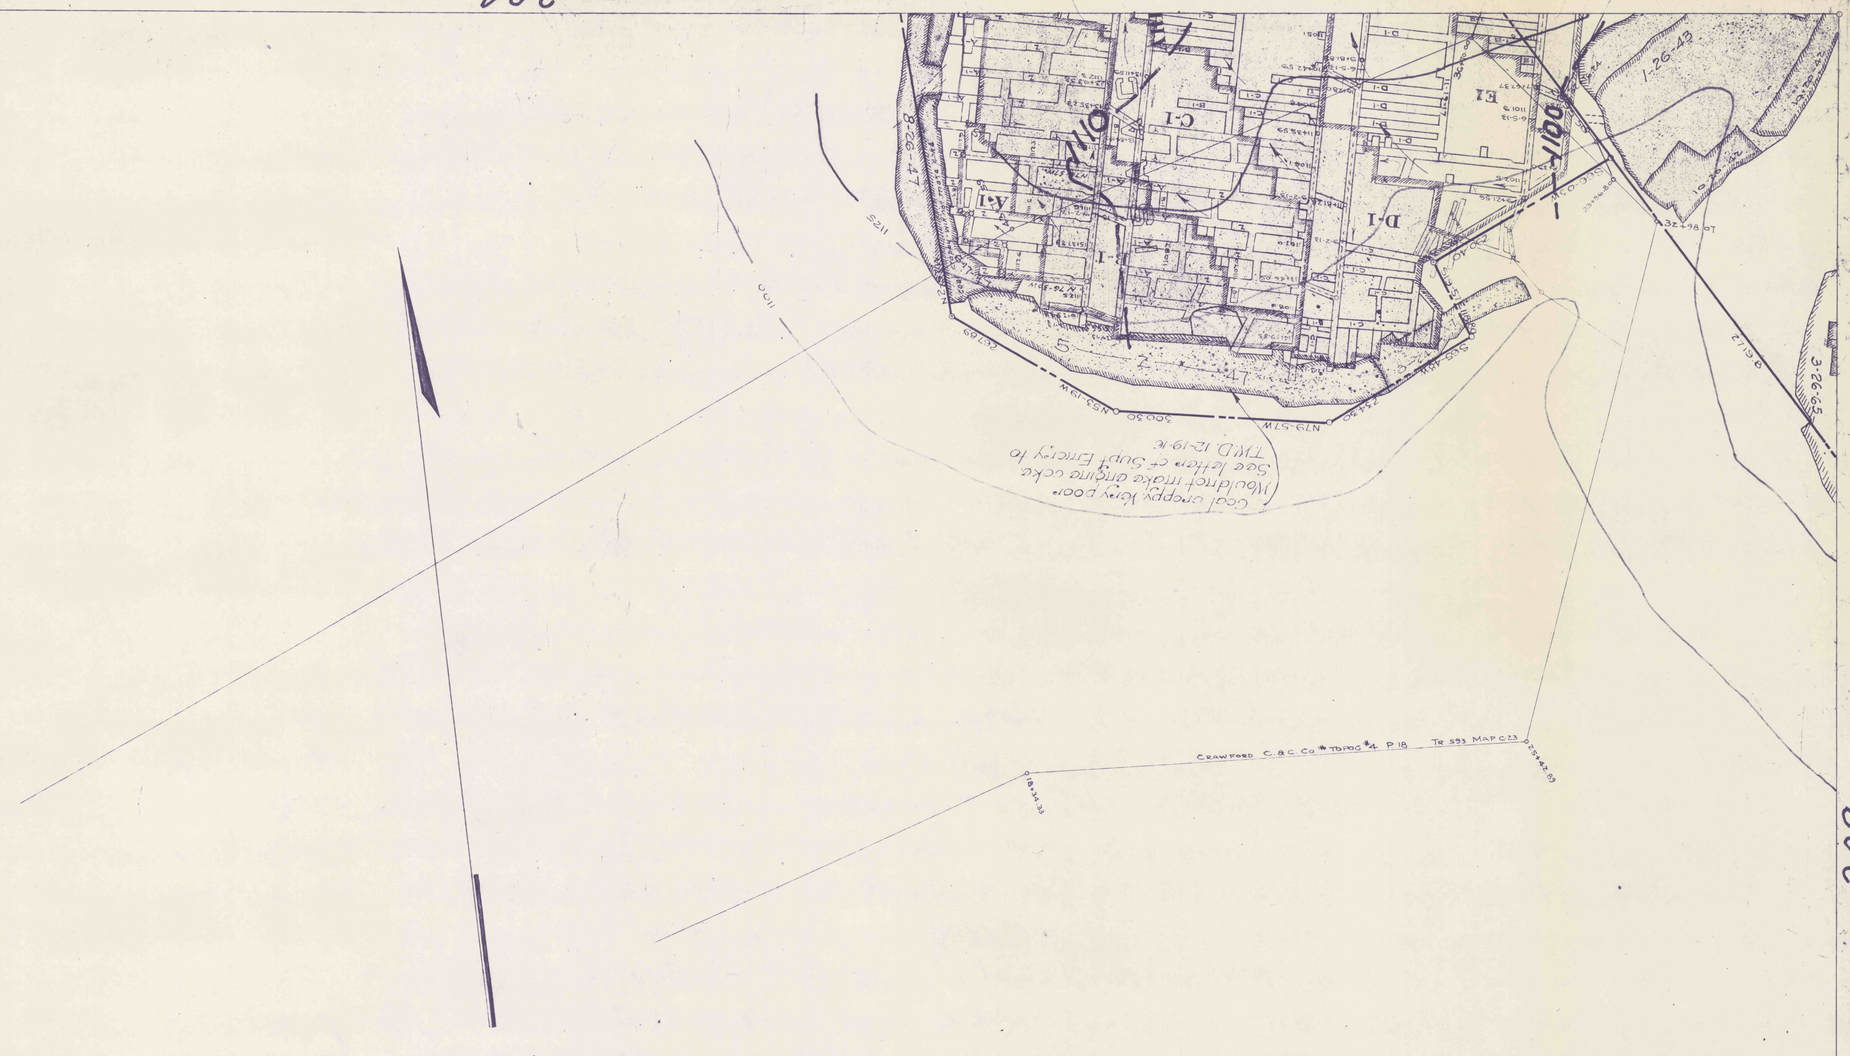
A-1
C-1
D-1
E-1
826.47
S211
1100
243.90
N79-51W
CRAWFORD C.&C.Co. TOPOG. P. 18 Te 593 MAP C23
1-26.43
E-26.65
See letter of Subj Entry to
TWD 12-19-K