FIT RUNTITLE OFF WHEN USING THIS SHEET FOR PLT. TO 304 304
SHEET NO.

FIT TO 309 309

FIT TO 295 295
13 SHEETS 303 YORK RUN SHEET NO.

YORK RUN MINE

H.C. FRICK COKE CO.

GEORGES TWP. FAYETTE CO. PA.
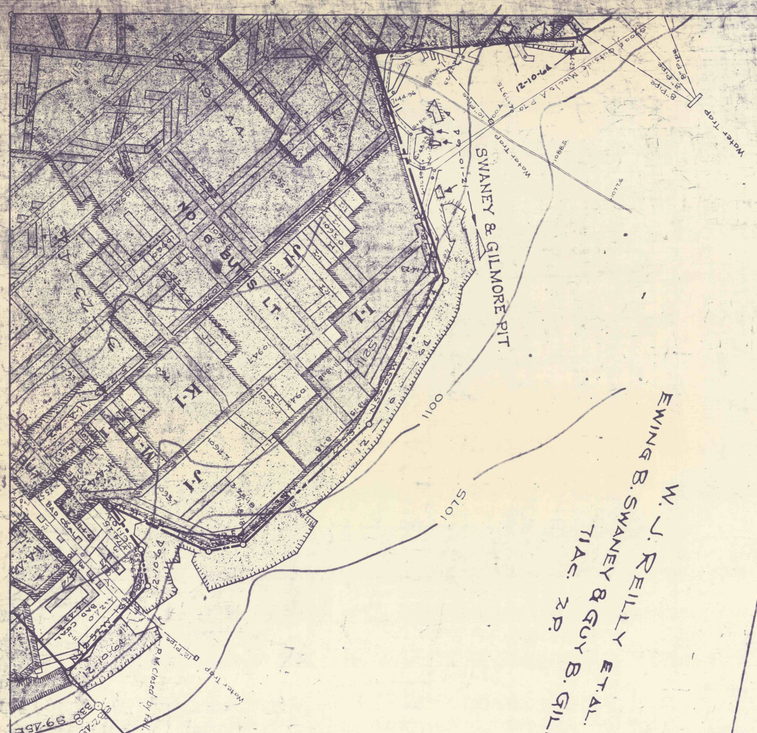
DATUM OF LEVELS
16.1 FEET BELOW MEAN TIDE AT SANDY HOOK.
SCALE 1 IN = 100 FT.