



E 10,000

E 10,000

E 10,000

E 10,000


SANDROCK
ROOF
LINE

MINING

STRIP

OF

LIMIT

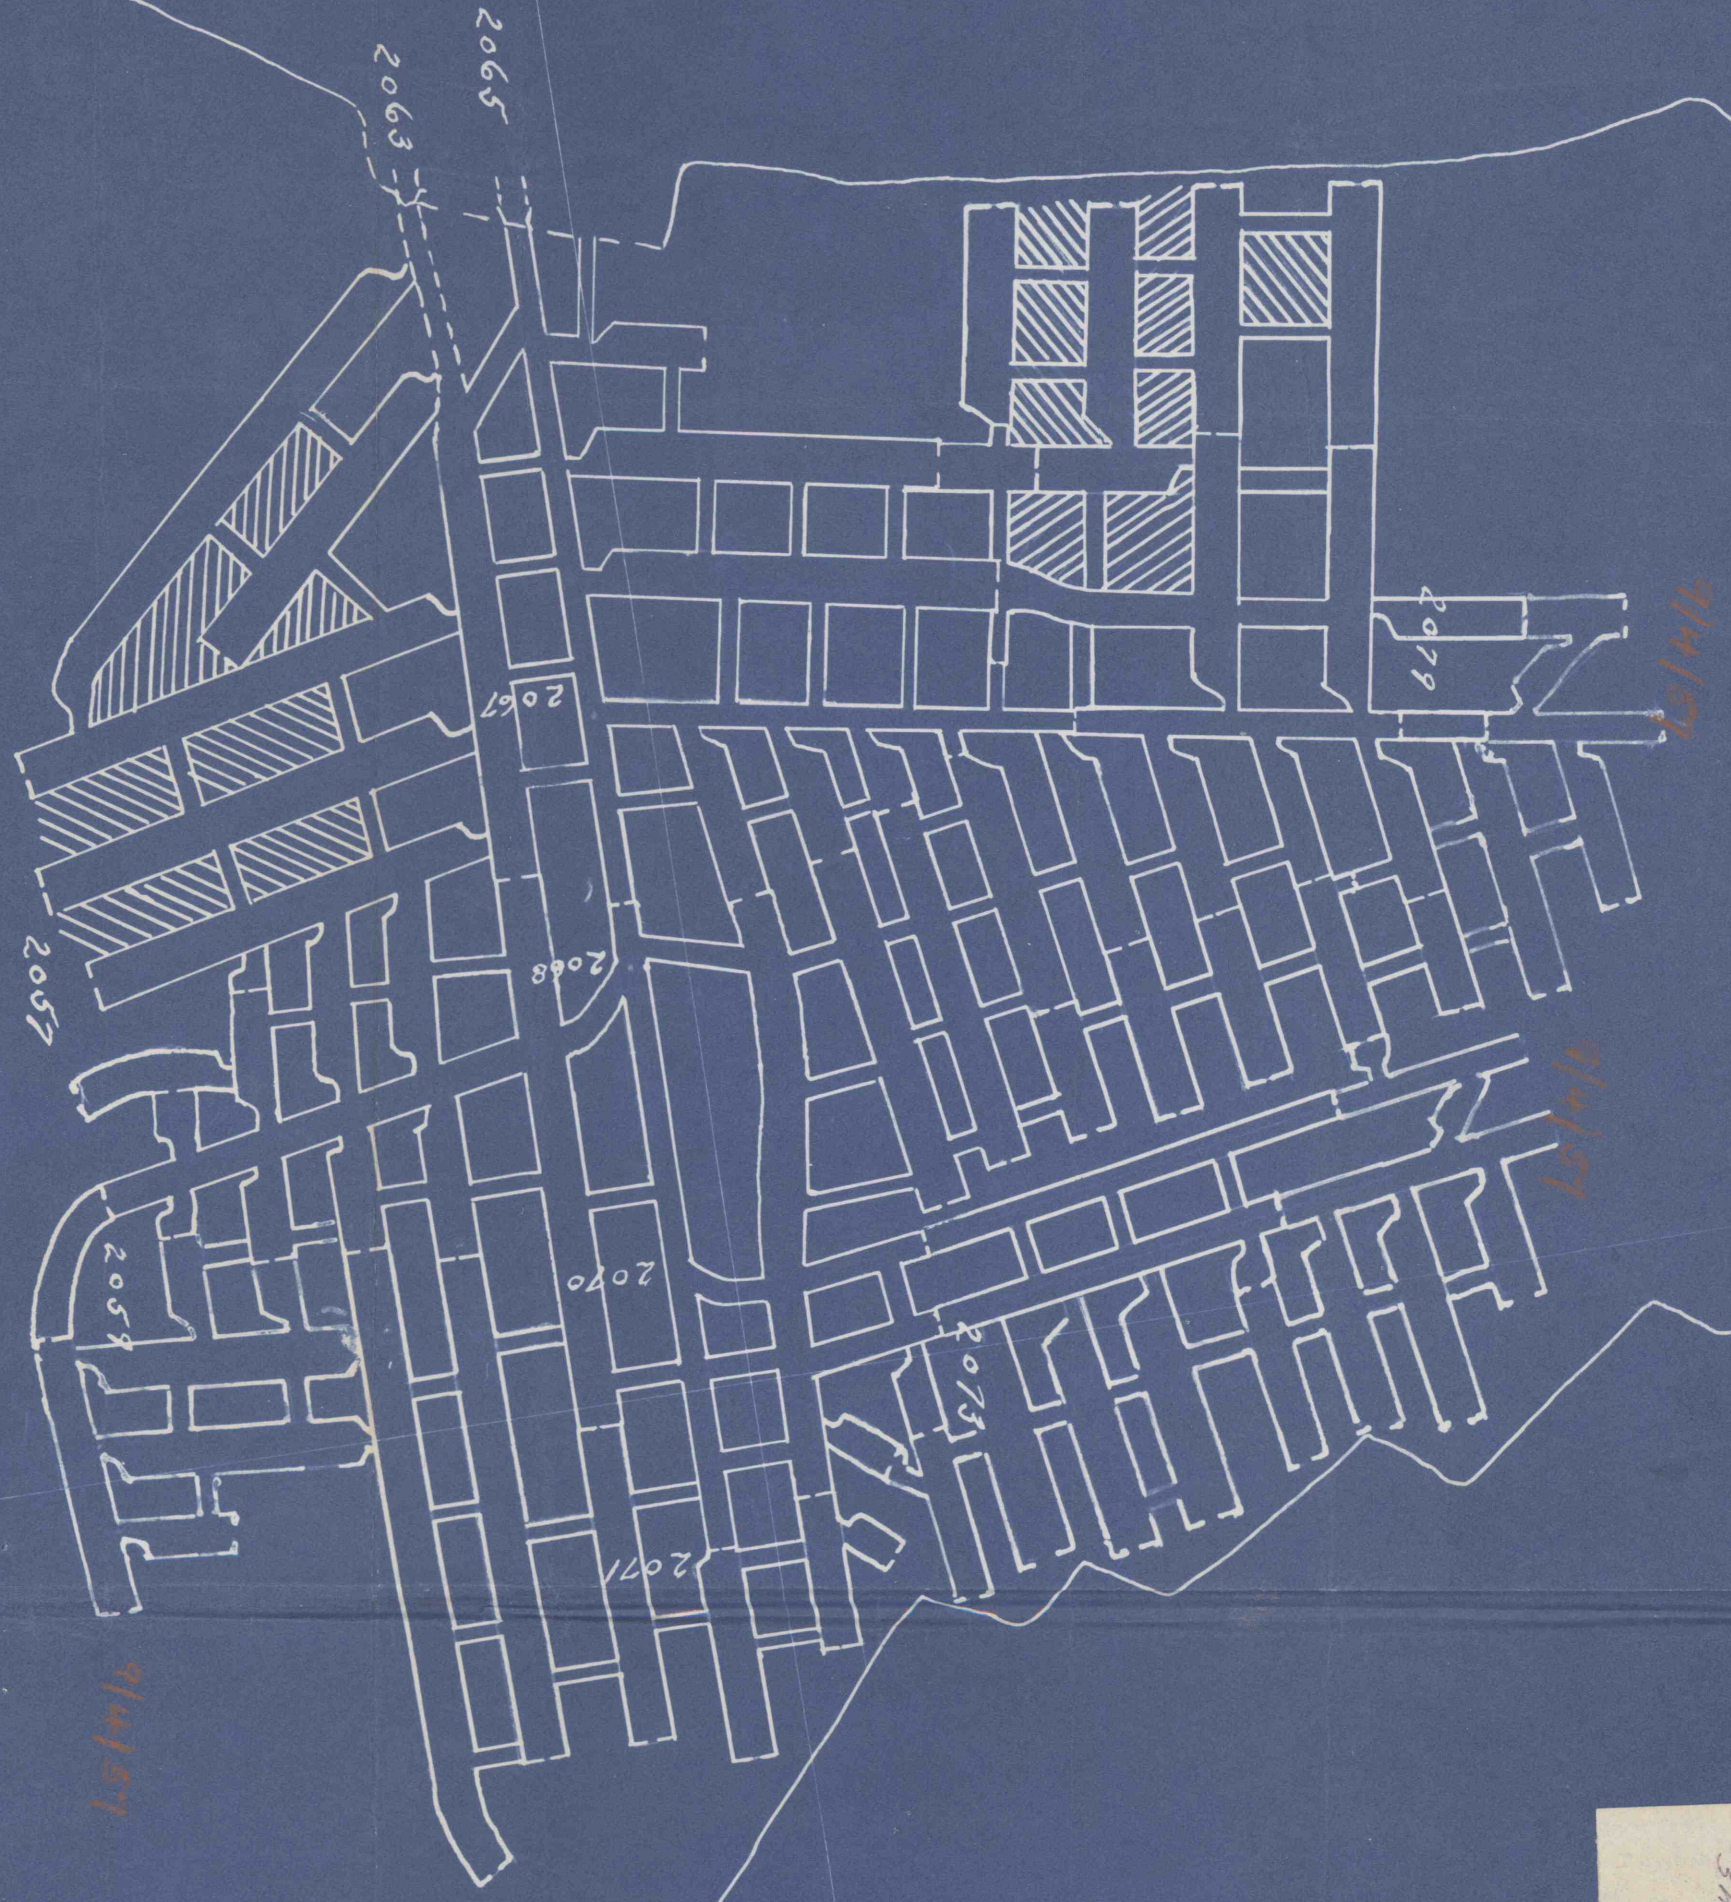

Shomo Coal Coy. Clair's E.
Shomo #4
Cambria
18-1-1958