


W.B. SKELLY COAL CO.
"A" HILL

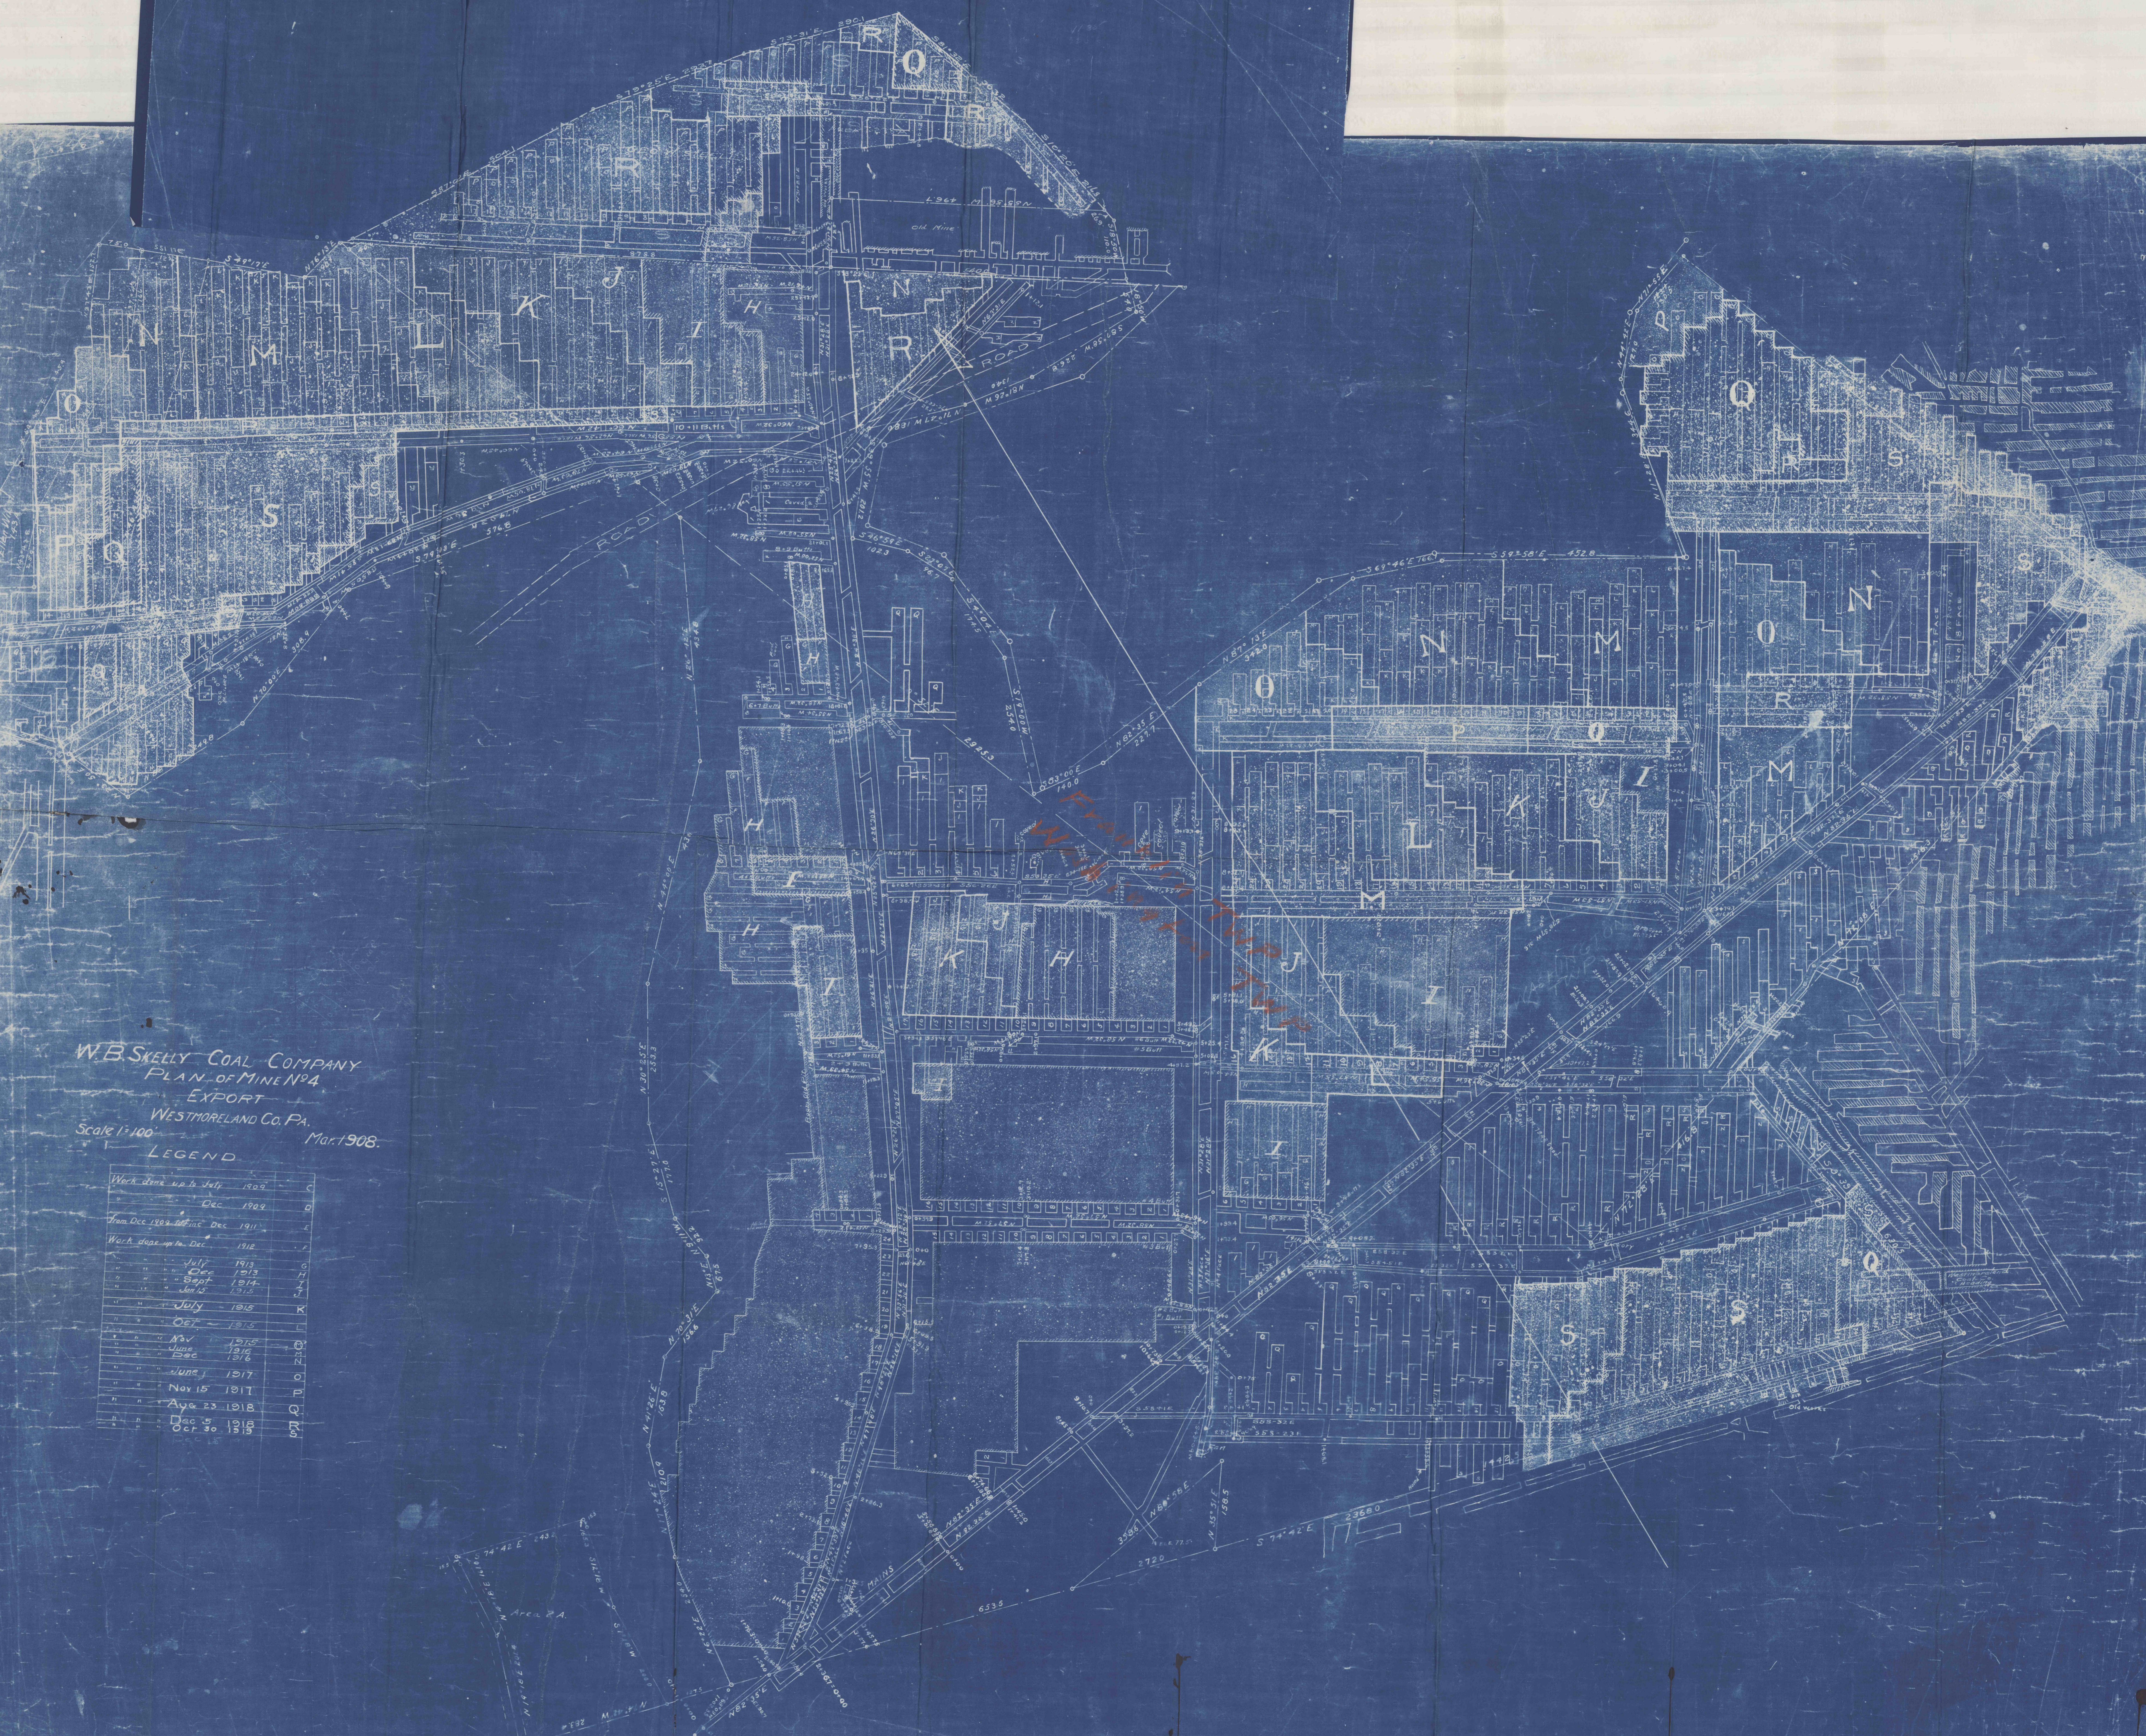

W.B. SKELLY COAL COMPANY
PLAN OF MINE NO. 94
EXPORT
WESTMORELAND CO. PA.
Scale 1"=100' Mar. 1908.

LEGEND

Work done up to July 1909	C
Dec 1909	D
From Dec 1909 to Dec 1911	E
Work done up to Dec 1912	F
July 1913	G
Dec 1913	H
Sept 1914	I
Jan 15 1915	J
July 1916	K
Oct 1916	L
Nov 1916	M
Dec 1916	N
Jan 1917	O
Feb 1917	P
Mar 1917	Q
Apr 1917	R
May 1917	S
June 1917	T
July 1917	U
Aug 1917	V
Sept 1917	W
Oct 1917	X
Nov 1917	Y
Dec 1917	Z