


WALTER SLOAN IN FEE 21,322 AC
 DALE SCOTT SURFACE 4,000 AC
 WALTER SLOAN COAL

JOHN ANDERSON ET AL.

A.V. SCOTT

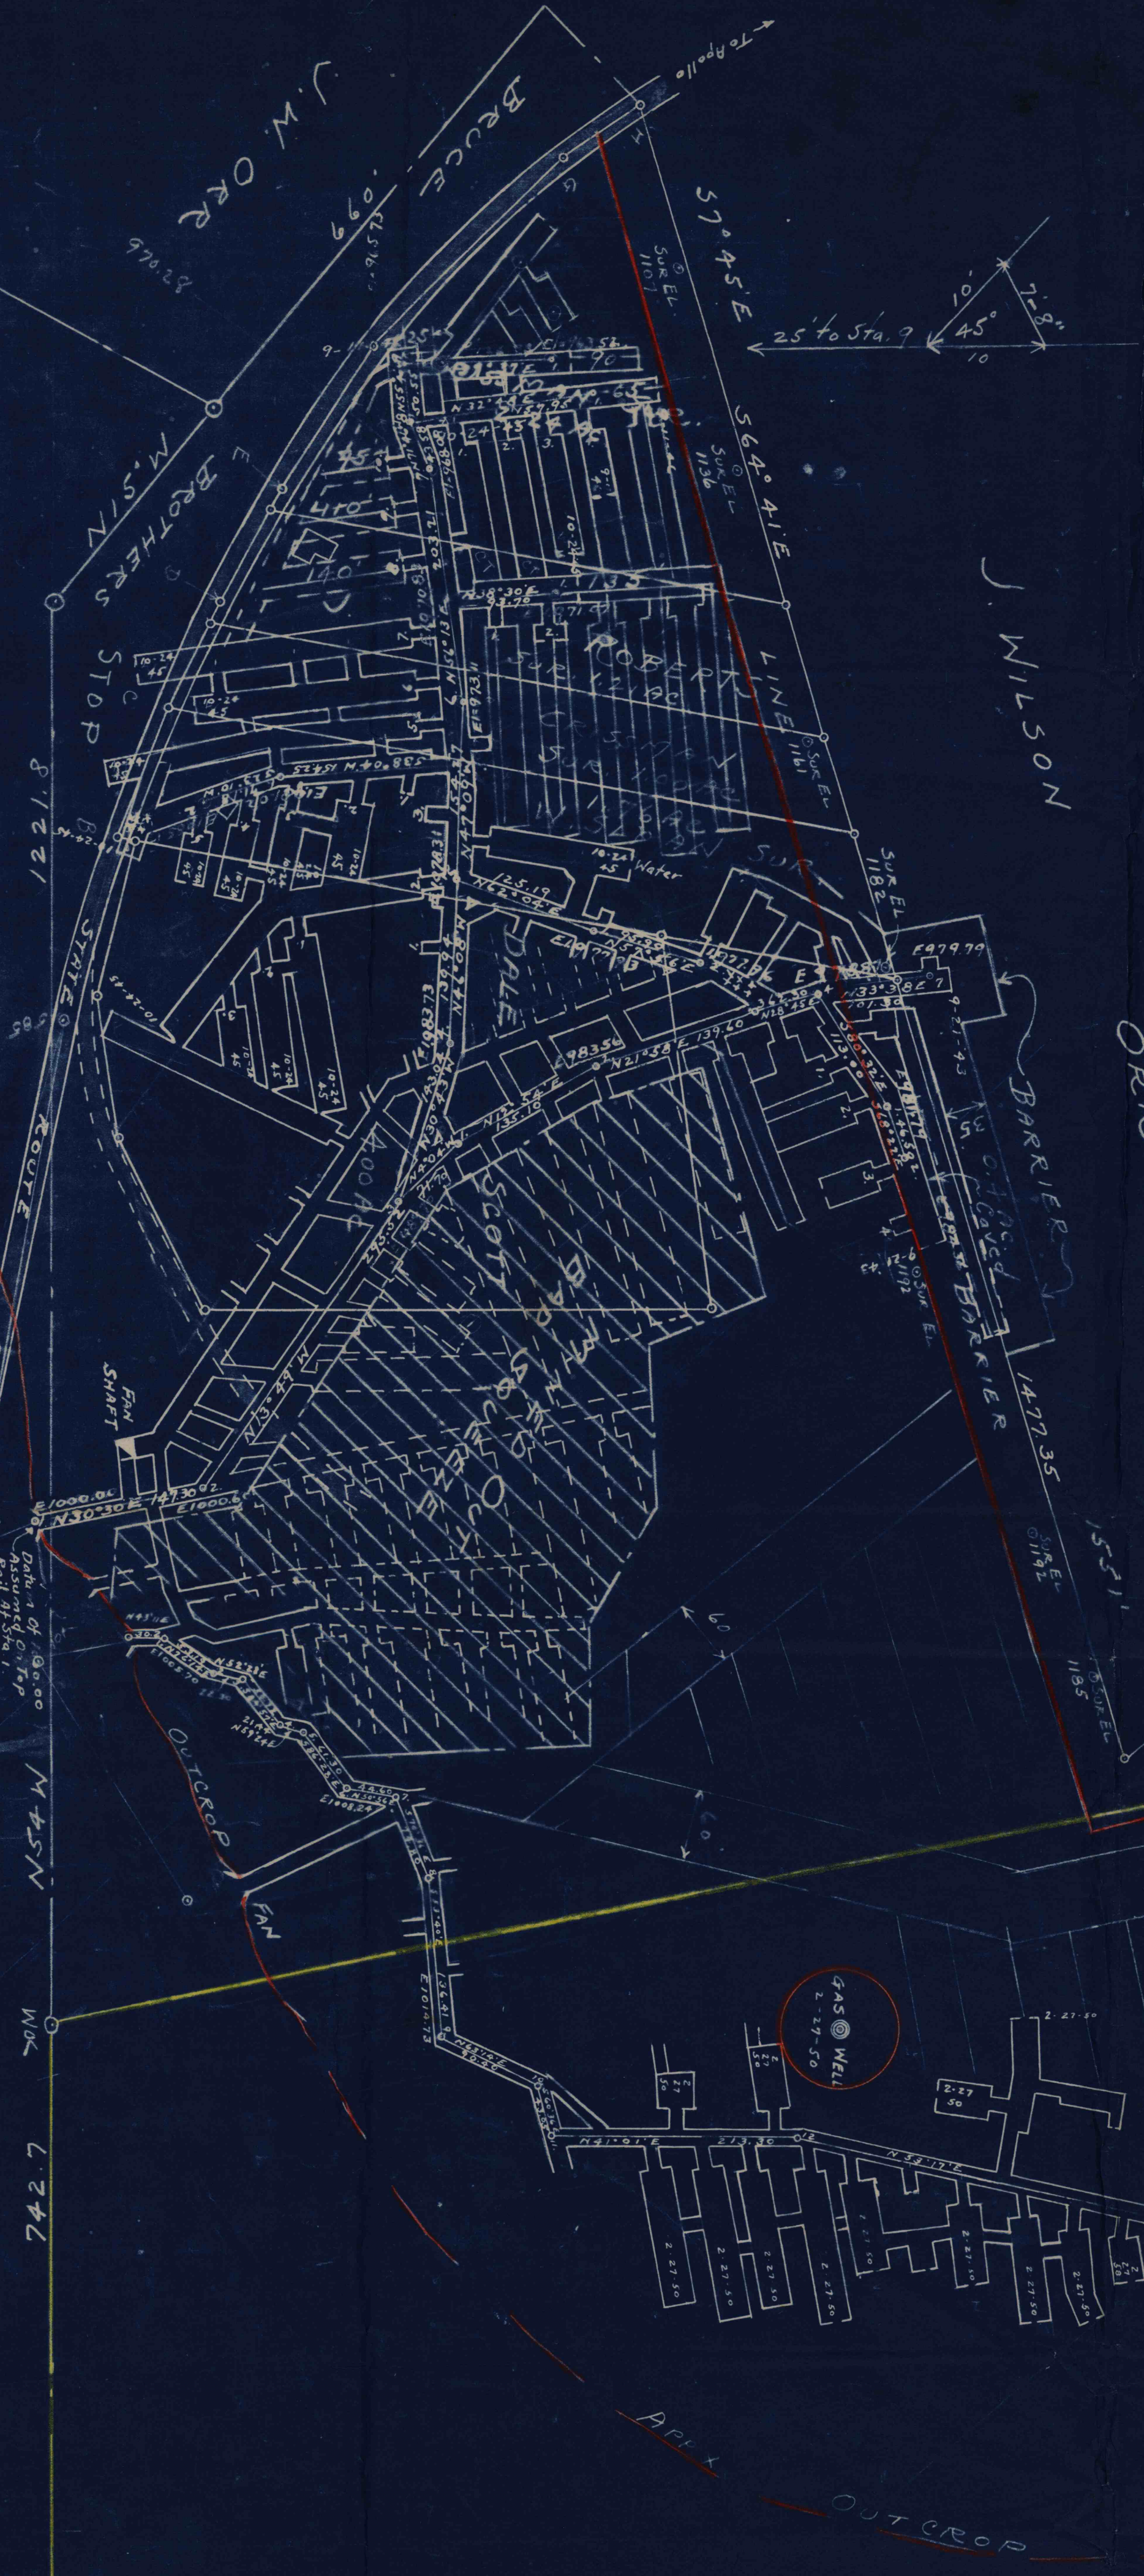

ORR



THESE TWO PROPERTY LINES & OUTCROP TO BE RUN - 2 MEAS.

WALTER SLOAN MINE & PROPERTY
 SITUATED IN
 DISMINUTAS TWP - ARMSTRONG CO. - PA.
 M. EUGENE Souders
 REG. PA. No. 3806.
 Leechburg, Pa. Oct 2-1943
 Scale 1 in. = 100 ft.

J. M. AMMENT

WALTER SLOAN SURFACE 24,322 AC
 DALE SCOTT SURFACE 4,000 AC
 WALTER SLOAN COAL

H-25-1043