


JAMES EDWARDS

TO DECKERS POINT
RT 32077
TO DECKERS POINT

Note:
Drive as hds with
Possibility of working
Conrad coal

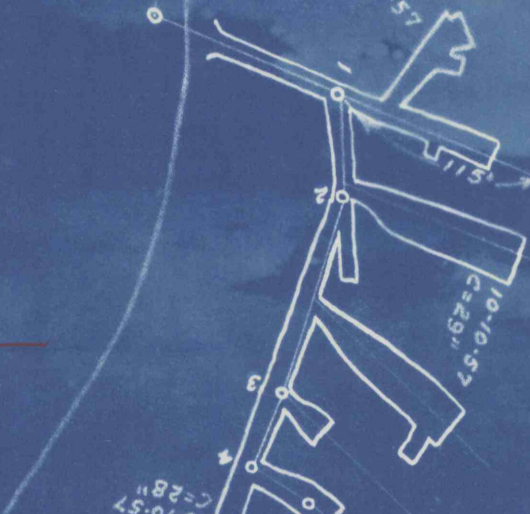

N 47° 07' W

200' Rooms

D. CONRAD

BARRIER

DRIVE ROOMS IN THIS AREA

N 17° 30' E

MAIN HDG


AIRCOURSE

OUTCROP "D" SEAM

N 54° 30' E

LEONARD MUMAU

TWP ROAD

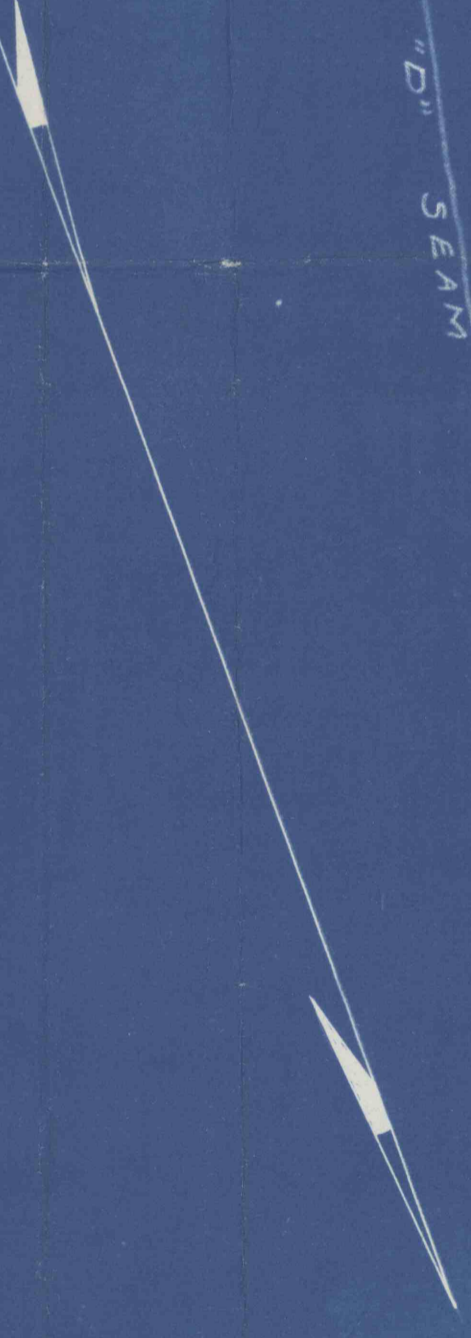

WOODSIDE

THE SMITH COAL CO MINE No. 1
RAYNE TWP INDIANA CO, PA
"D" SEAM SCALE 1" = 100'
SURVEYED OCTOBER 10, 1957
BY THOMAS HOWORTH

25