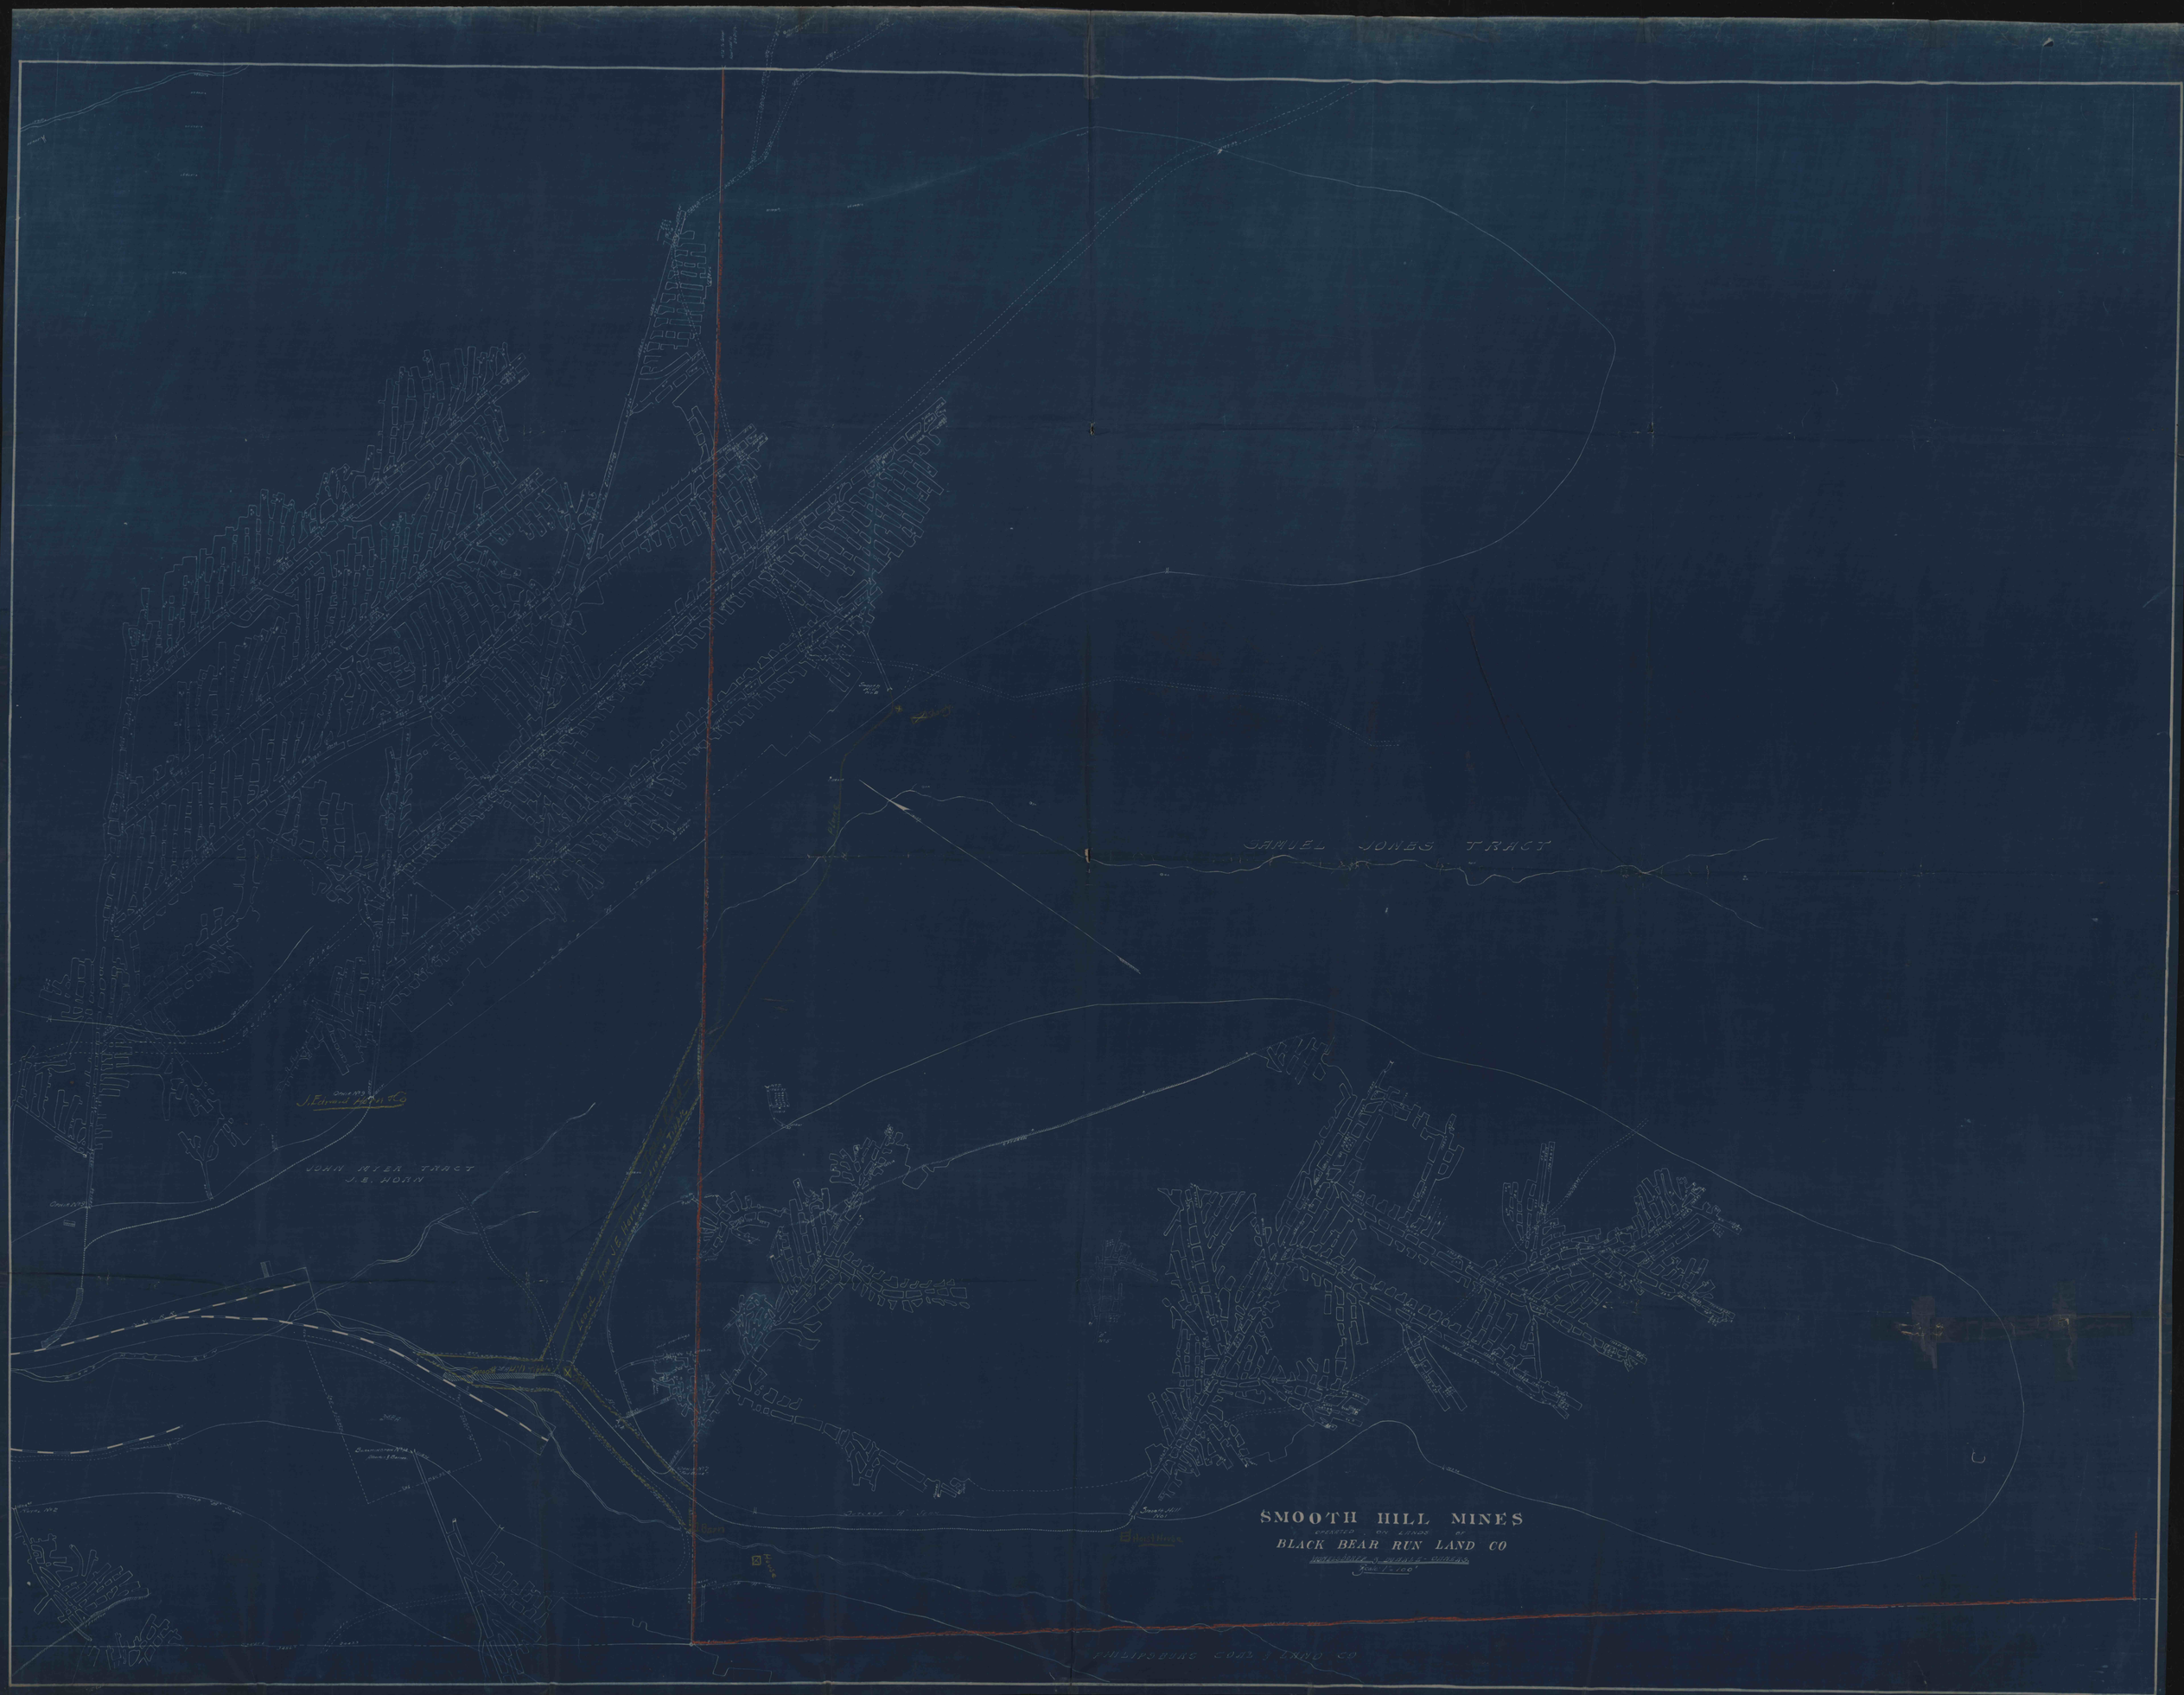
SAMUEL JONES TRACT
JOHN MYER TRACT
J.E. HORN
SMOOTH HILL MINES
OPERATED ON LANDS OF
BLACK BEAR RUN LAND CO
Scale 1" = 100'