




SAMUEL JONES TRACT

A SEAM
 MAP OF
SMOOTH HILL NO 2
 OPERATED BY THE
SMOOTH HILL COAL CO
 ON LANDS OF THE
BLACK BEAR RUN LAND CO
 Scale: 1 inch = 100 Feet. G. F. Dunnic, Mining Engineer
 1927

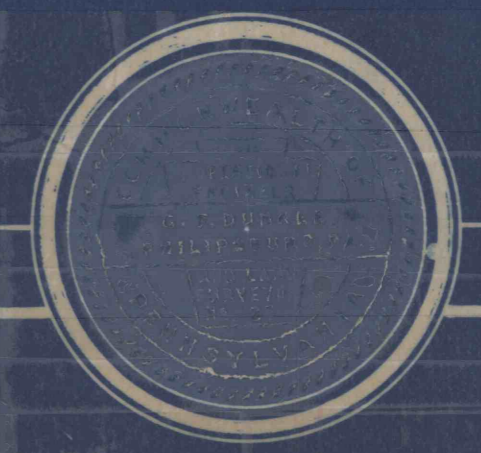

Map No. 11
 11/11/27
 10/27/27