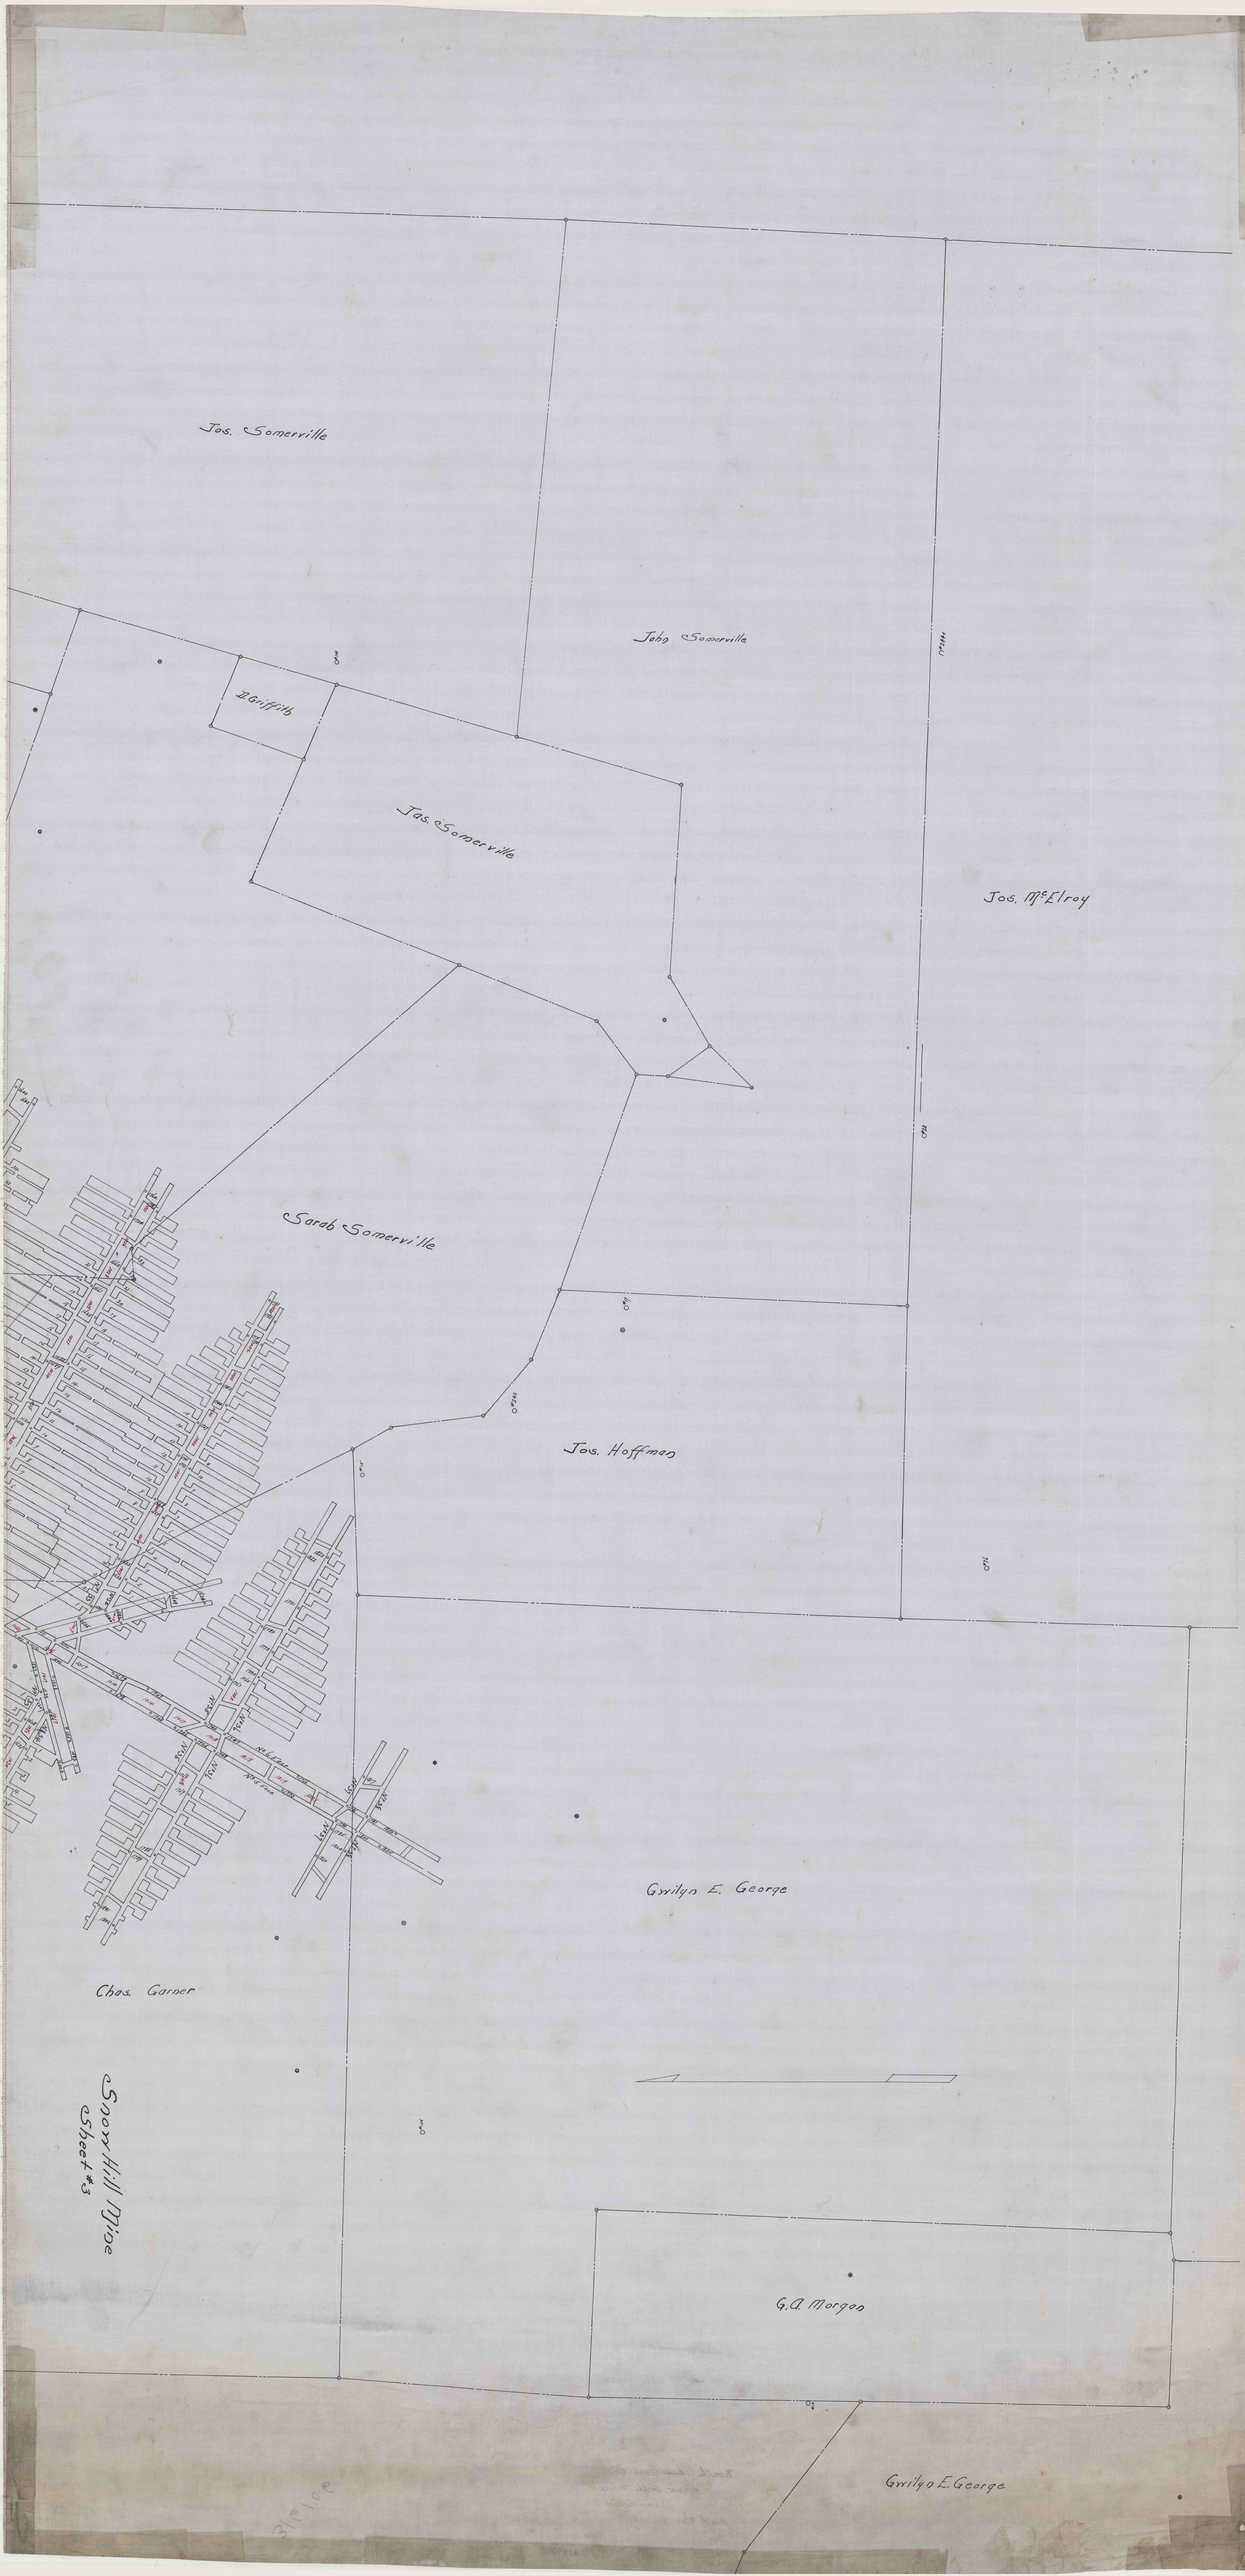
Jas. Somerville
John Somerville
W. Griffith
Jas. Somerville
Jas. McElroy
Sarah Somerville
Jas. Hoffman
Gwilyn E. George
Chas. Garner
Sheet #3
G.A. Morgan
Gwilyn E. George