


TRACT NO. 1067
 WILMORE COAL CO. - MIN.
 WILMORE COAL CO. - SURF.

TRACT NO. 1068
 WILMORE COAL CO. - MIN.
 THERESA M. WALKER - SURF.

THERESA M. WALKER
 BARN
 RESERVATION

RUSSEL M. PILE ETAL. MIN. SURF.
 THERESA M. WALKER SURF.

RUSSEL M. PILE ETAL. MINERAL
 DENISE COAL CO. SURFACE

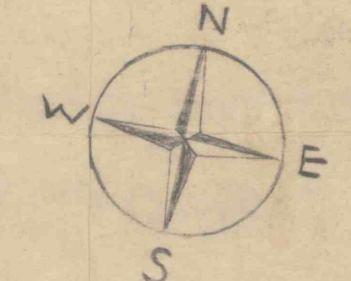


OLD WORKINGS

STRIKE N57°00'E
 MAX. DIP 14°

STATE HIGHWAY ROUTE No. 31
 1 MI.

HIGH WALL

PORTAL
 MINE NO. 18
 MINE WATER TREATMENT PLANT I.P.O.
 SETTLING PONDS
 BACK FILLING
 DIVERSION DITCH
 FENCE
 HIGH WALL STRIP CUT
 UNNAMED STREAM TO GLADES RUN

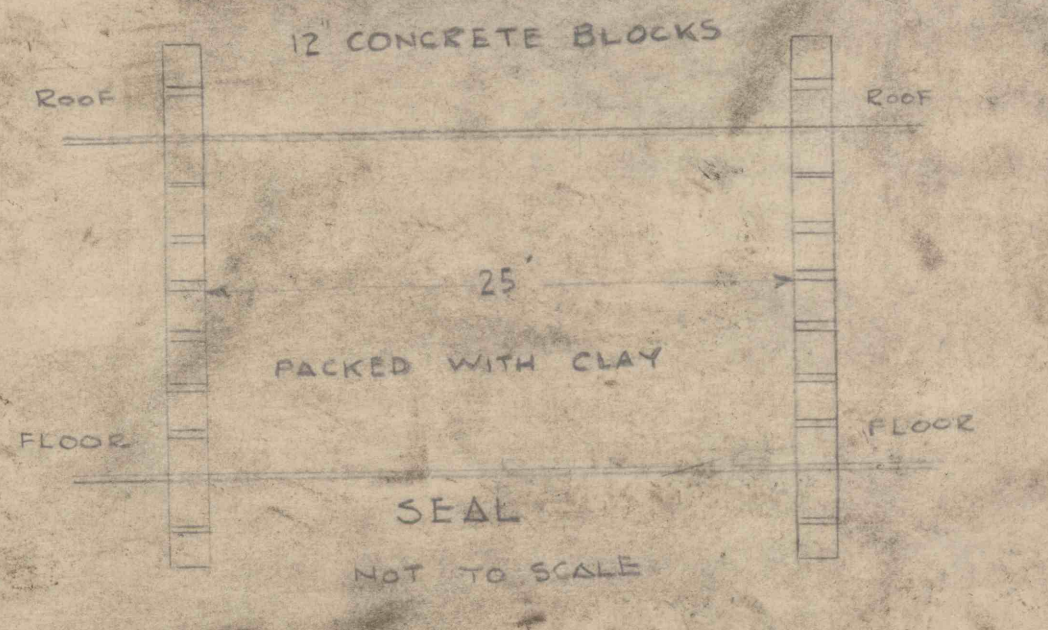

LEGEND

- #865 PROPERTY LINE
- #846 MINING COMPLETED
- #864 6 MONTHS ADVANCE 8-1-69 to 2-1-70

EVERETT SNYDER
 MINE NO. 18
 LOWER FREEPORT SEAM
 STONYCREEK TWP SOMERSET CO.
 SCALE 1"=100' SEPT 13, 1967
 V. E. ERICKSON RPE #7074
 APRIL 18, 1972

