22.90
18.00
4.08
57.90
37.50
93.40
18.00
113.40
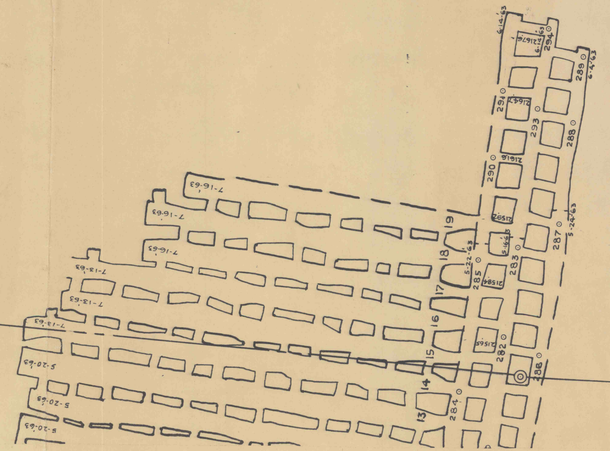
175.68
113.40
62.28