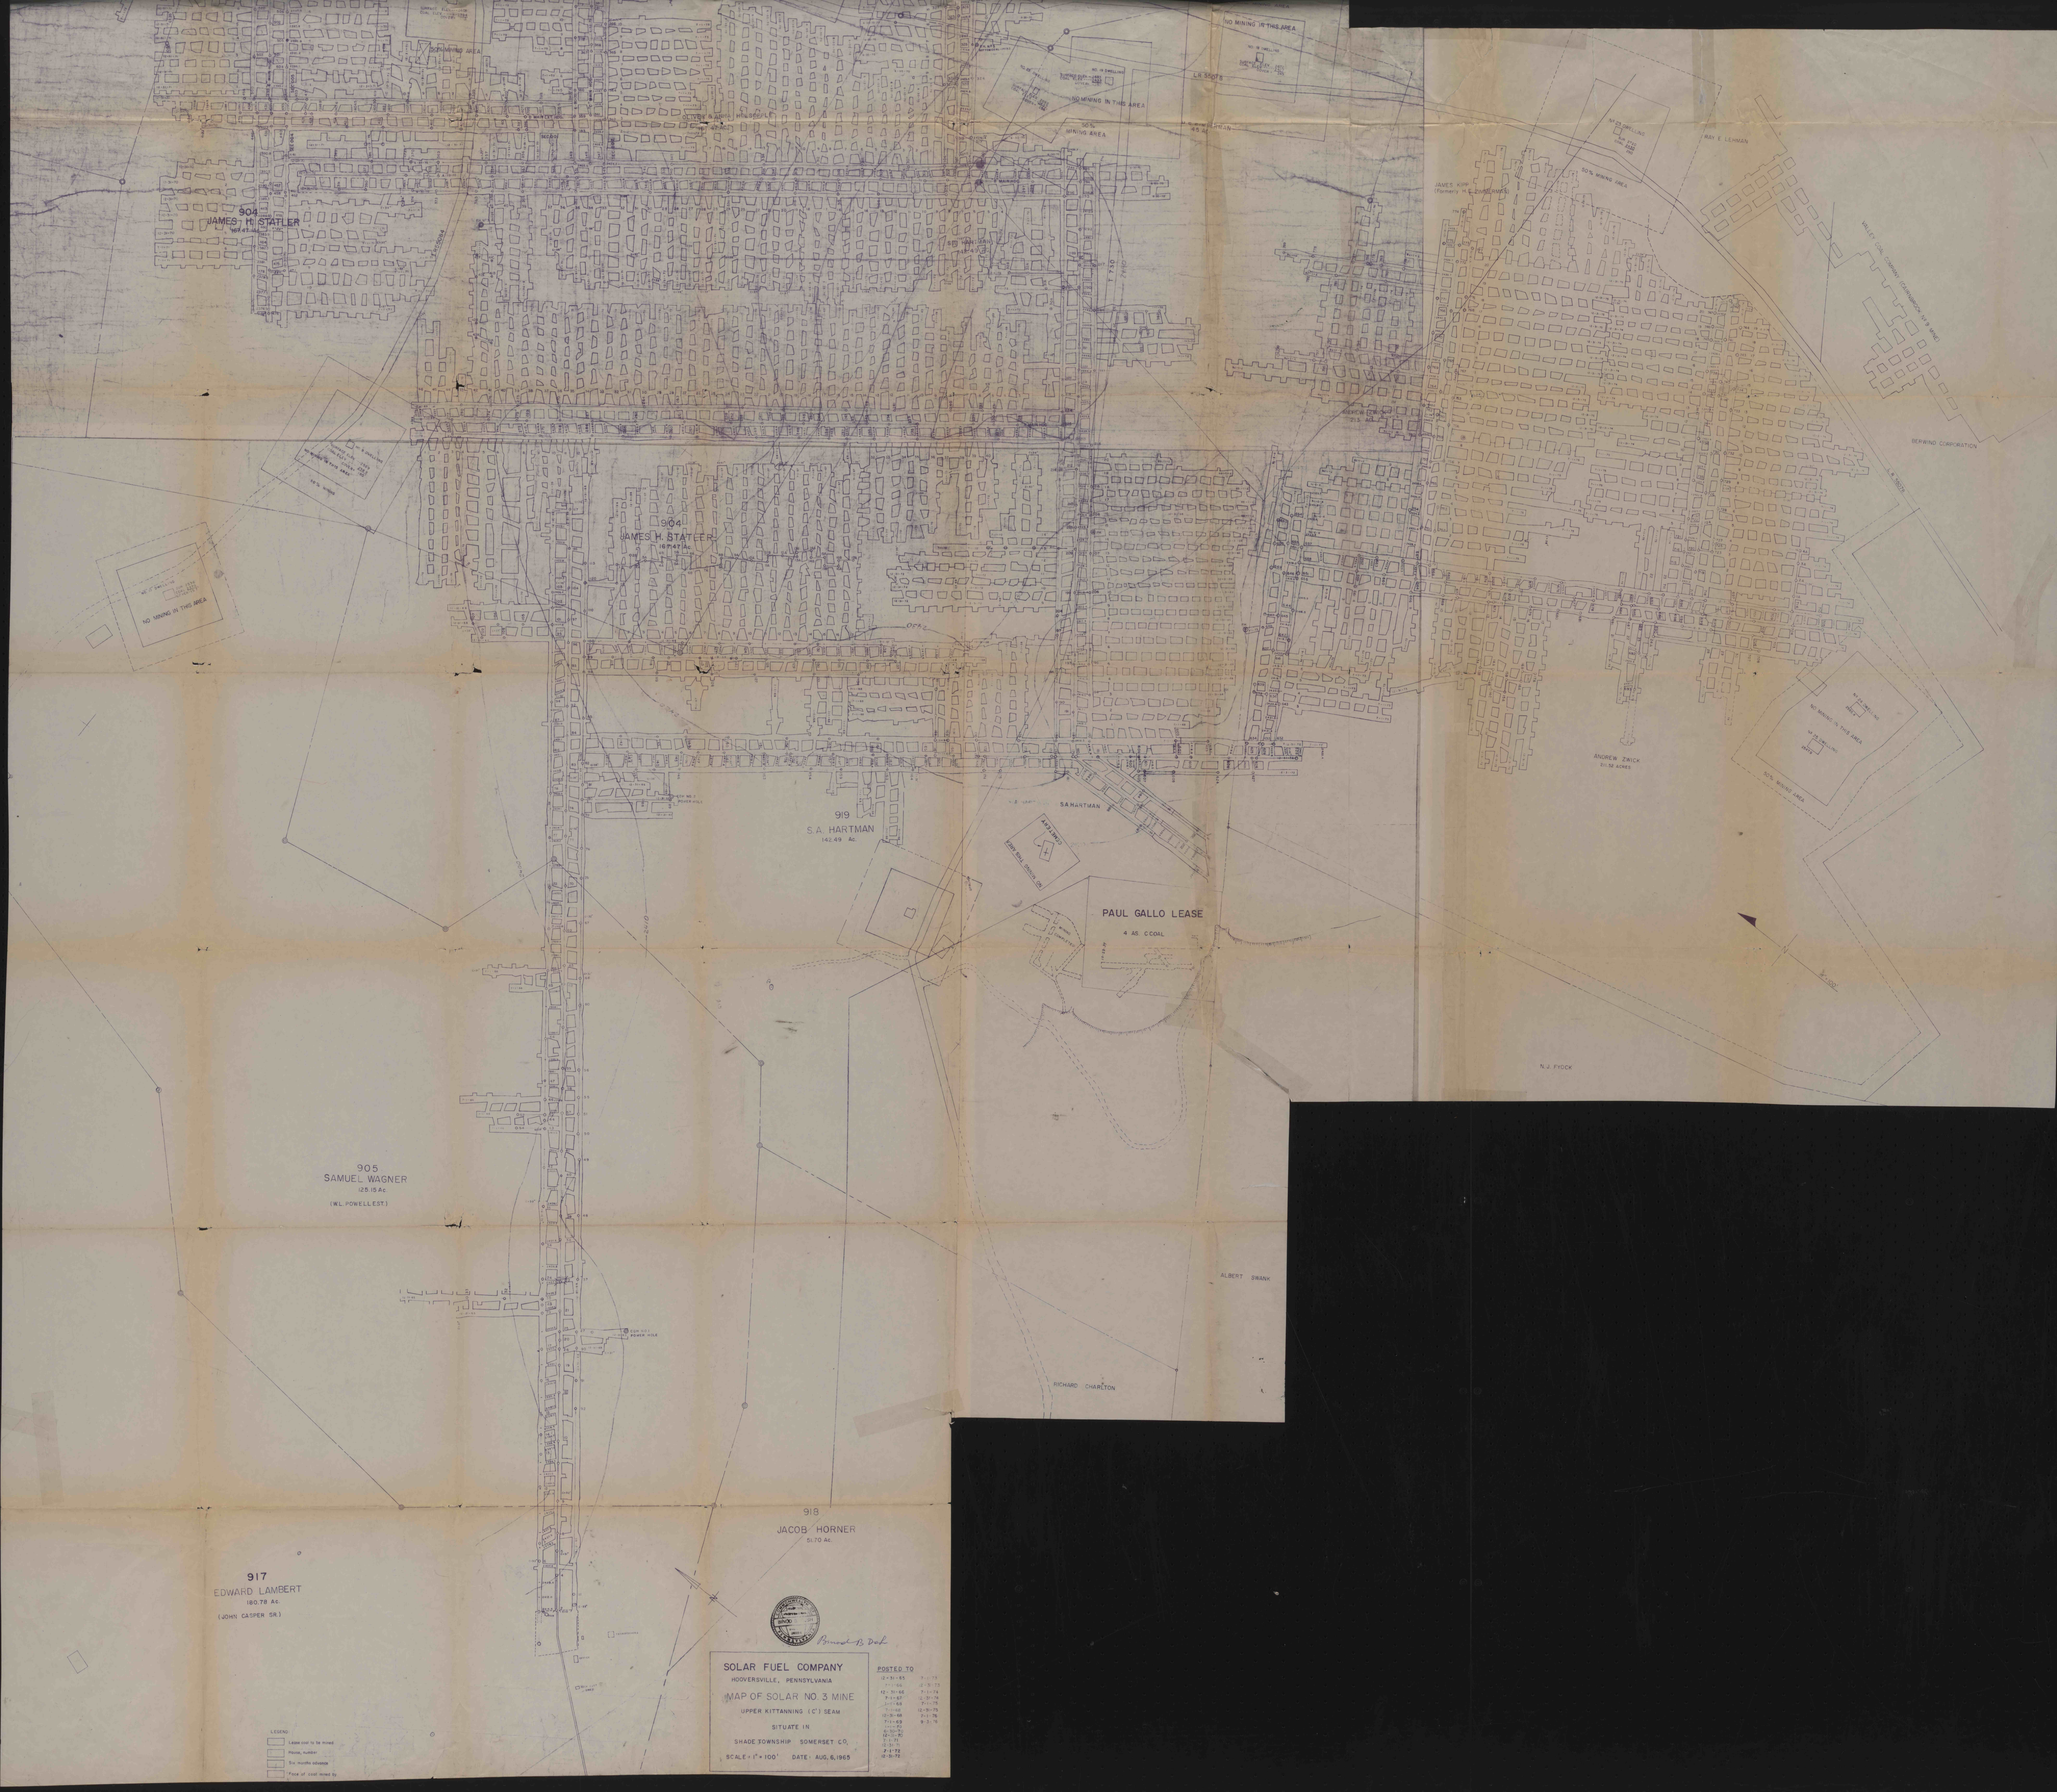
904
JAMES H. STATLER
167.47 Ac.
OLIVER & ANNA HOLSOPPLE
S.A. HARTMAN
142.49 Ac.
NO MINING IN THIS AREA
50% MINING AREA
NO. 19 DWELLING
LR 55078
LR 55084
T 730
8 MAIN HDG.
ANDREW ZWICK
213 AC.
JAMES KIPP
(Formerly H.E. ZIMMERMAN)
Nº 23 DWELLING
RAY E. LEHMAN
VALLEY COAL COMPANY (CAIRNBROOK Nº 9 MINE)
BERWIND CORPORATION
L.R. 55078
Nº 24 DWELLING
Nº 25 DWELLING
ANDREW ZWICK
211.52 ACRES
919
S.A. HARTMAN
142.49 Ac.
SA HARTMAN
CEMETERY
NO MINING THIS AREA
PAUL GALLO LEASE
4 AS. C COAL
MINING COMPLETED
N.J. FYOCK
1" = 100'
ALBERT SWANK
RICHARD CHARLTON
CDH NO. 2 POWER HOLE
CDH NO. 1 POWER HOLE
905
SAMUEL WAGNER
125.15 Ac.
(W.L. POWELL EST.)
918
JACOB HORNER
51.70 Ac.
917
EDWARD LAMBERT
180.78 Ac.
(JOHN CASPER SR.)
LEGEND:
Lease coal to be mined
House, number
Six months advance
Face of coal mined by
Binod B. Dash
SOLAR FUEL COMPANY
HOOVERSVILLE, PENNSYLVANIA
MAP OF SOLAR NO. 3 MINE
UPPER KITTANNING (C') SEAM
SITUATE IN
SHADE TOWNSHIP SOMERSET CO.
SCALE: 1" = 100' DATE: AUG. 6, 1965
POSTED TO
12-31-65
7-1-66
12-31-66
7-1-67
1-1-68
7-1-68
12-31-68
7-1-69
1-1-70
6-30-70
12-31-70
7-1-71
12-31-71
7-1-72
12-31-72
7-1-73
12-31-73
7-1-74
12-31-74
7-1-75
12-31-75
7-1-76
9-3-76