

DAVID ST CLAIR

DANIEL KALTENBAUGH

NEAL MC VICKER

JAY MILLER

PROPOSED SEAL LOCATIONS

FINAL MAP

SOLAR No 5A MINE

UPPER FREEPORT - E SEAM
JENNER TOWNSHIP - SOMERSET CO.

SOLAR FUEL COMPANY
A GULF + WESTERN COMPANY
BOX 488
SOMERSET, PENNA. 15501

SCALE: 1" = 100'
DATE:
DWN. BY: ED - ENG. DEPT.
DWG. NO: 5A-1



REVISIONS:

SOLAR FUEL CO

SOLAR No 5

BACKFILLED STRIP AREA

LIMIT OF MINING AS ESTABLISHED BY O.E.R. PERMIT
NO MINING BEYOND 2025 COAL CONTOUR

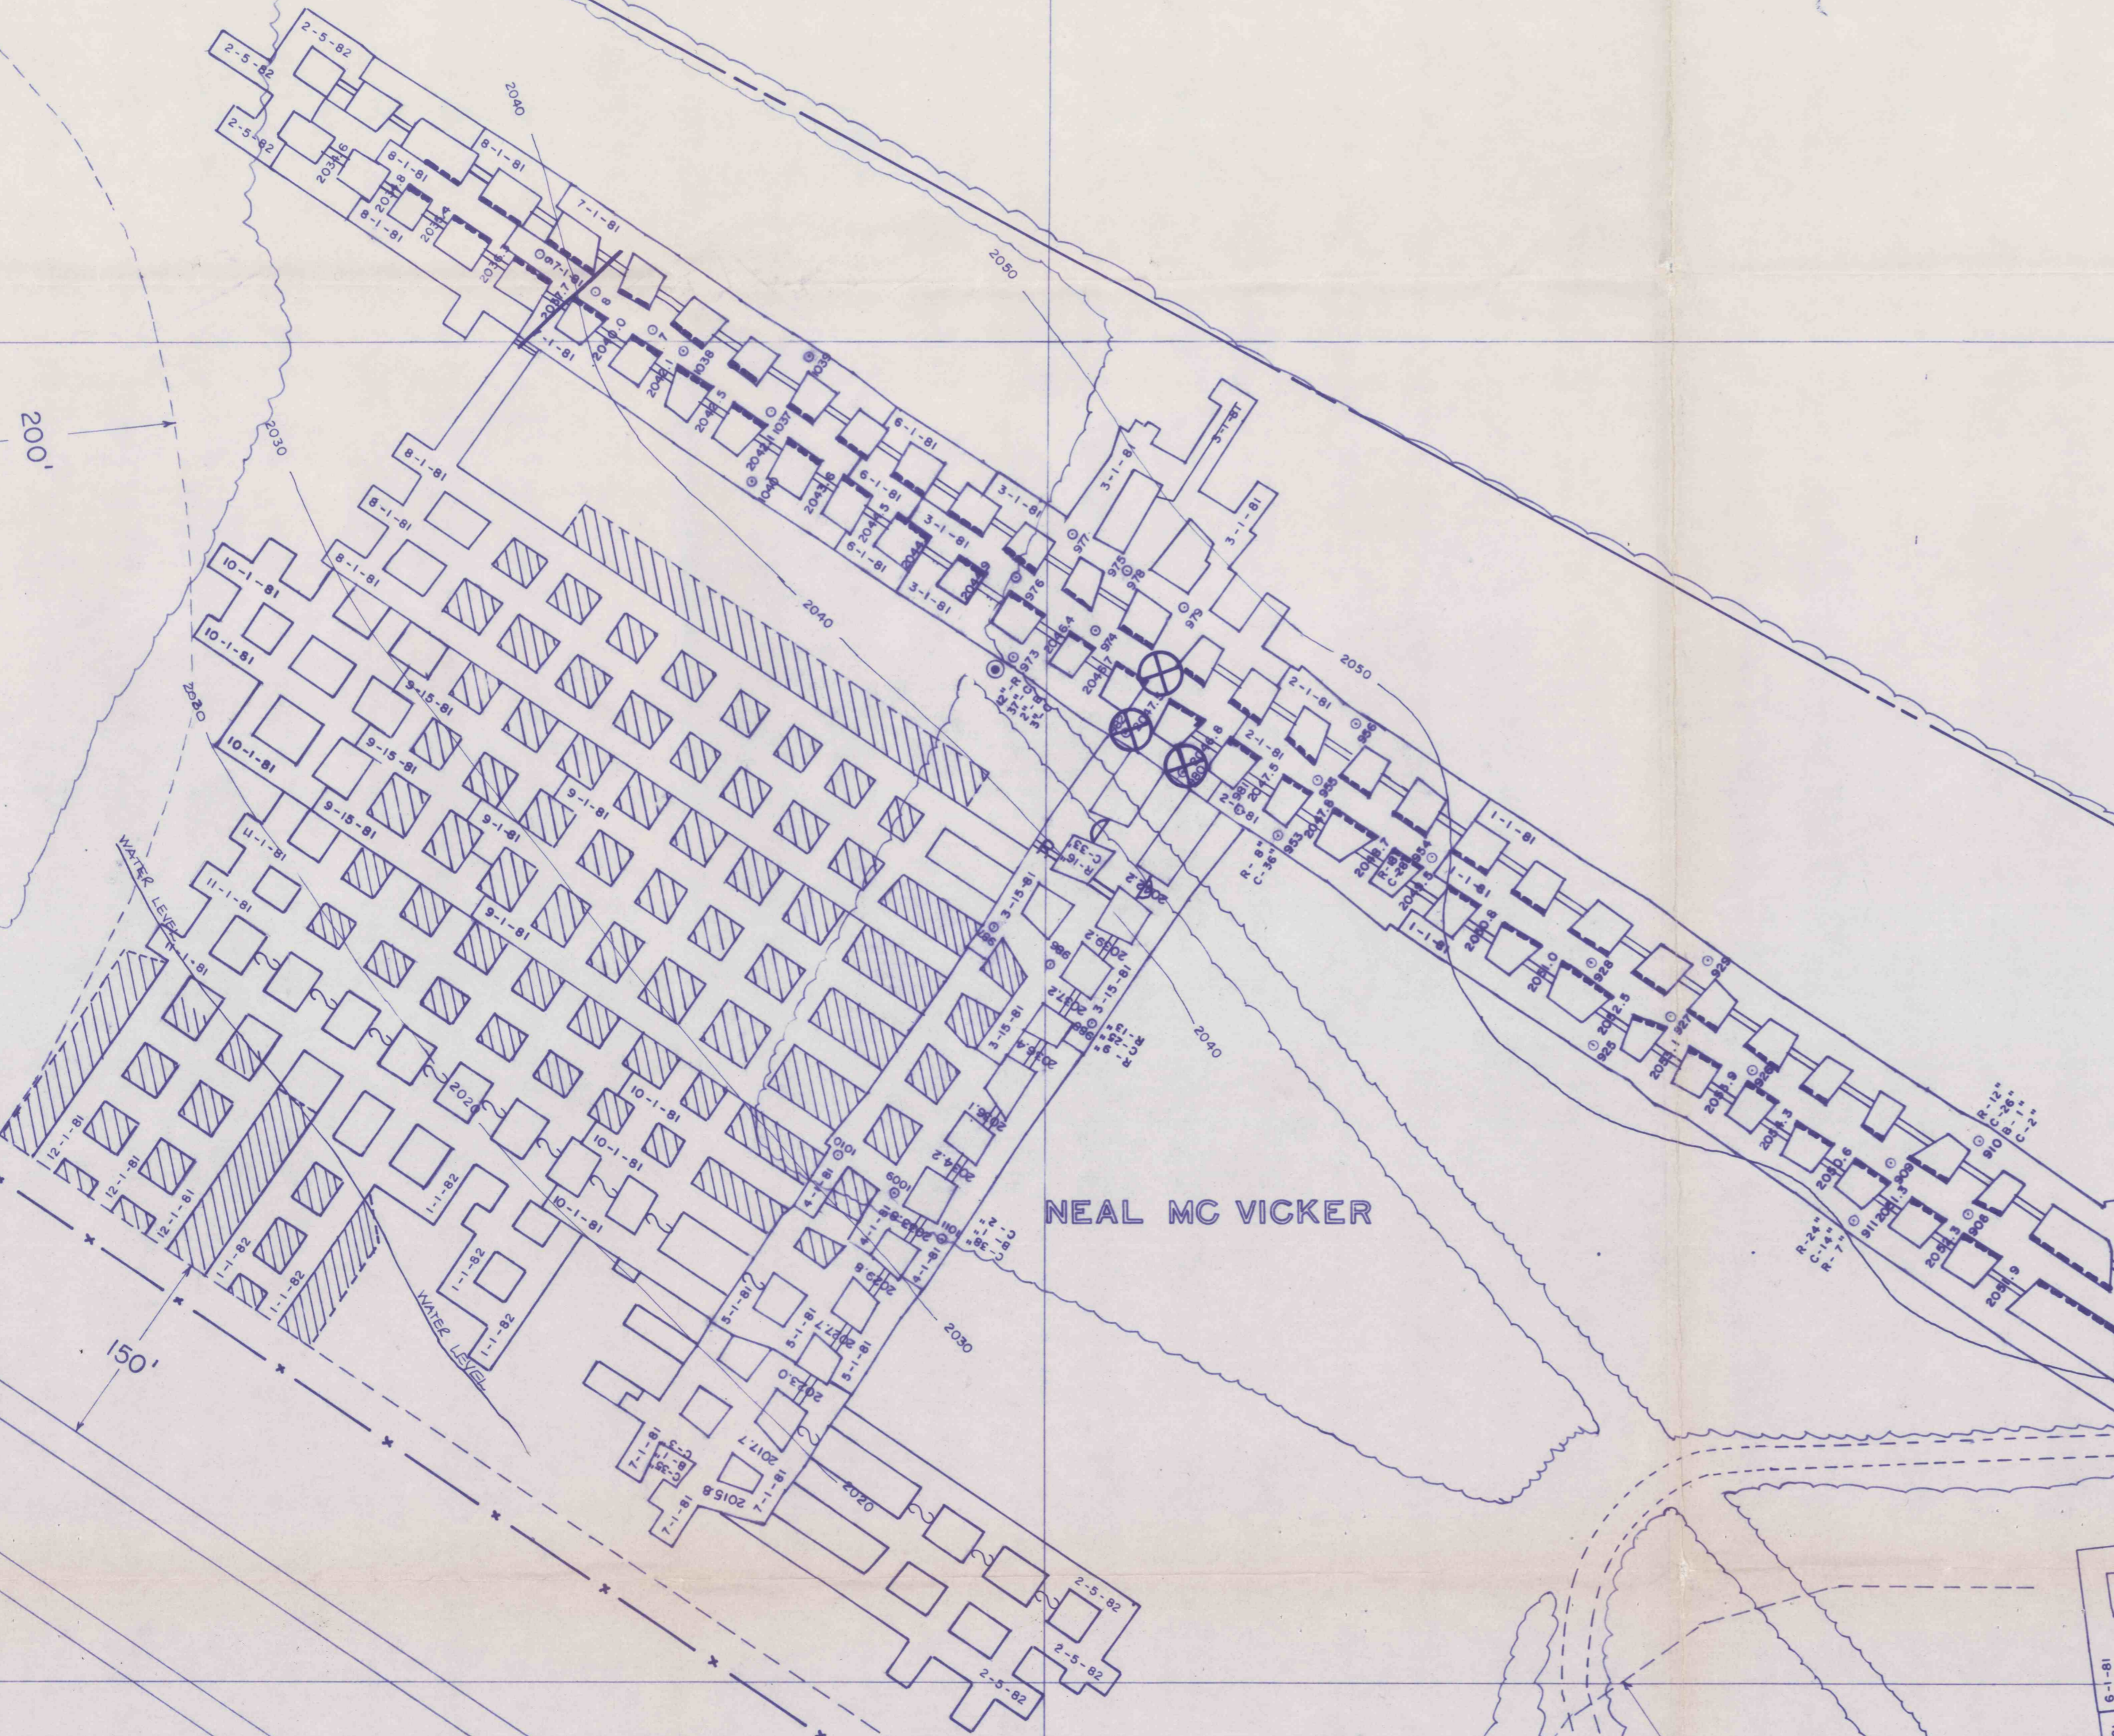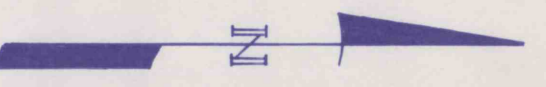

ELEV. BENCHMARK
AXLE SFC 102
N - 284,935.74
E - 1,643,943.78

BASE LINE POINTS Δ101 & 102
AXLE SFC 101
N - 285,000.62
E - 1,644,111.37
AXLE SFC 103
N - 284,935.74
E - 1,643,943.78

I.P. SFC 100
B-32
ELEV. 2085.09

I.P. SFC 104

I.P. SFC 105

I.P. SFC 106

I.P. SFC 103

200'

200'

200'

200'

200'

150'

150'

200'

ROUTE 102 - 219 SOUTH
219 NORTH

OPEN ABANDONED STRIP PIT

SPOIL PILE

TREATMENT FACILITIES

OFFICE WASH HOUSE

SHOP

BIN