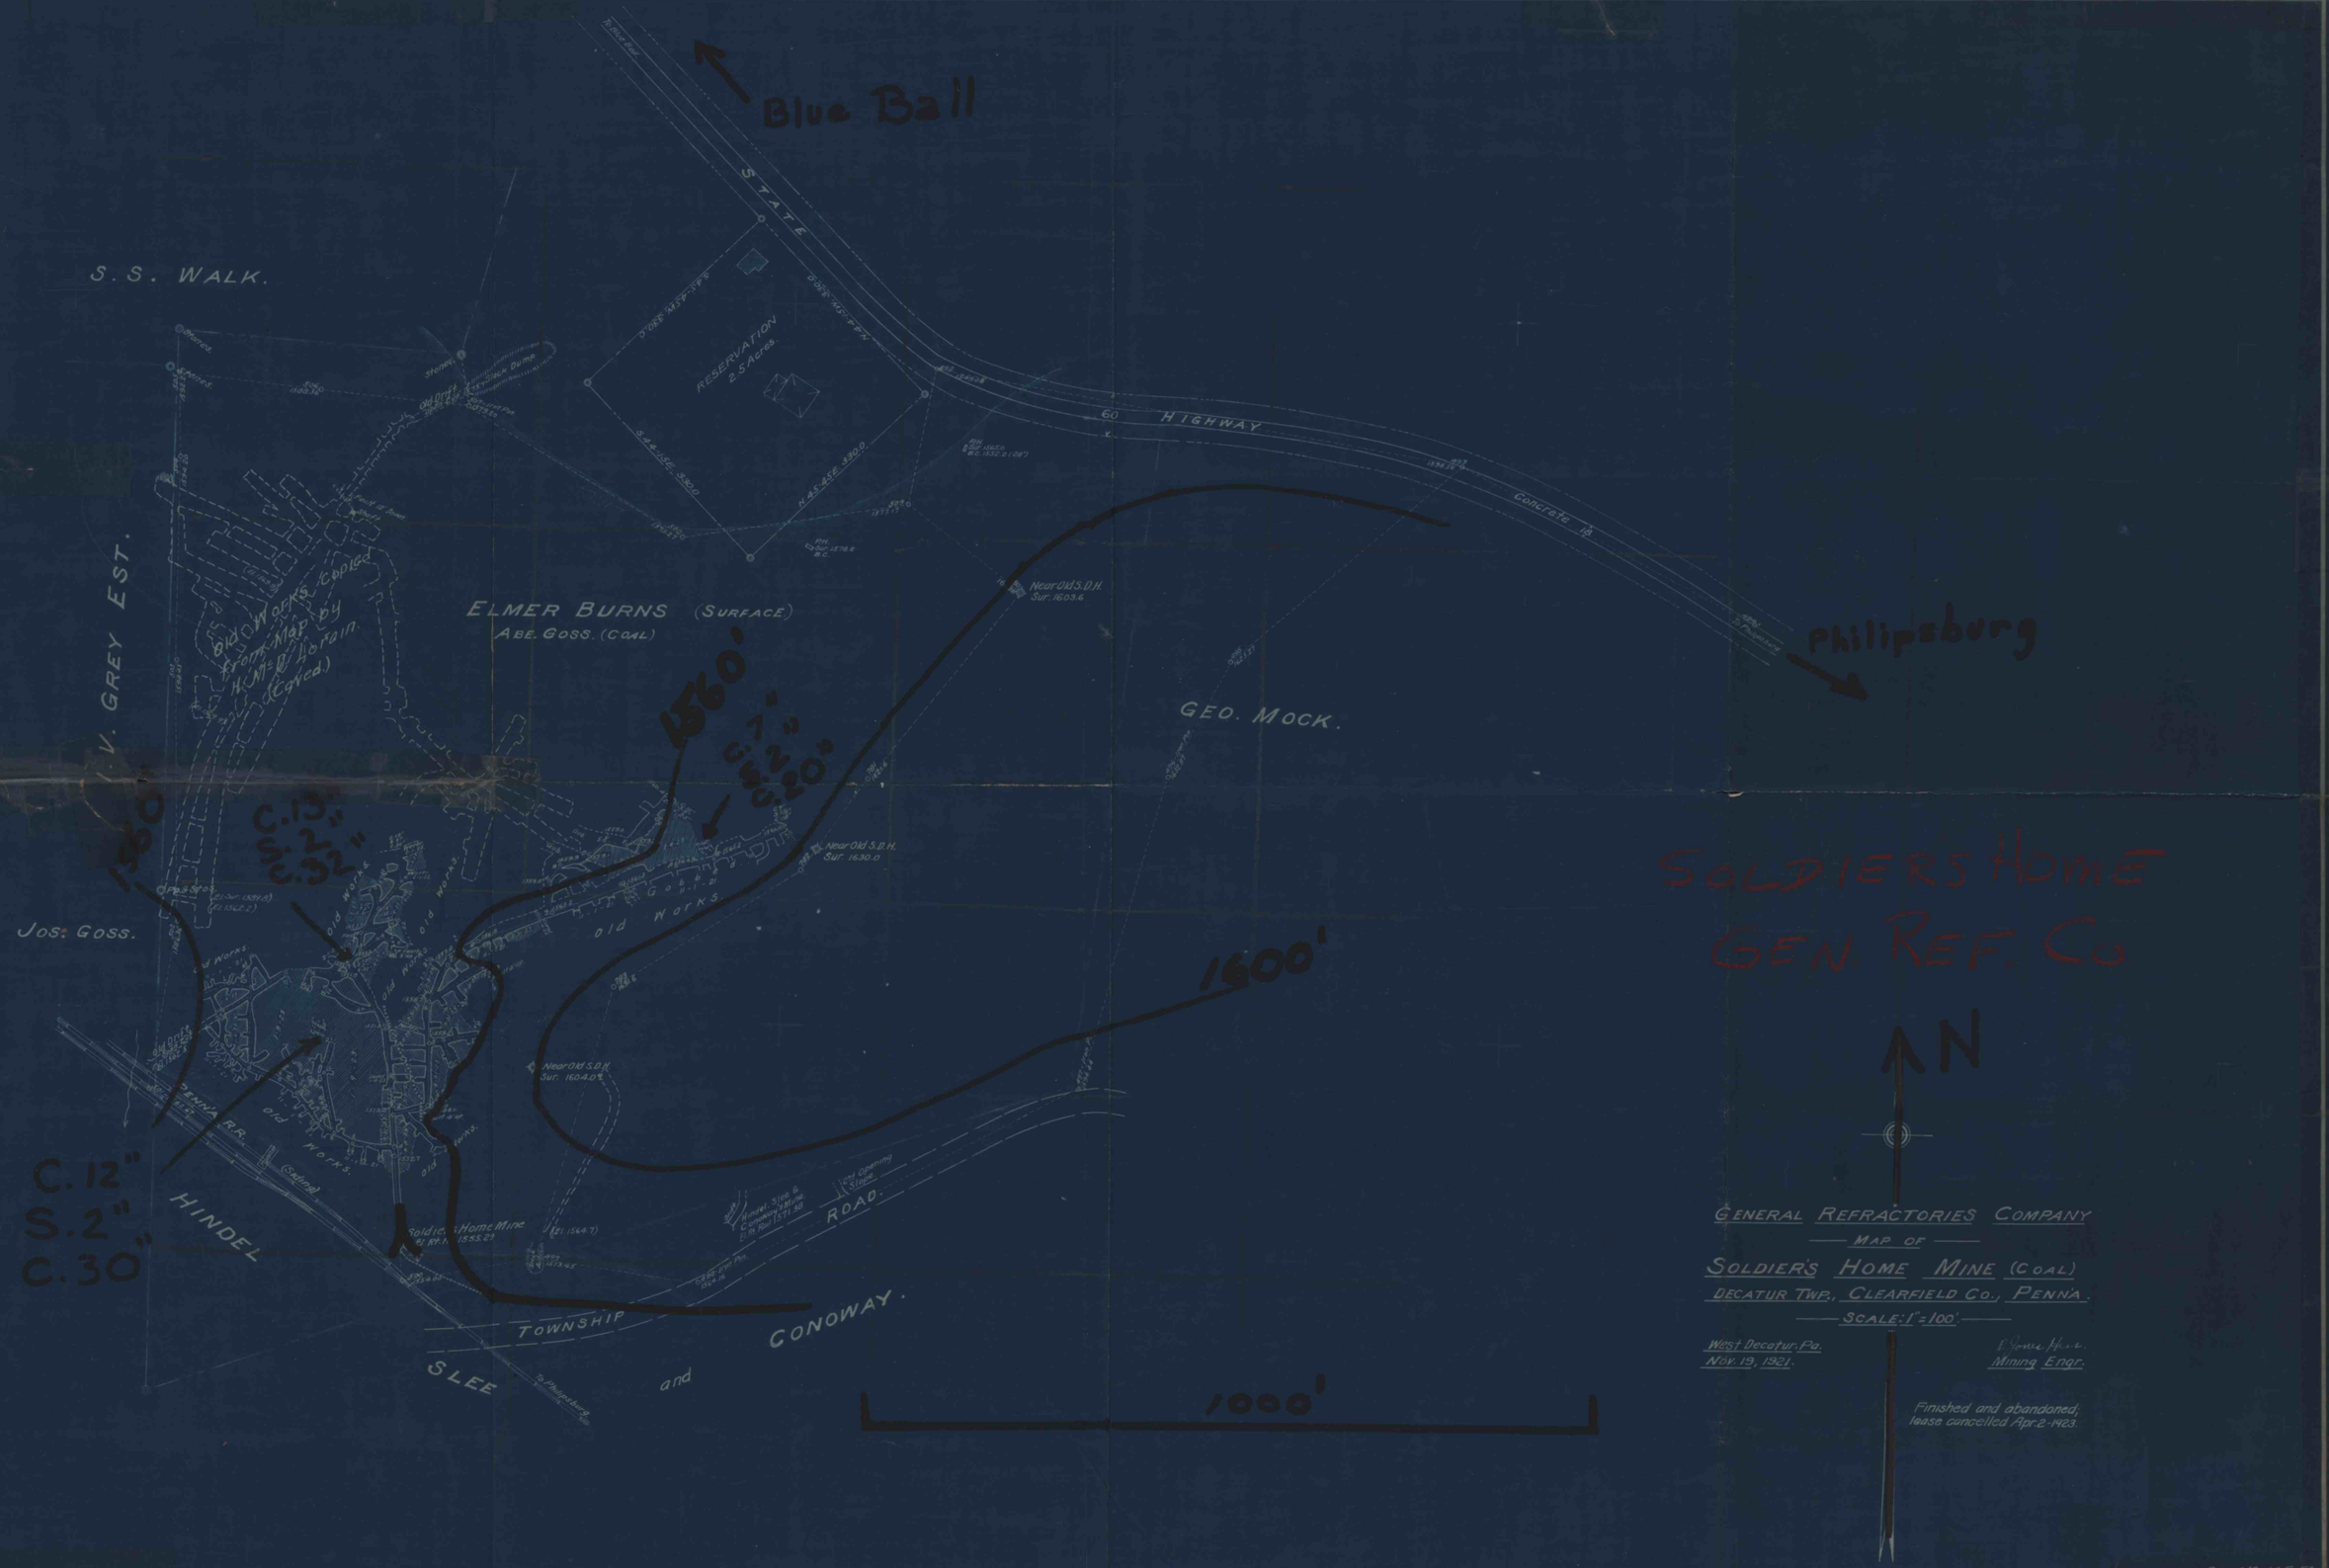
Blue Ball
STATE
HIGHWAY
60
Concrete 18
Philipsburg
S. S. WALK.
RESERVATION
2.5 Acres
ELMER BURNS (SURFACE)
ABE. GOSS. (COAL)
Old Works copied from Map by H. McD. Horain. (Caved.)
V. GREY EST.
GEO. MOCK.
Near Old S.D.H.
Sur. 1603.6
1560'
C.7"
S.2"
C.30"
1560'
C.13"
S.2"
C.32"
Near Old S.D.H.
Sur. 1630.0
Old Works
Jos: Goss.
1600'
Near Old S.D.H.
Sur. 1604.0
C.12"
S.2"
C.30"
HINDEL
PENNA. R.R.
Old Works
Soldiers Home Mine
TOWNSHIP
ROAD.
SLEE
and
CONOWAY.
1000'
SOLDIERS HOME
GEN. REF. CO
N
GENERAL REFRACTORIES COMPANY
MAP OF
SOLDIER'S HOME MINE (COAL)
DECATUR TWP., CLEARFIELD CO., PENNA.
SCALE: 1" = 100'
West Decatur, Pa.
Nov. 19, 1921.
Mining Engr.
Finished and abandoned;
lease cancelled Apr. 2-1923.
Drg. No 165-F1